

CERTIFIED LAND CORNER RESTORATION

Index No. **1 N 9**


State of Wisconsin }
County of Forest } ss.

I Philip T. Hansen, do hereby certify that on the 20th day of January, 19 76, I found evidence of the Section corner of 16-17-20-21 Township 36, North, Range 14 East, Fourth Principal Meridian, as described hereon; and that from this evidence I established a new monument and accessories as described hereon to perpetuate the original location of this corner.


Resident witnesses:

Glen Barker

Jim Claflin

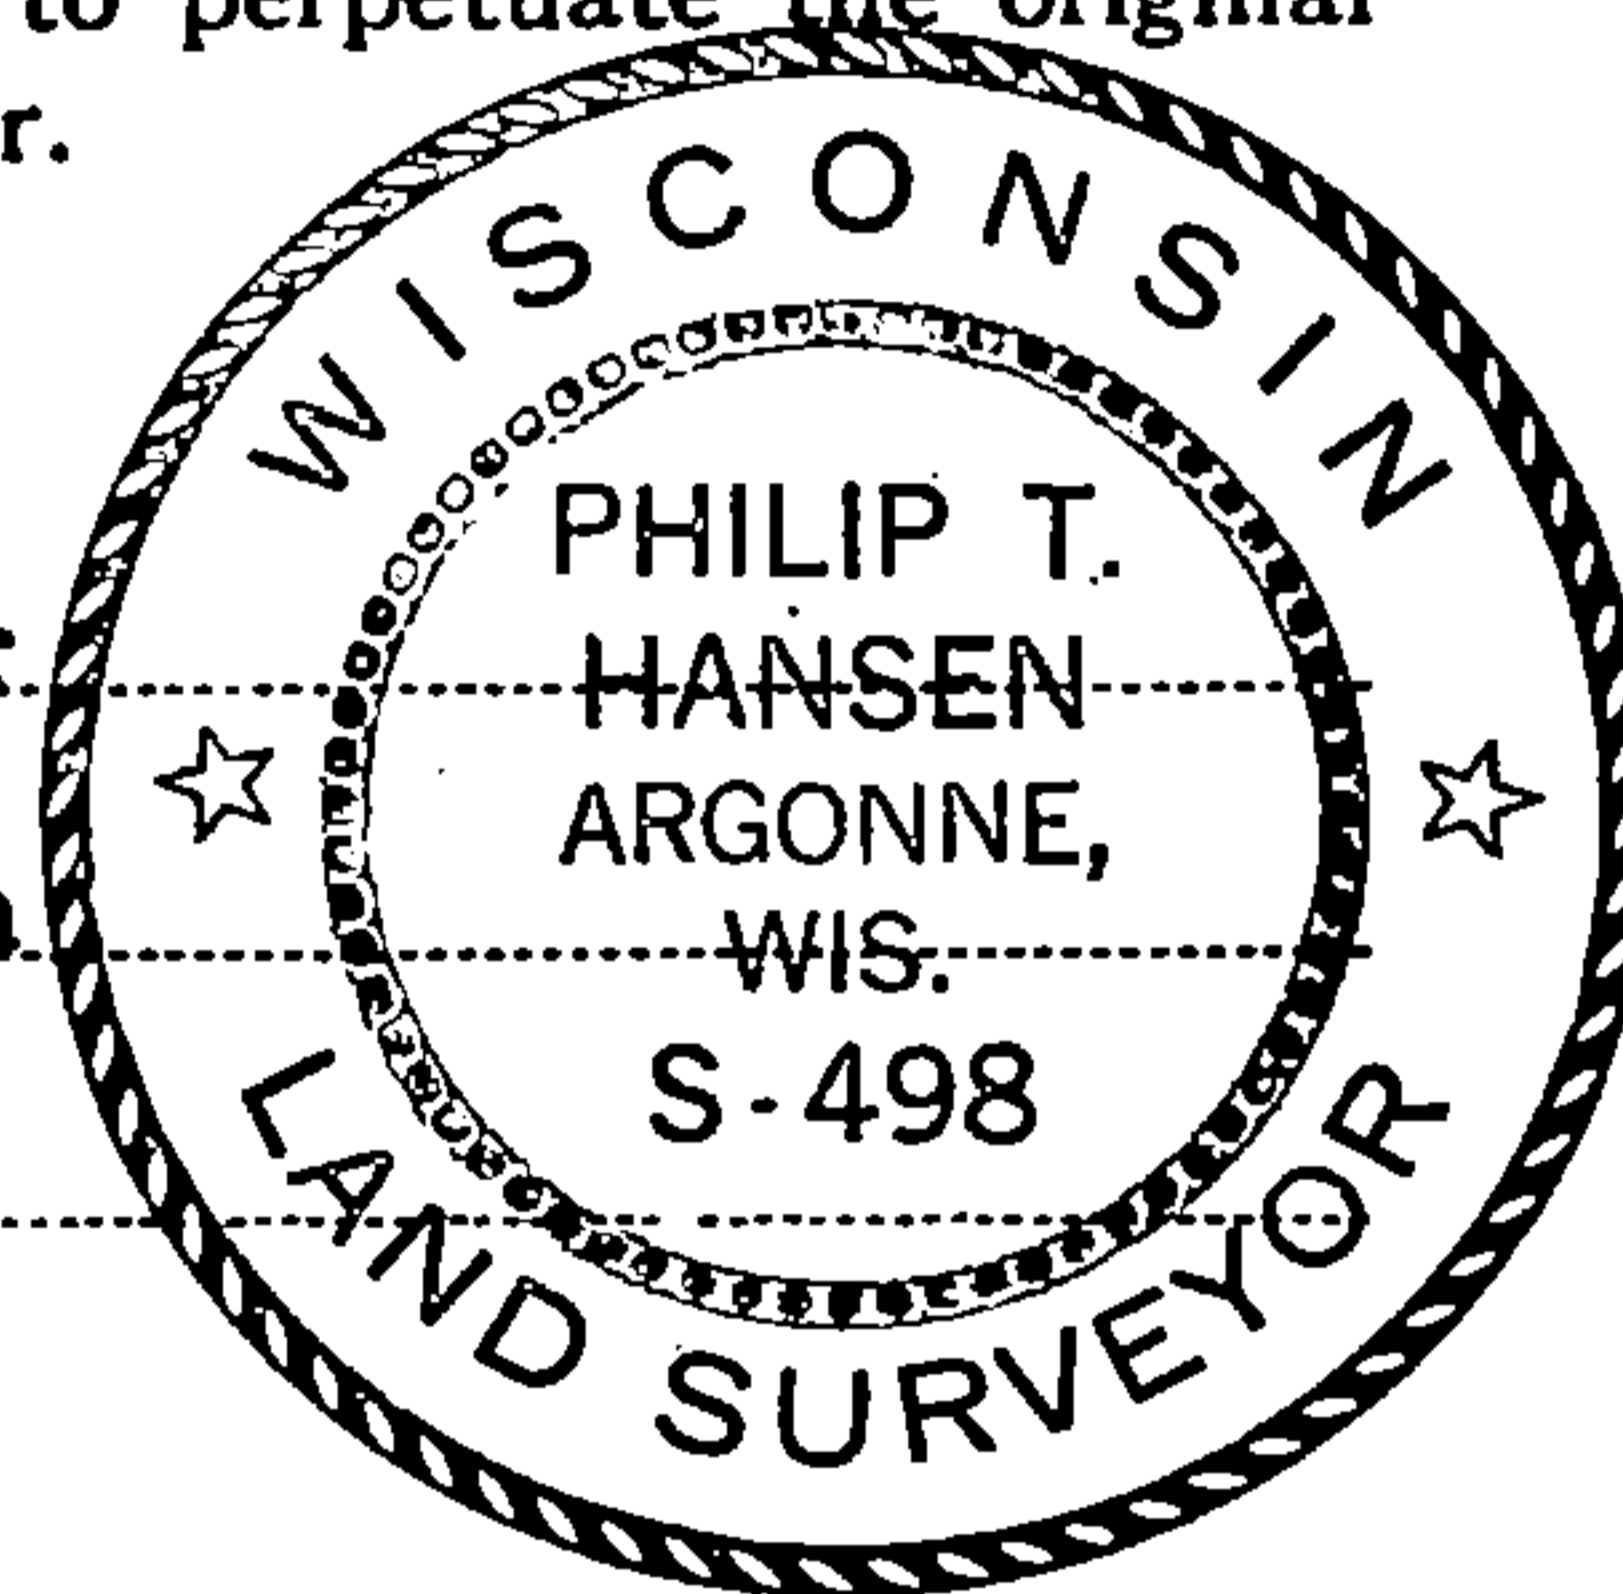

T36N R14E

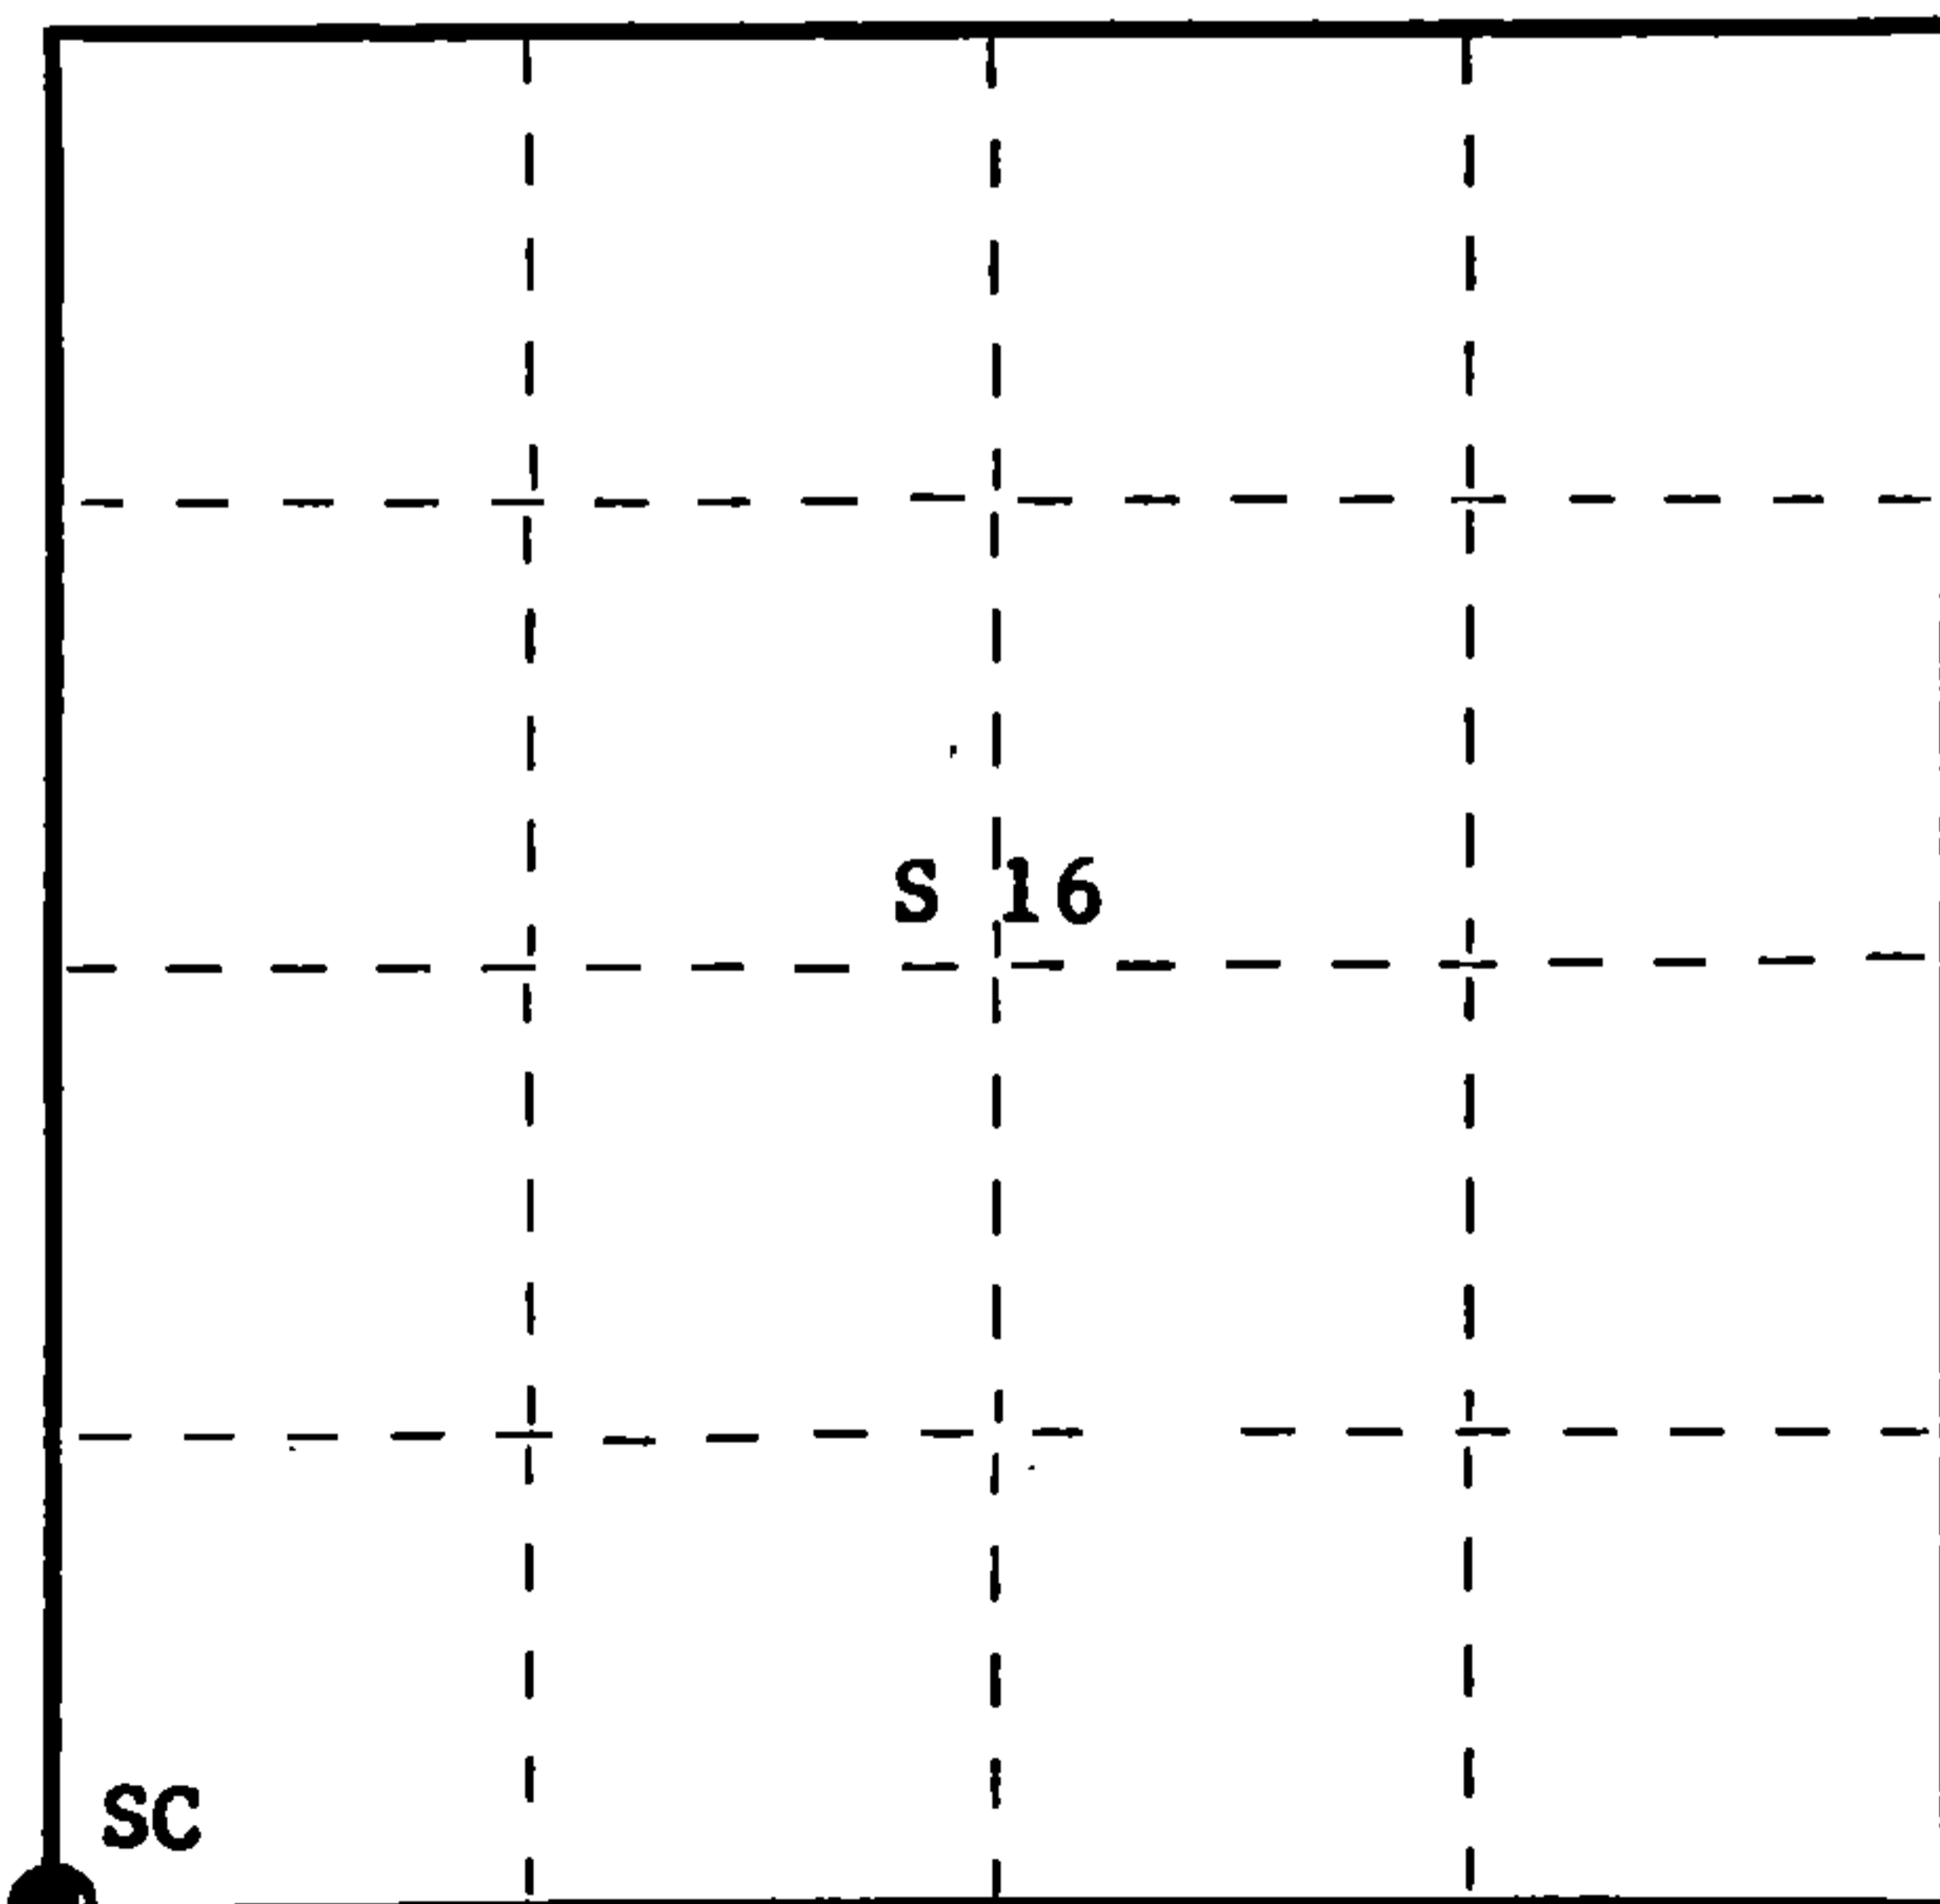

○ = Corner monument restored.

History of original corner establishment: Original corner established by James McBride, Deputy Surveyor, in 1859 from which hemlock 20" bears N52°W, 52 links, hemlock 20" bears N48°E, 9 links, hemlock 14" bears S29°E, 32 links, and sugar 10" bears S25°W, 40 links.

Corner recovered and maintained by Connor Forest Industries Foresters for many years.

Description of corner evidence found: Recovered old broken off cedar post, squared and scribed S16, S17, S20, S21 lying on the ground. Also recovered a 1-1/2" x 30" iron shaft around which a rock cairn had been placed. On removing the rock cairn, and digging the hole for the new pipe, I found the point of an old post buried in the ground.

No traces of old BT's were in evidence.

Description of monument and accessories I established to perpetuate the original location of this corner. Replaced iron shaft and point of old wooden stake with 2-1/2" Berntsen, A-1 Federal Monument, aluminum with magnet installed in cap and base. Cap stamped - Pipe projects 18" above ground. Placed old post and iron shaft beside new pipe.

NBT's - Sugar 14" N28°E 33.7 links scribed SC BT
Sugar 11" S54°E 43.3 links scribed SC BT
Sugar 10" S14°W 20.5 links scribed SC BT

T36N R14E
Sec. 17 | 16
20 | 21
S498-1976

Pipe, post, and BT's painted blue.

Dated at Argonne, Wis., this 26th day of January, 19 76

Signature Philip T. Hansen Title Registered Land Surveyor Registration No. S-498
(County Surveyor, Registered Land Surveyor, or other duly authorized official)

Office of Register of Deeds, County of Forest, I hereby certify that the within instrument was filed in this office for record on the 4th day of February, 1976 at 4:00 o'clock P. M.

Eugene Staszny
(Register of Deeds)

By _____ Deputy

DOCUMENT NUMBER ---- **108718**

FORM 985 H. C. MILLER CO., MILWAUKEE

4361417000