

CERTIFIED LAND CORNER RESTORATION


State of Wisconsin }  
County of Forest } ss.

I, Philip T. Hansen, do hereby certify that on the 20th day of January, 1976, I found evidence of the Quarter corner of Sections 20 and 21 Township 36, North, Range 14 East, Fourth Principal Meridian, as described hereon; and that from this evidence I established a new monument and accessories as described hereon to perpetuate the original location of this corner.


Resident witnesses:

Glen Barker

Jim Claflin

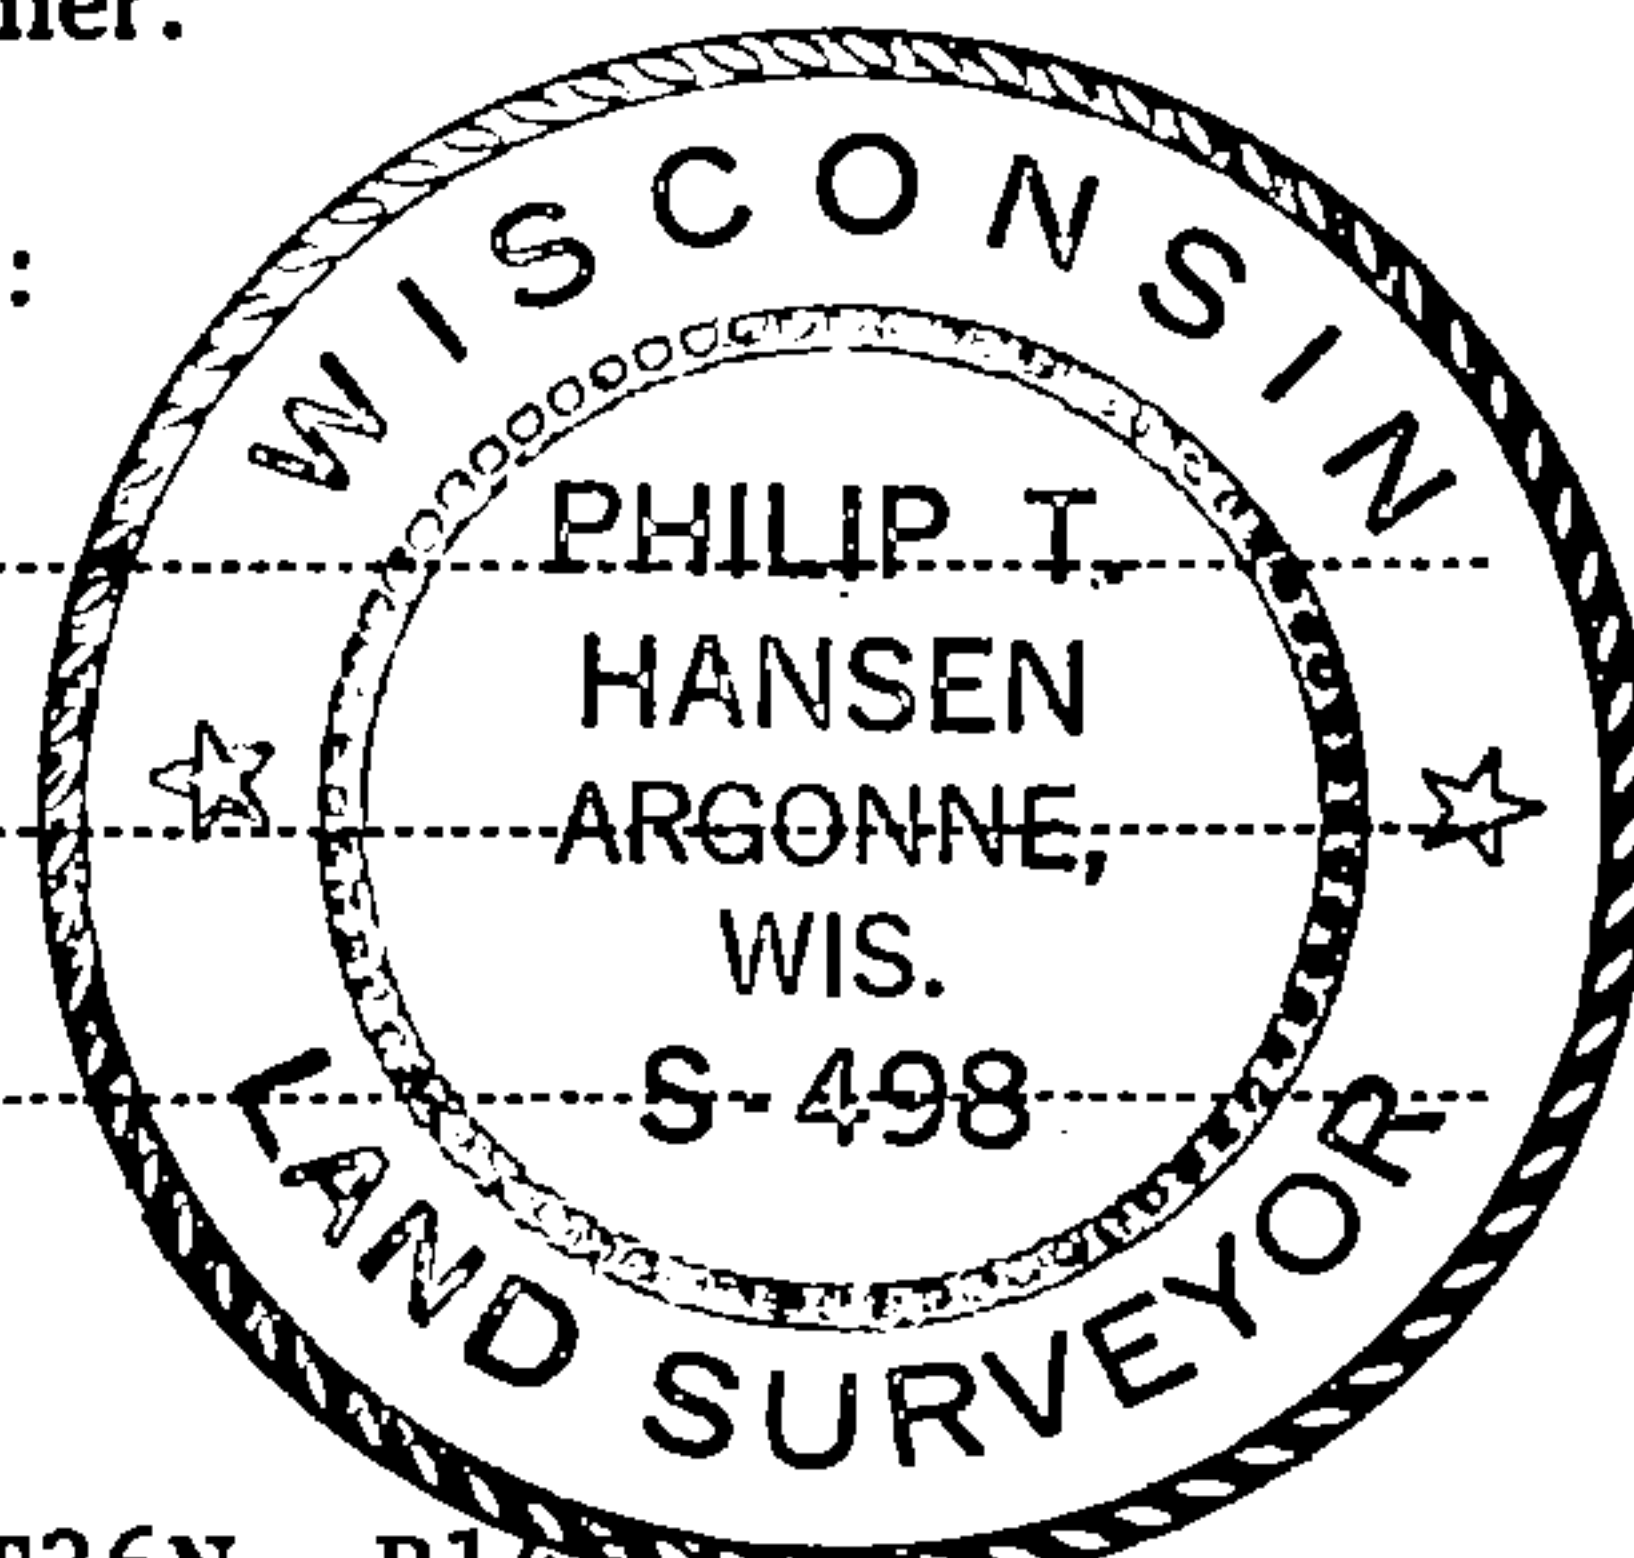

T36N, R14E

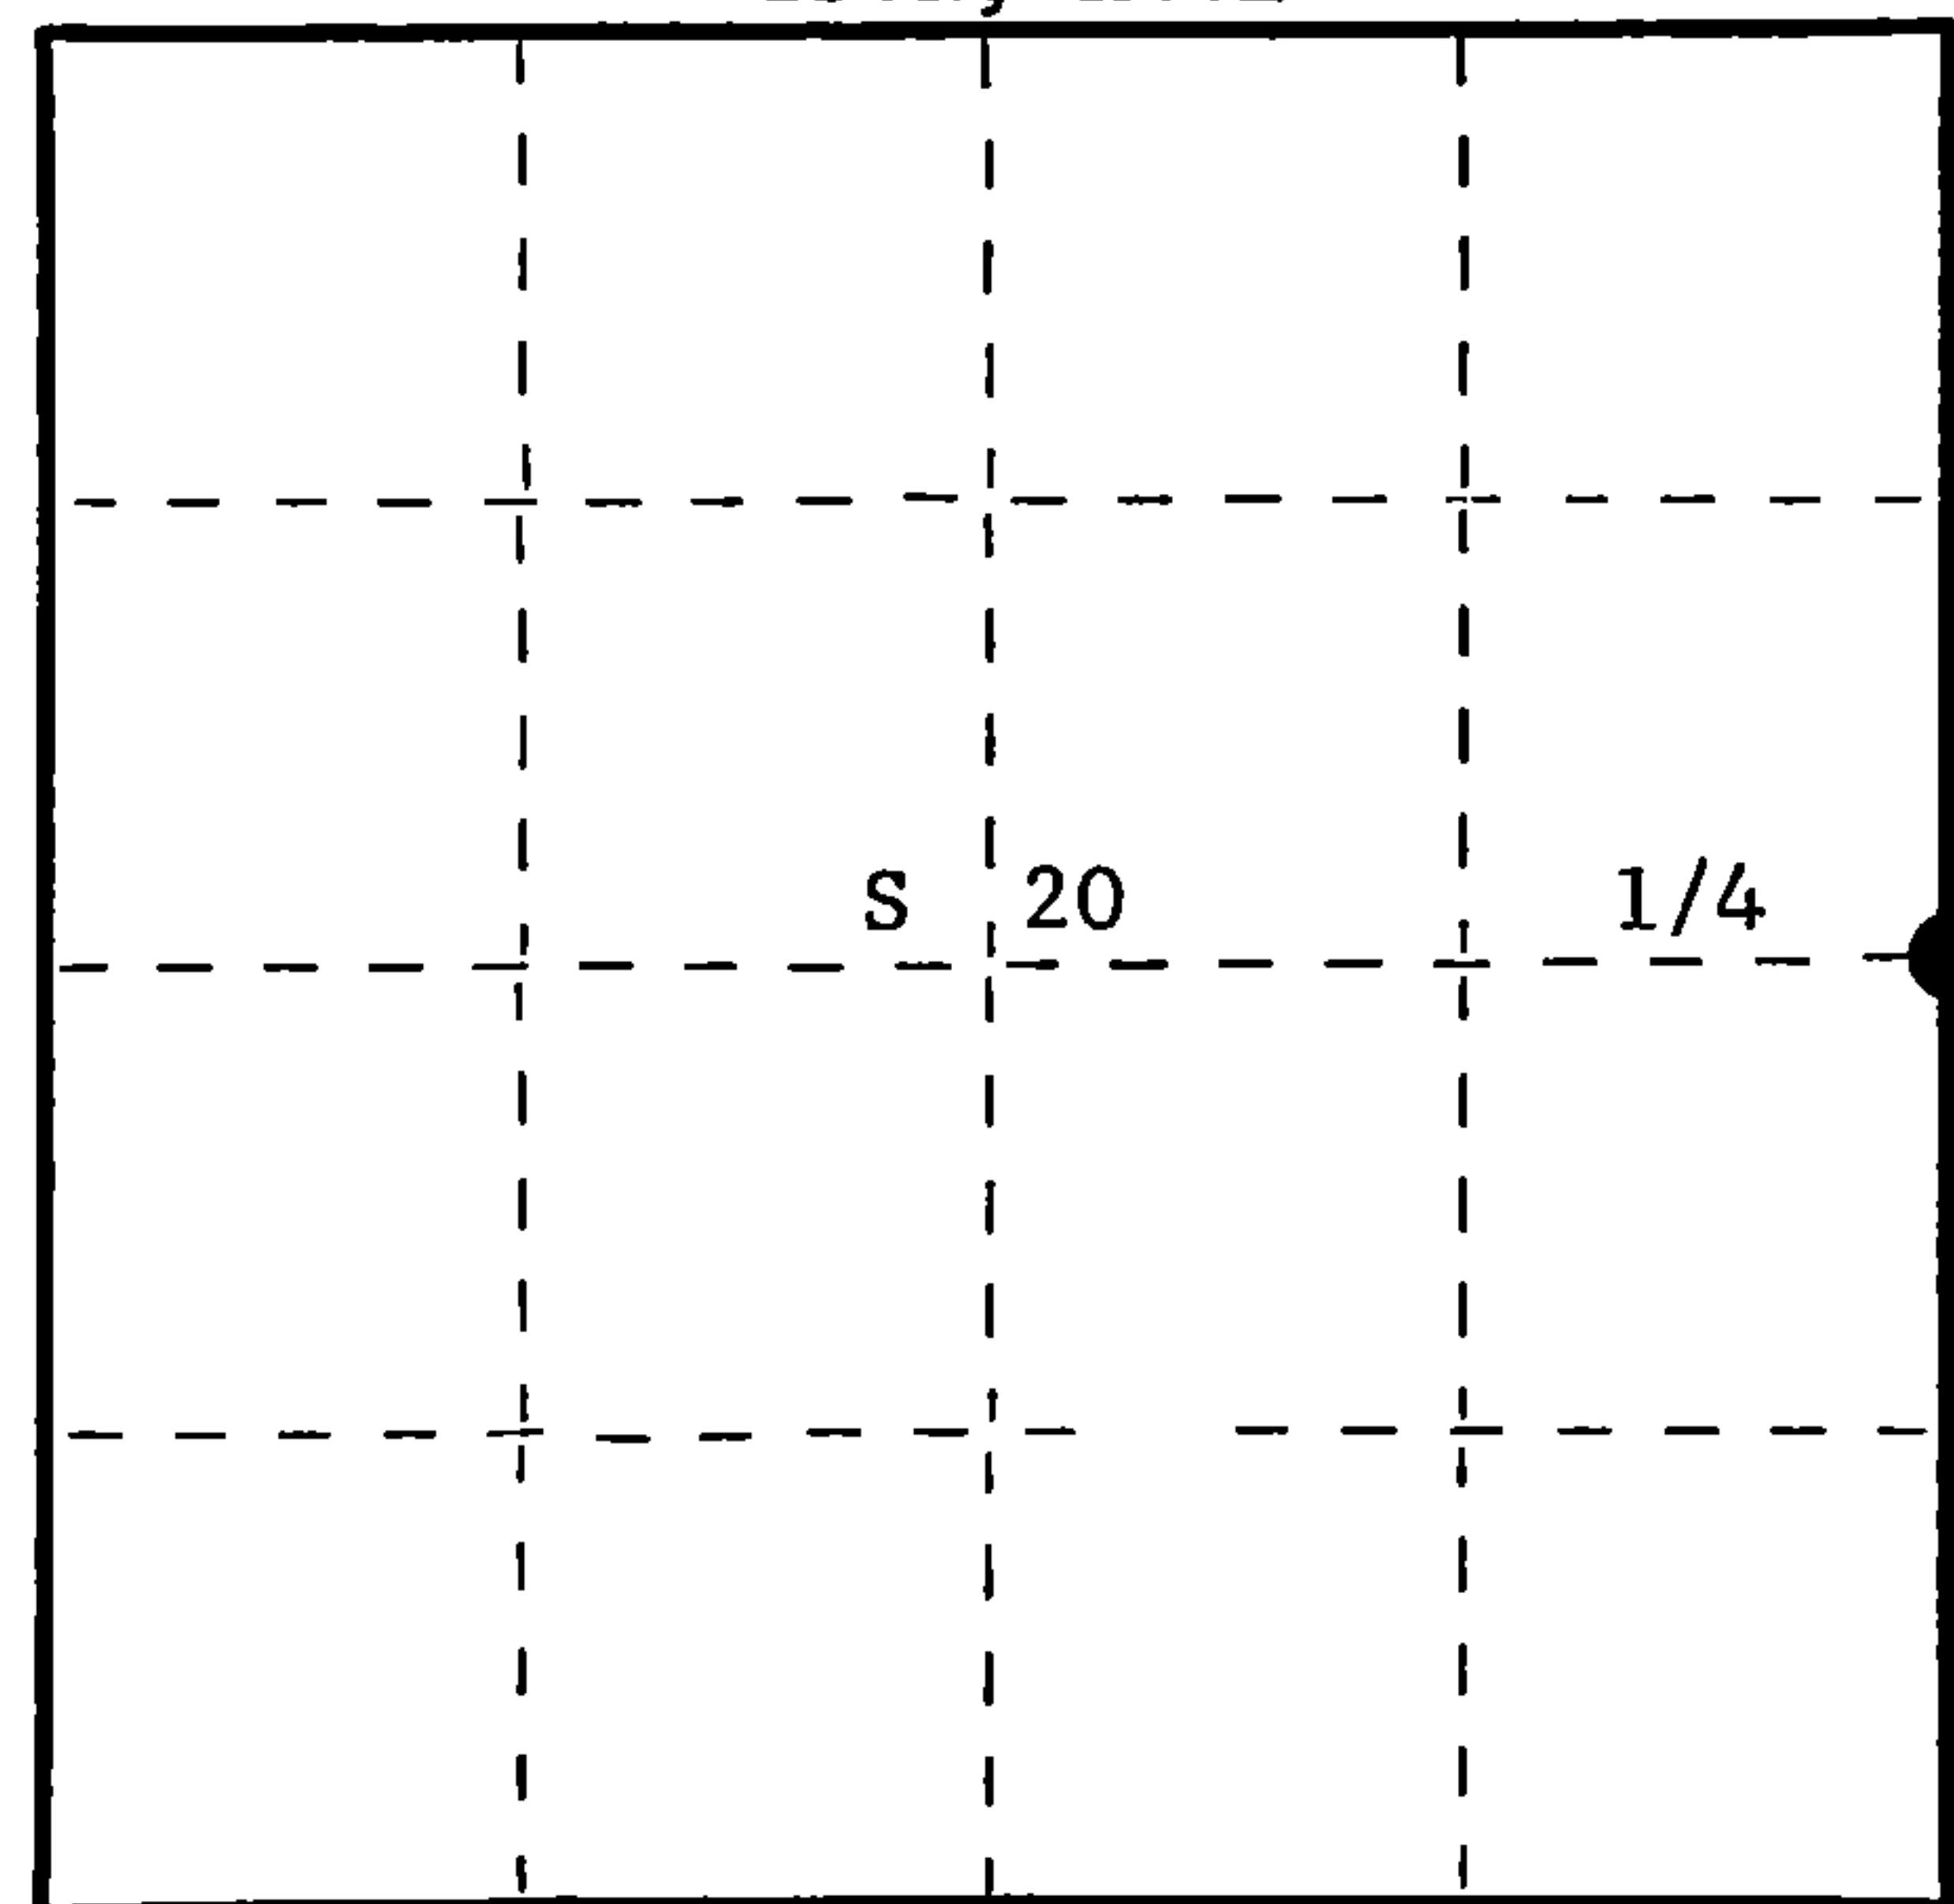

○ = Corner monument restored.

History of original corner establishment:

Original corner established by James McBride, Deputy Surveyor, in 1859 from which hemlock 10" bears N87°E, 34 links and hemlock 24" bears N49°W, 14 links.

This corner recovered by Connor Forest Industries surveyor and maintained by foresters for many years.

Description of corner evidence found:

Recovered old 3" squared hemlock stake and a 1-1/2" iron pipe.


No evidence of any OBT's visible.

Description of monument and accessories I established to perpetuate the original location of this corner.

Replaced the 1-1/2" iron pipe, which appeared to be older than the hemlock stake, with 2-1/2" Berntsen A-1 Federal Monument, aluminum, with magnet installed in cap and base. Pipe projects 18" above ground. Set old iron pipe and squared hemlock beside it. Cap stamped -

NBT's - Sugar 10" S29°E 73.7 links Scribed 1/4 BT  
Hemlock 14" S81°W 39.3 links Scribed 1/4 BT

Pipe post and BT's painted blue.

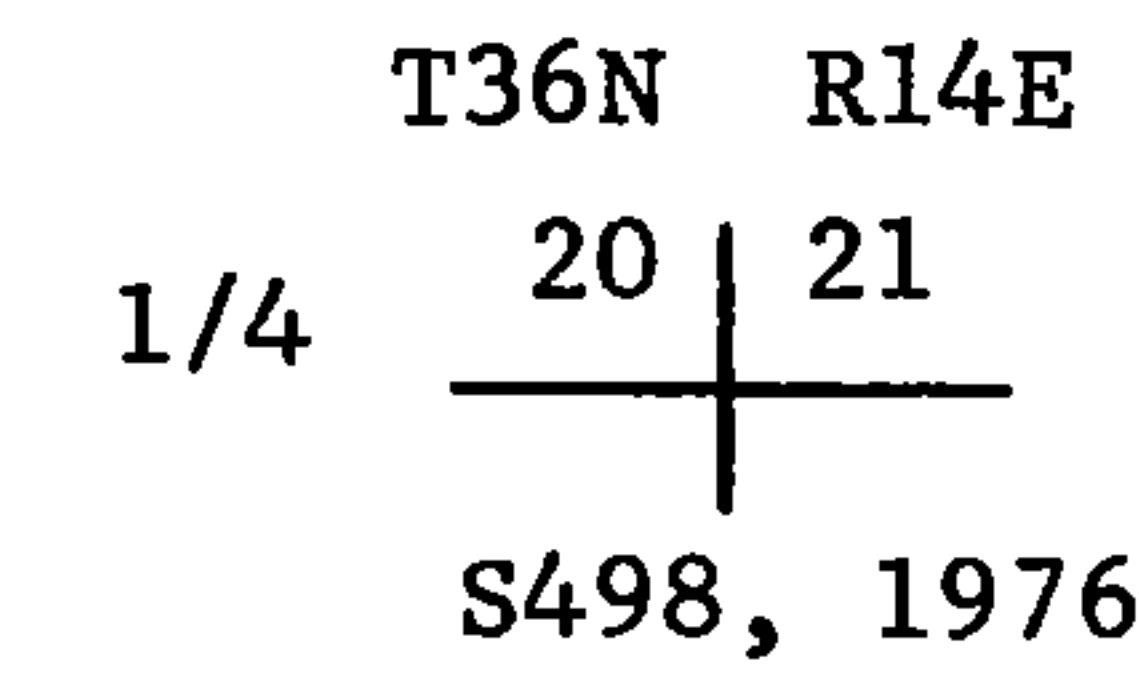

Dated at Argonne, Wis., this 26th day of January, 1976

Signature Philip T. Hansen Title Registered Land Surveyor Registration No. S-498  
(County Surveyor, Registered Land Surveyor, or other duly authorized official)

Office of Register of Deeds, County of Forest, I hereby certify that the within instrument was filed in this office for record on the 4th day of February, 1976 at 4:00 o'clock P. M.

Eugene Staszny  
(Register of Deeds)

By \_\_\_\_\_ Deputy

DOCUMENT NUMBER **108721**

FORM 985 H. C. MILLER CO., MILWAUKEE

43614202000