
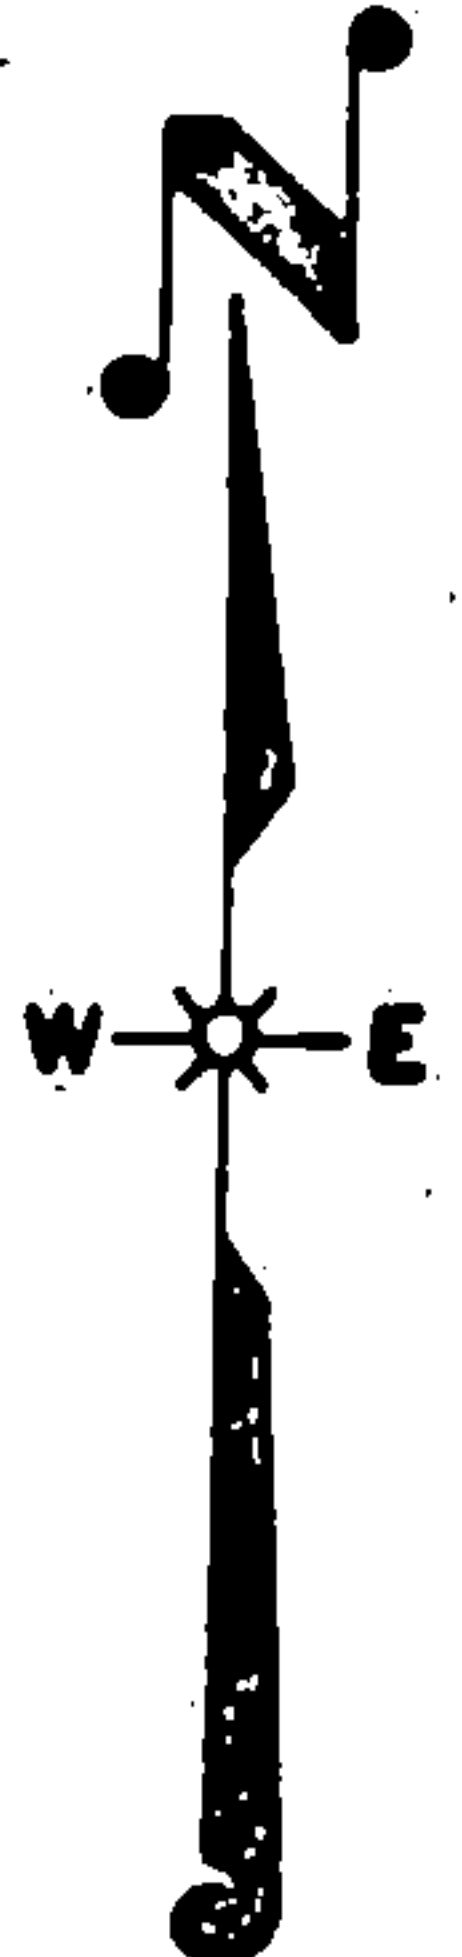


FIELD SURVEY NOTES
PRESERVATION OF LANDMARKS
(Pursuant to Section 59.635(7) Wisconsin Statutes)


State Highway Commission of Wisconsin
Form E-D-707-85

COUNTY Forest		
TOWN Laona		
HIGHWAY U.S.H. 8		
SECTION 25-26-35-36	TOWNSHIP 36 N.	RANGE 14 E.
TYPE OF LANDMARK Sec. Corner		

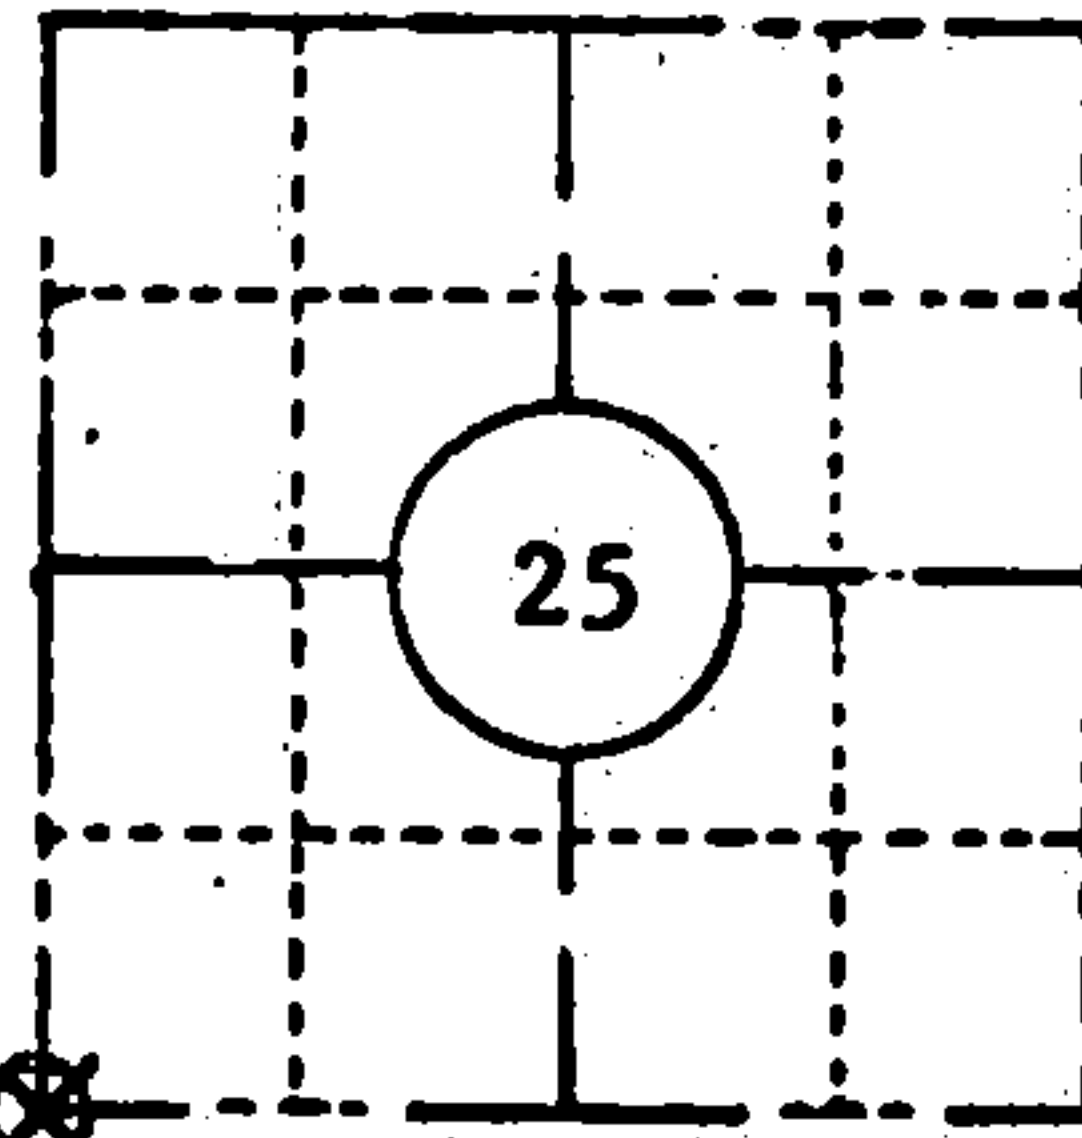

LOCATION SKETCH
(Location of landmark indicated by "x")

This space for copy of field notes or ties to the above described landmarks.

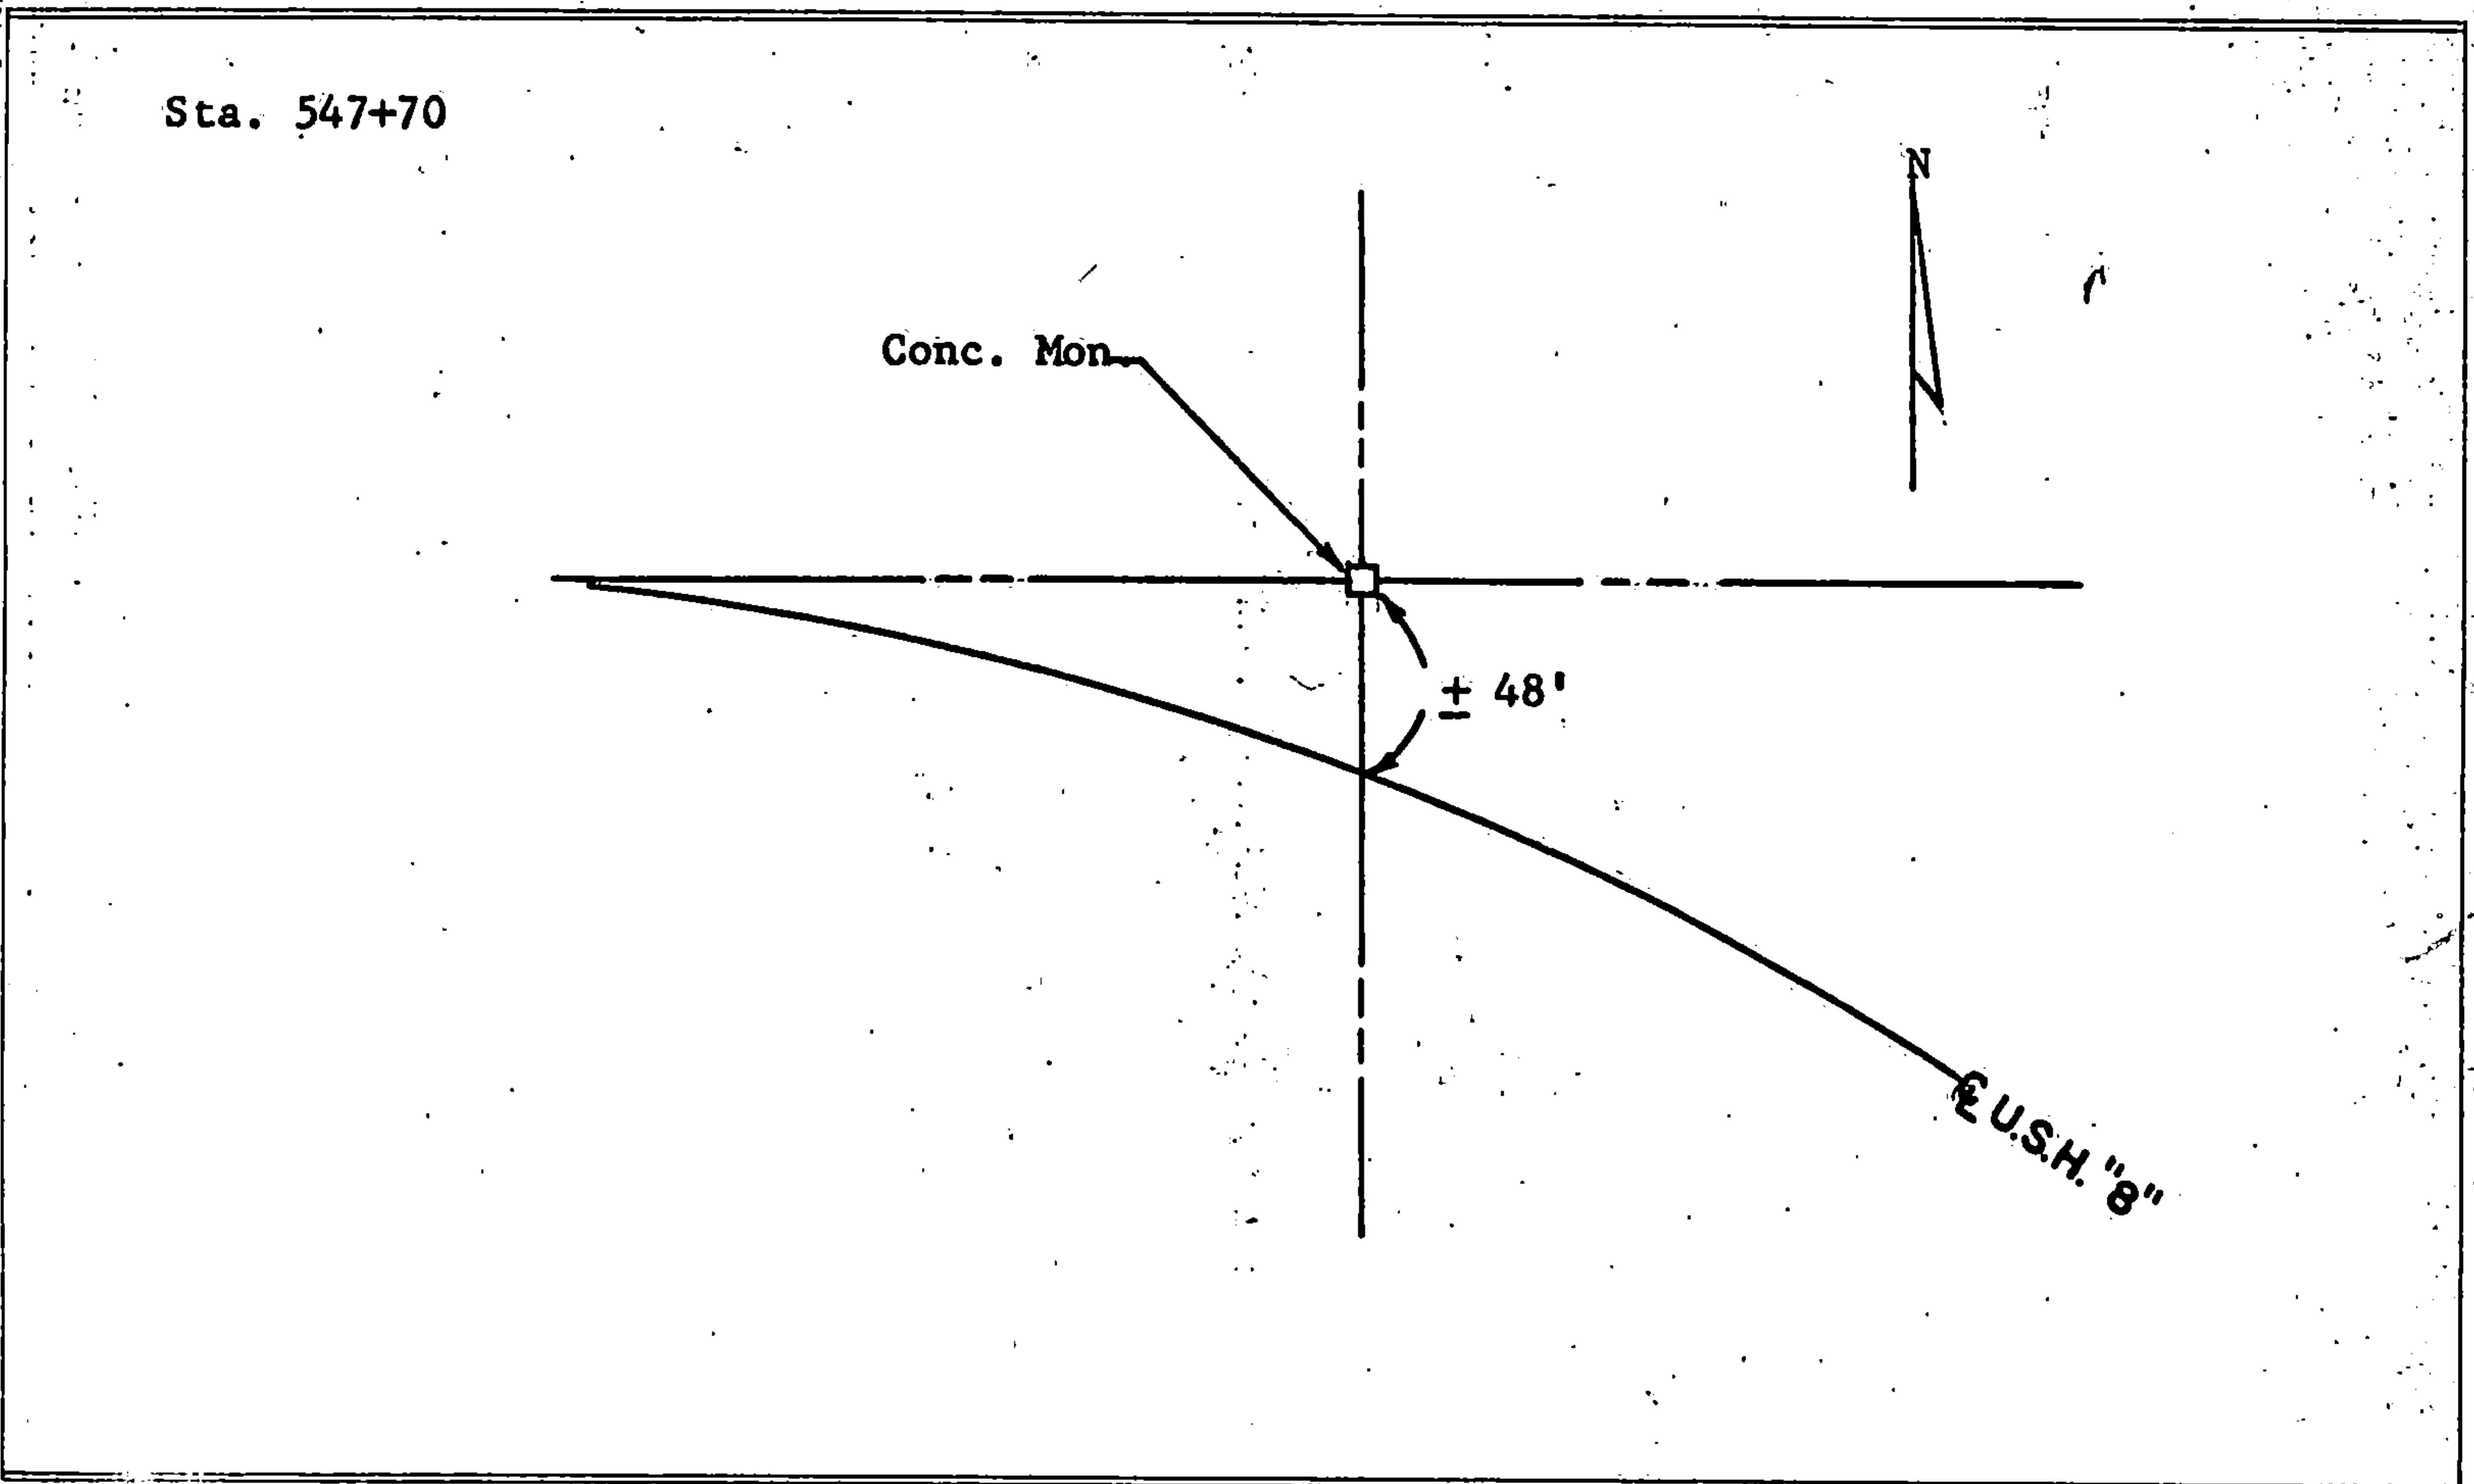

FILED UNDER PROJECT NUMBER F 021-3(14)		
SHC DISTRICT OFFICE NUMBER 7	CITY Rhineland	COUNTY Oneida
LOCATED OR ESTABLISHED BY NAME T.W.S. TITLE Party Chief DATE 9/30/65		

COUNTY CLERK'S OFFICE COUNTY REGISTER'S OFFICE FOREST COUNTY WISCONSIN	90694
DATE RECEIVED FOR RECORD	DATE COPY SENT TO COUNTY SURVEYOR
SIGNATURE OF COUNTY CLERK Oct 5 1965	

PRESERVATION OF LANDMARKS

Karl A. Cuyler
Register of Deeds

PAGE _____

43614260000

V21