



FIELD SURVEY NOTES
PRESERVATION OF LANDMARKS
(Pursuant to Section 59.635(7) Wisconsin Statutes)

State Highway Commission of Wisconsin
Form E-D-707-65


COUNTY Forest		
TOWN Laona		
HIGHWAY U.S.H. 8		
SECTION 27 - 34	TOWNSHIP 36 N.	RANGE 14 E.
TYPE OF LANDMARK 1/2 Corner		

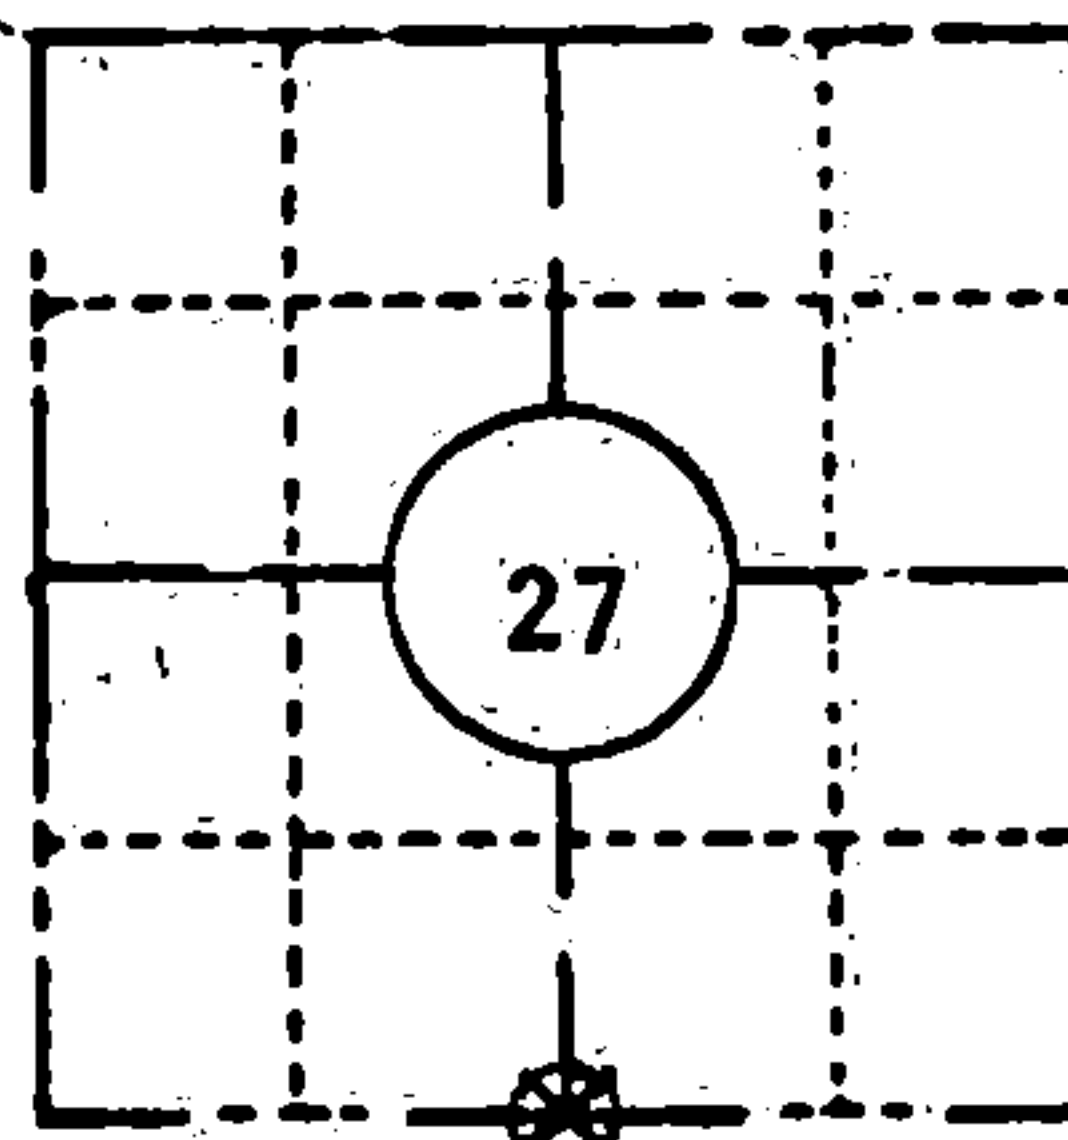

LOCATION SKETCH
(Location of landmark indicated by "x")

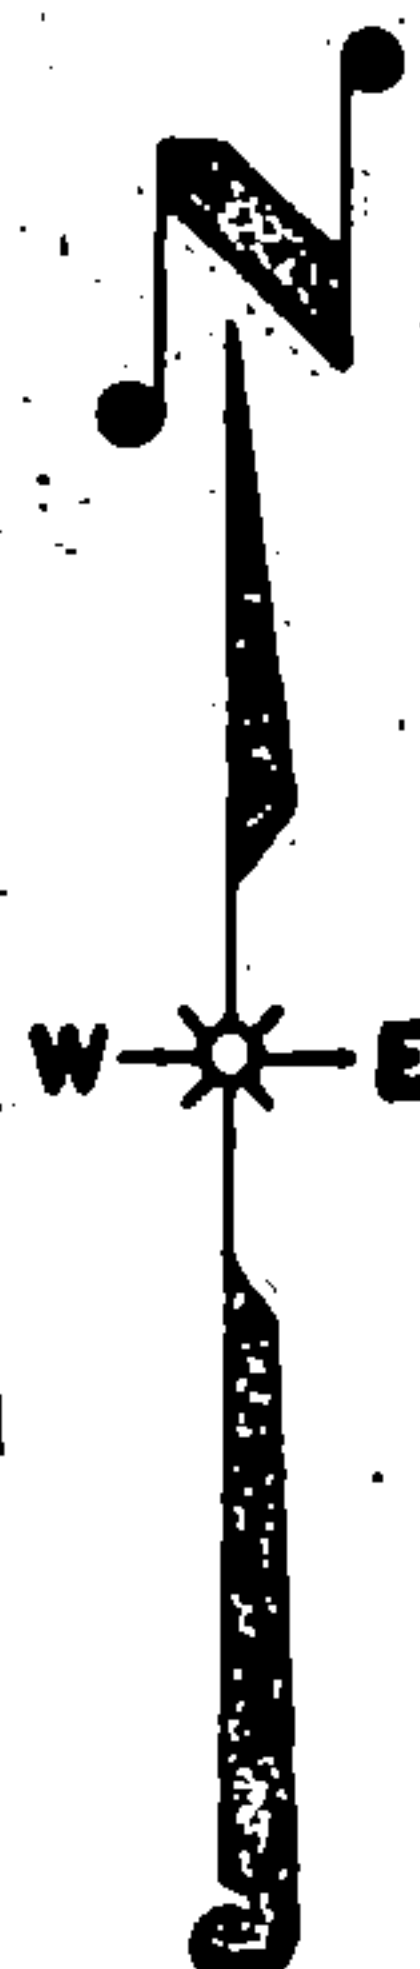

This space for copy of field notes or ties to the above described landmarks

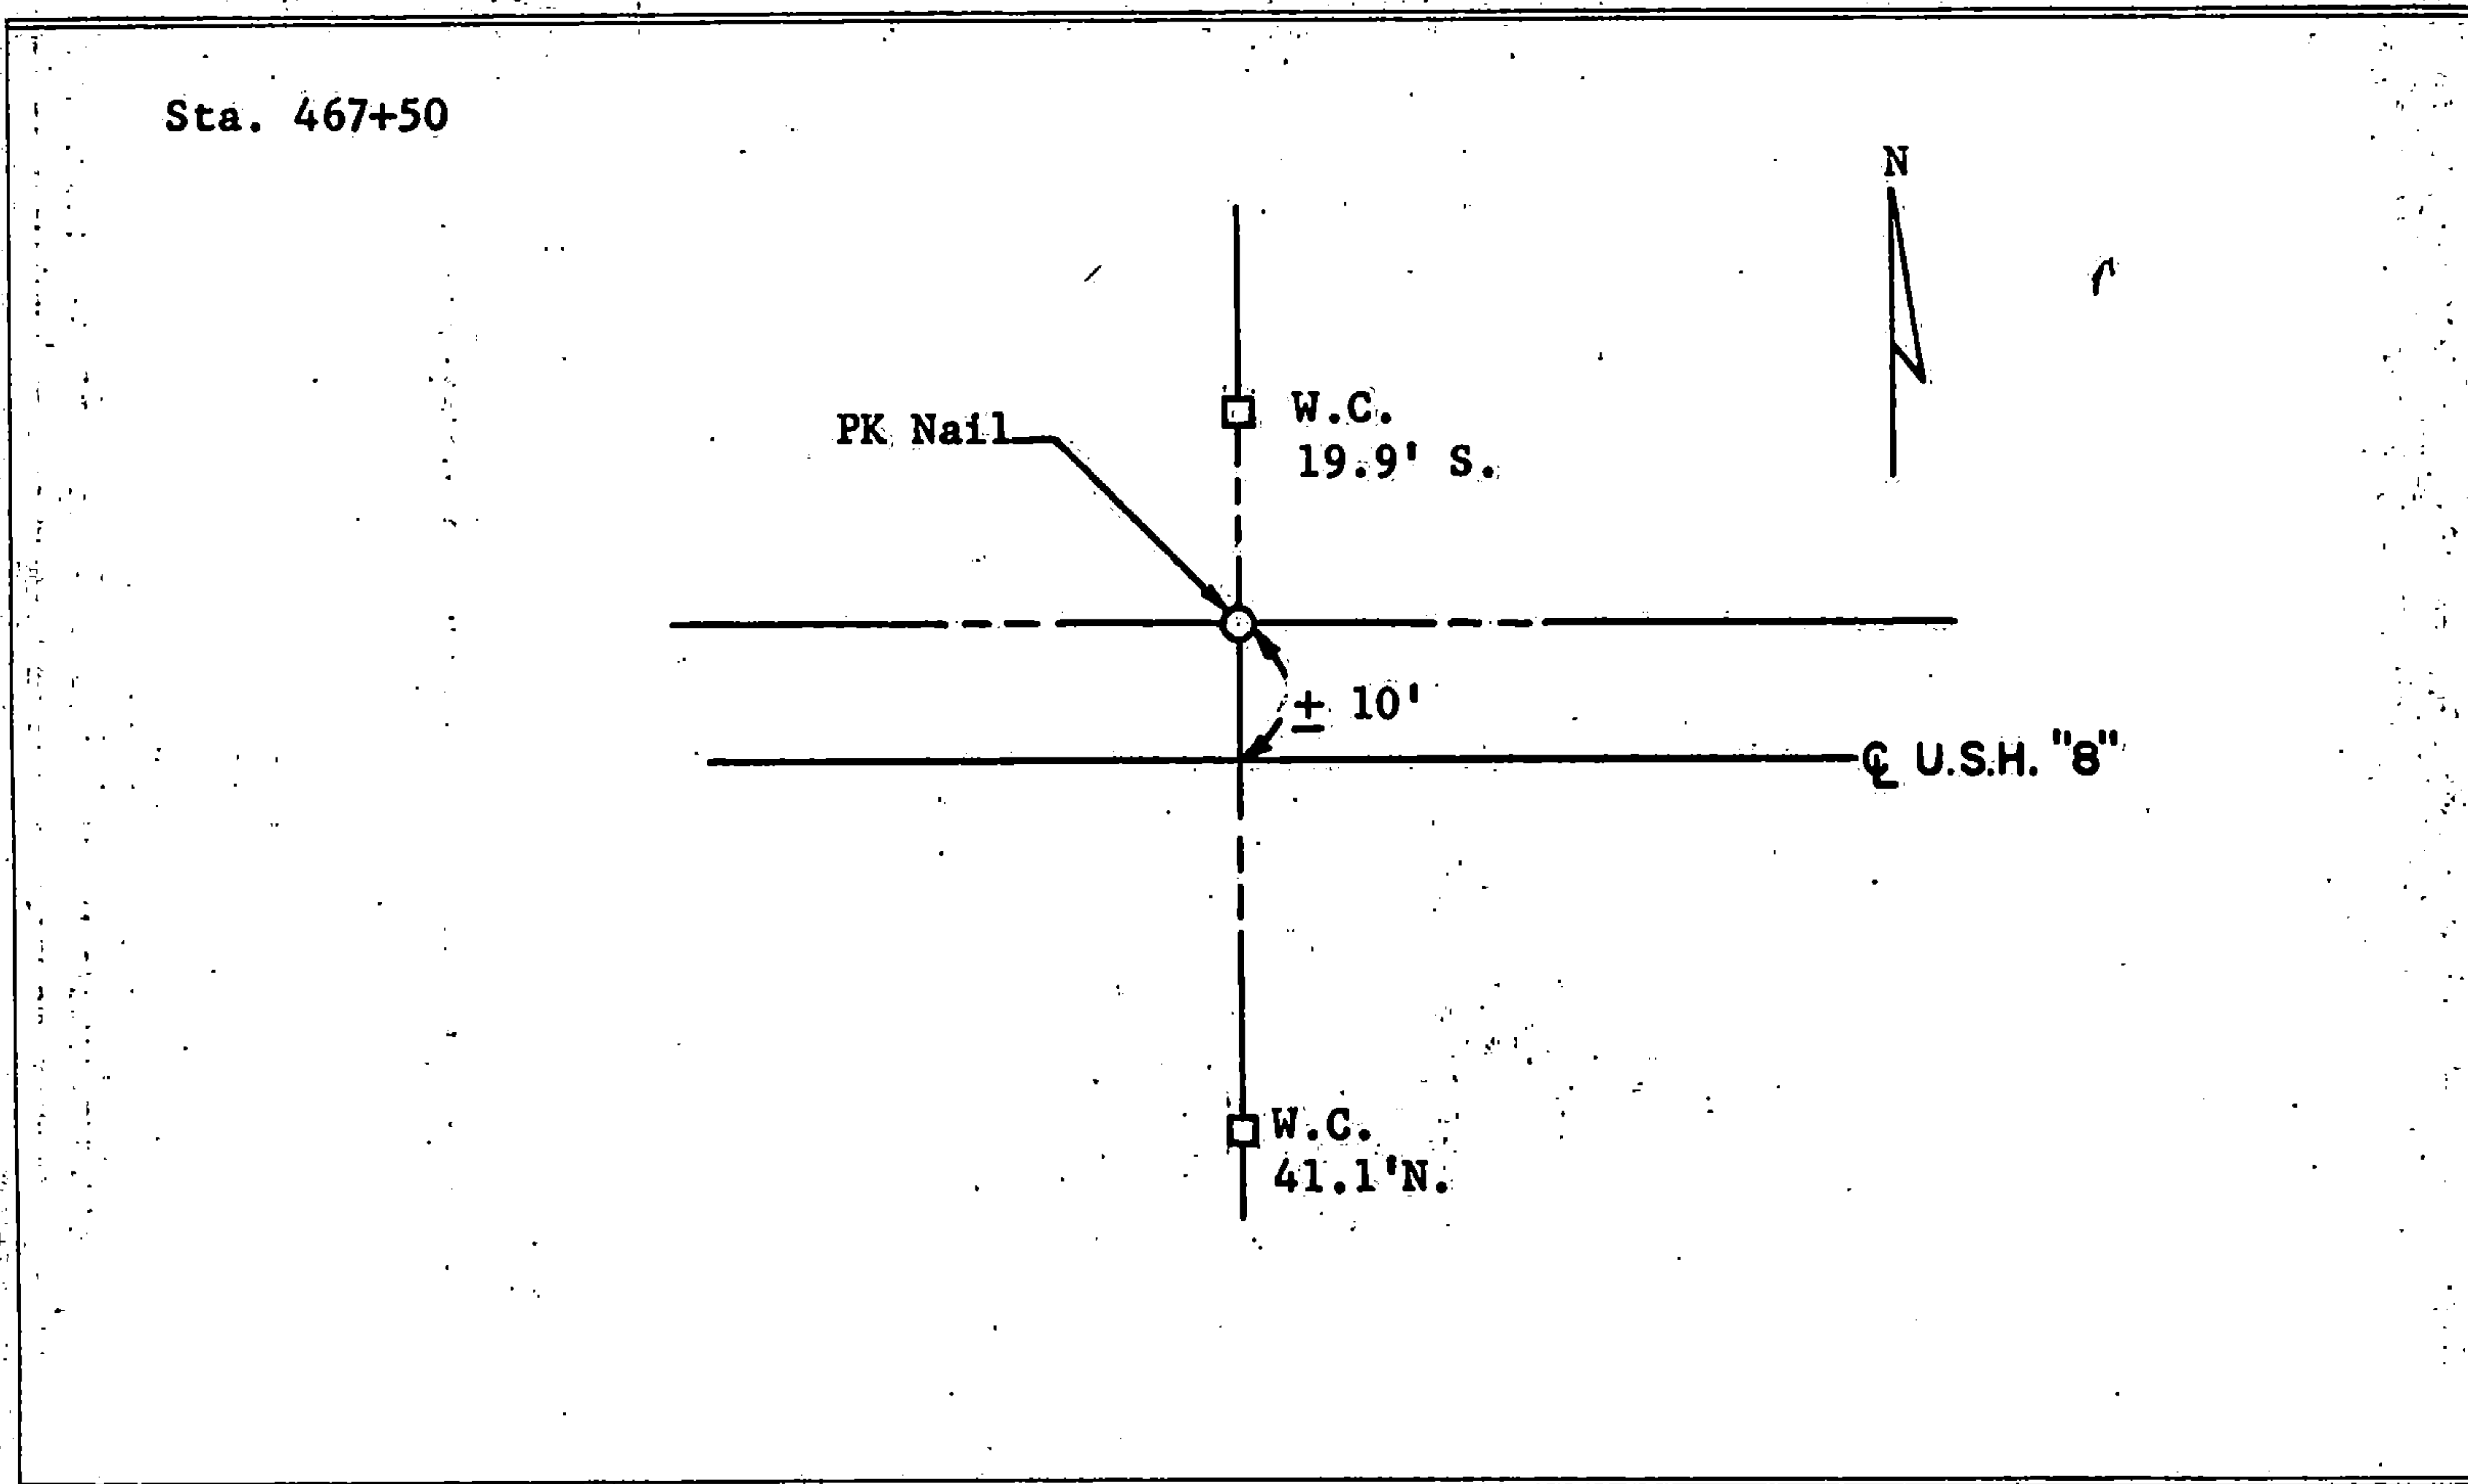

FILED UNDER PROJECT NUMBER F 021-3(14)		
SHC DISTRICT OFFICE NUMBER 7	CITY Rhineland	COUNTY Oneida
LOCATED OR ESTABLISHED BY NAME T.W.S. TITLE Party Chief DATE 9/29/65		

COUNTY CLERK'S OFFICE COUNTY FOREST COUNTY, WIS. WISCONSIN } 59
DATE RECEIVED FOR RECORD DATE COPY SENT TO COUNTY SURVEYOR
SIGNATURE OF COUNTY CLERK <i>Carl J. [Signature]</i> O'clock 11 M

PRESERVATION OF LANDMARKS

PAGE _____

4361427 0020

115