

CERTIFIED LAND CORNER RESTORATION

State of Wisconsin }
County of Forest } ss.

I Jean F. Resvick, do hereby certify that on the 30th day of September, 1965, I found evidence of the Northeast Section corner of Section Two Township 35 North, Range 14 East, Fourth Principal Meridian, as described hereon; and that from this evidence I established a new monument and accessories as described hereon to perpetuate the original location of this corner:

Description of original monument and accessories and subsequent restorations:


Surveyed in 1858
80.00 chains west between sections 1 and 36
Set wood post
Sugar 11", N55°E, 50 lks.
Yellow Birch 40", N55°W, 25 lks.
Sugar 18", S22°W, 47 lks.

Description of corner evidence found:

Iron pipe in mound of rock, Forest tag dated 3/20/36 on basswood, N40°E, 8.5 ft. tag marked corner S40°W, 12 links.
Yellow Birch stump, blown over, badly rotted, had been at least 40 inch. diameter N 55°W, 16.5 ft. to stump hole from iron pipe.
From iron pipe, S22°W, 31.0 ft. Sugar Stump hole.

Description of monument and accessories I established to perpetuate the original location of this corner:

Replaced iron pipe with 2 inch inside diam., galvanized iron pipe, 5 feet long, filled with concrete, flanged at bottom, with brass cap marked

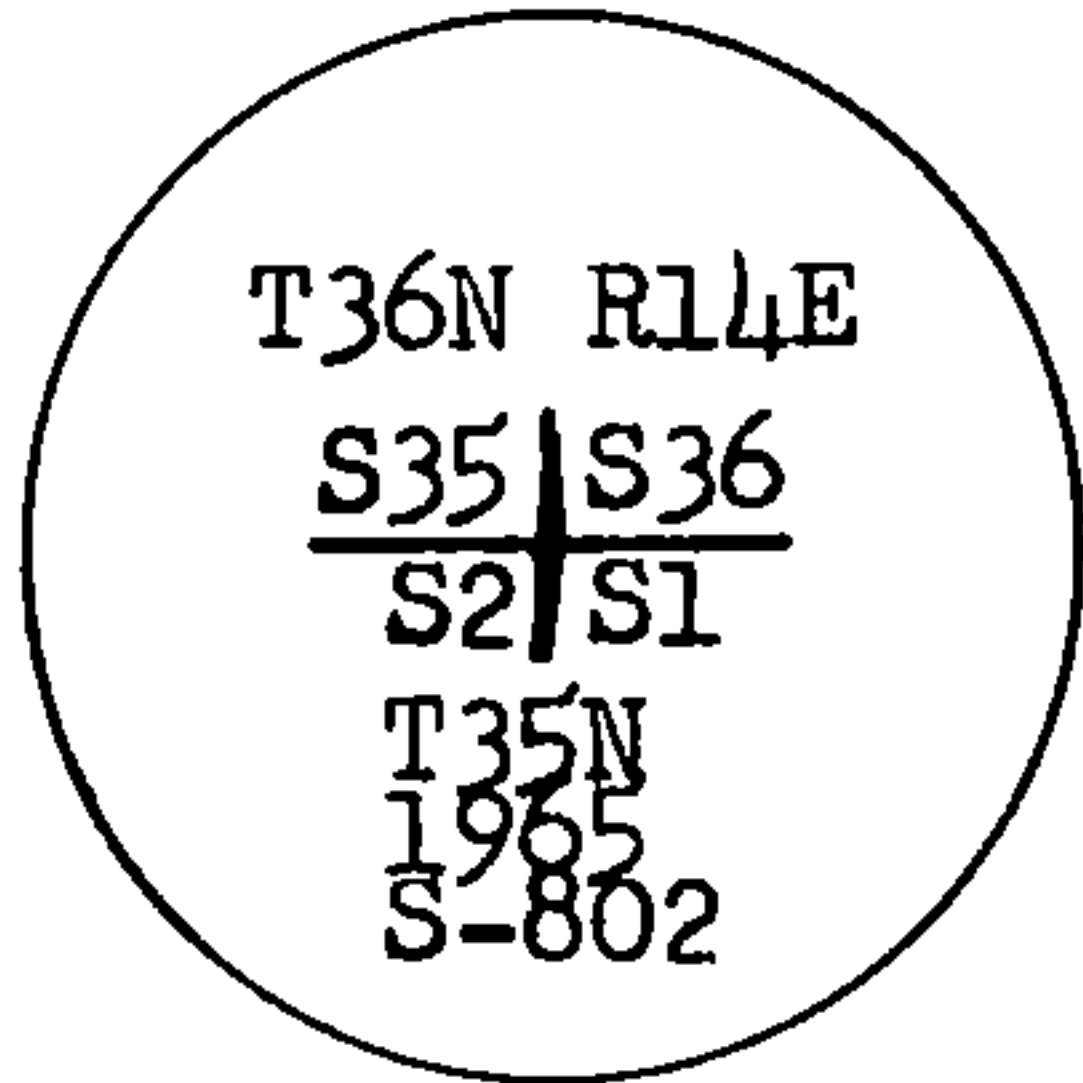

from which the following blazed and scribed new bearing trees bear
Basswood 10", N40°E, 8.45 ft. or 12.80 lks.
Yellow Birch 9", S22°E, 26.69 ft. or 40.44 lks.
Maple 4", S22°W, 19.56 ft. or 29.64 lks.
Maple 7", N48°W, 34.18 ft. or 51.79 lks.

I placed 1 1/4" diameter pipe 4 feet long found on south side of monument.

Resident witnesses _____

Dated at Rhinelander Wisconsin, this 9th day of Feb. 1966.


Signature Jean F. Resvick Title Cadastral Surveyor
(County Surveyor, Registered Land Surveyor, or other duly authorized official)

Surveyors Registration No. S-802 91353

Office of Register of Deeds County of Forest

I hereby certify that the within instrument was filed in this office for record on the 13 day of April 1966, and was filed in Book No. _____ Page No. _____ of County Records.

Signature Anna Peterson Title Register of Deeds

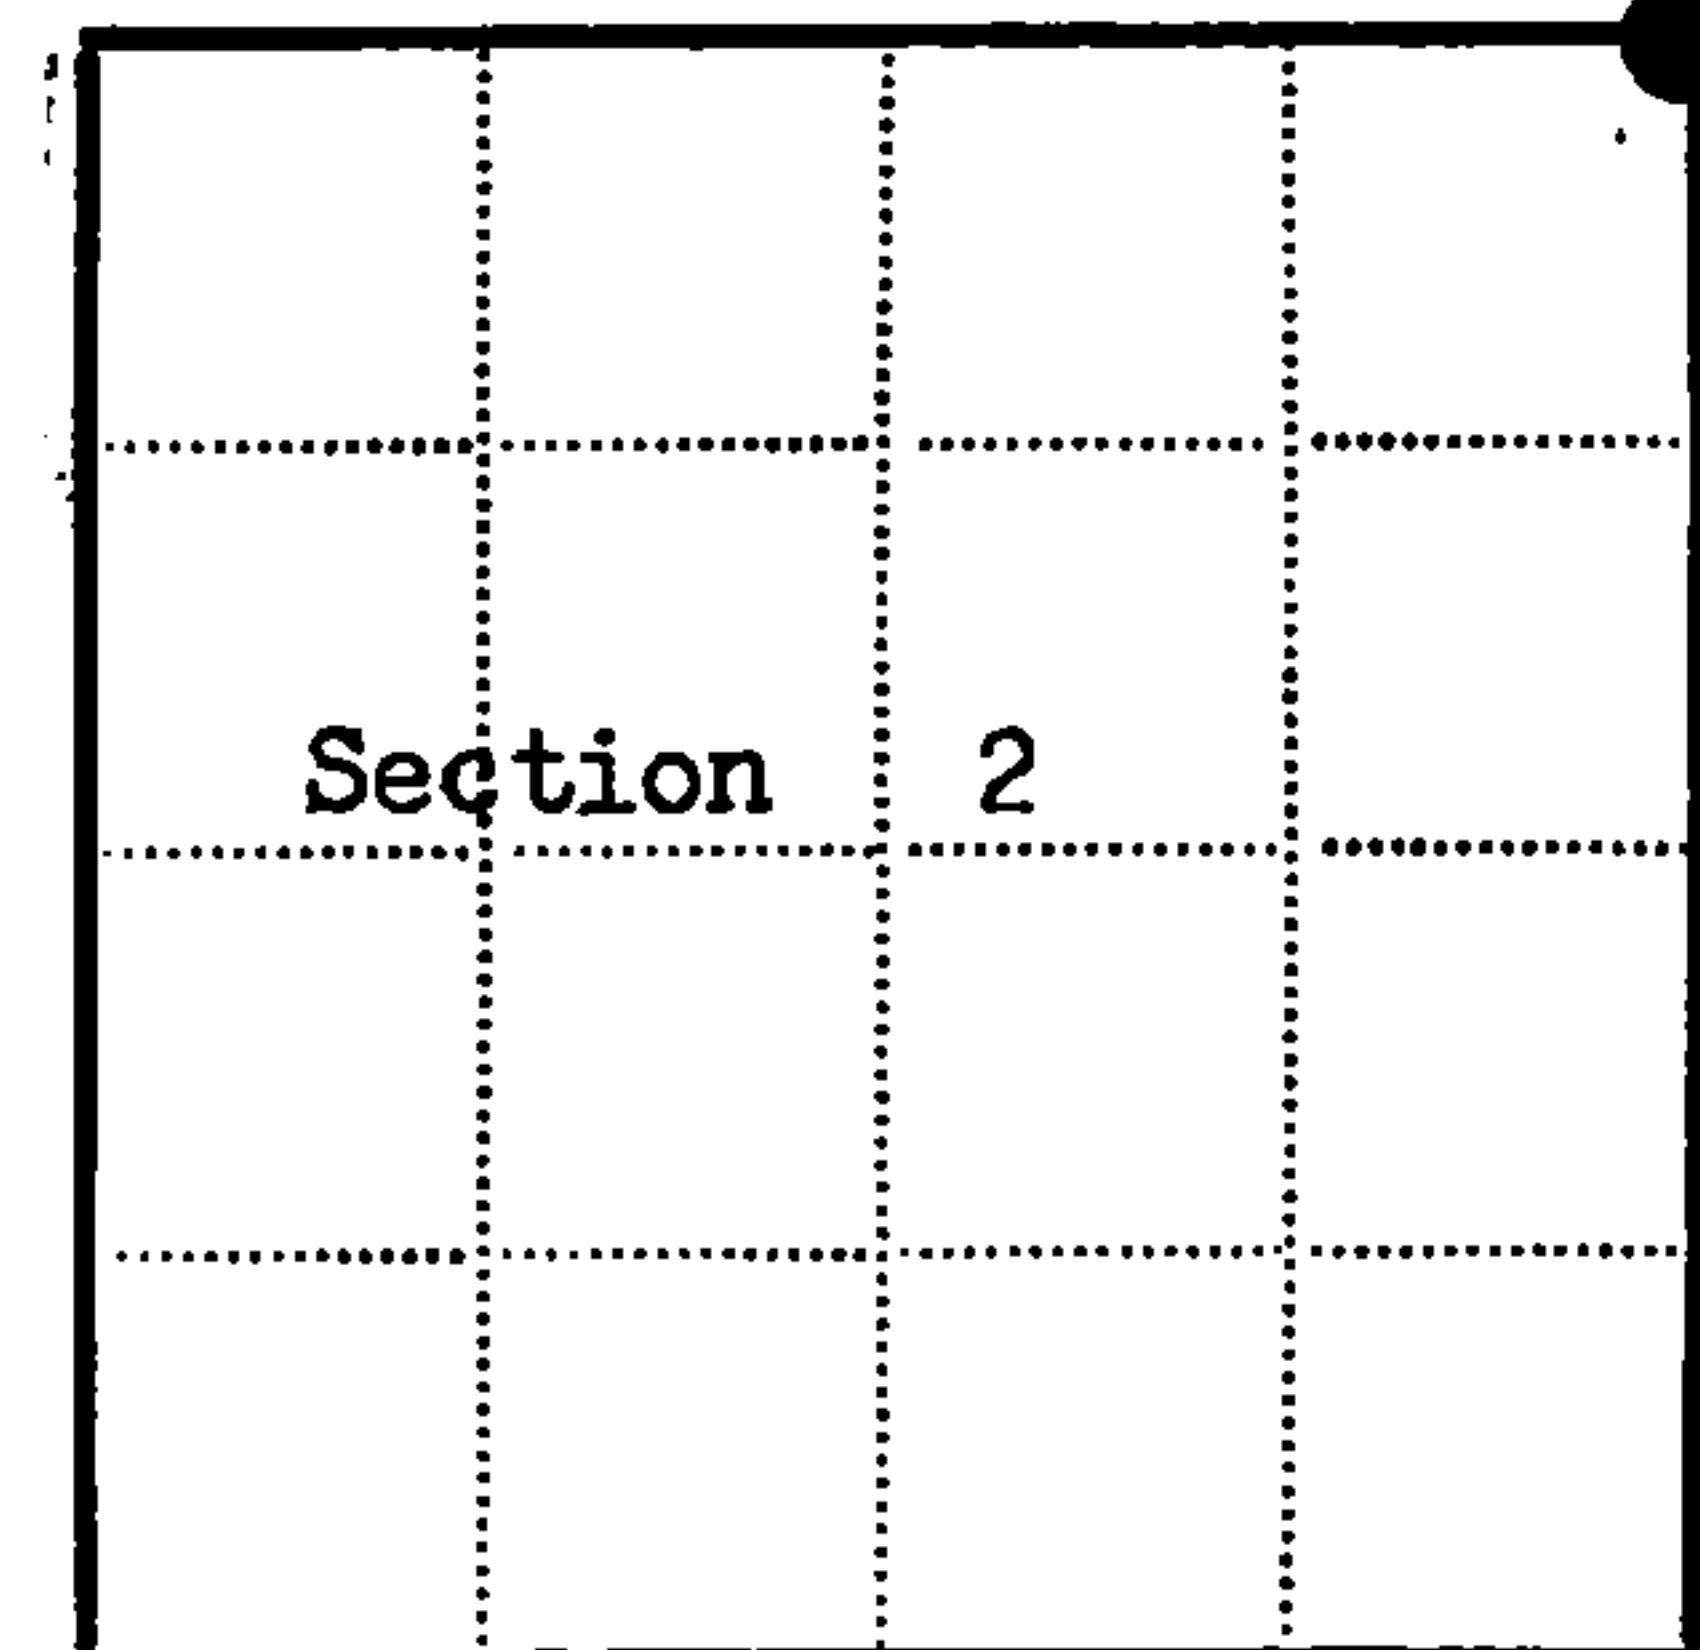

● = Corner monument restored
□ =

Township 35 North, Range 14 East, Section 2, Index No. A-21, Page No. _____

43614350000

A 21