

CERTIFIED LAND CORNER RESTORATION

Index No. D-25

State of Wisconsin }
County of Forest } ss.


I Philip T. Hansen, do hereby certify that on the 13th day of December, 1976, I found evidence of the S 1/16 corner of 1 & 6 Township 36, North, Range 15 & 16 East, Fourth Principal Meridian, as described hereon; and that from this evidence I established a new monument and accessories as described hereon to perpetuate the original location of this corner.

Resident witnesses:


Glen Barker

Jim Claflin

Herb Wagoner

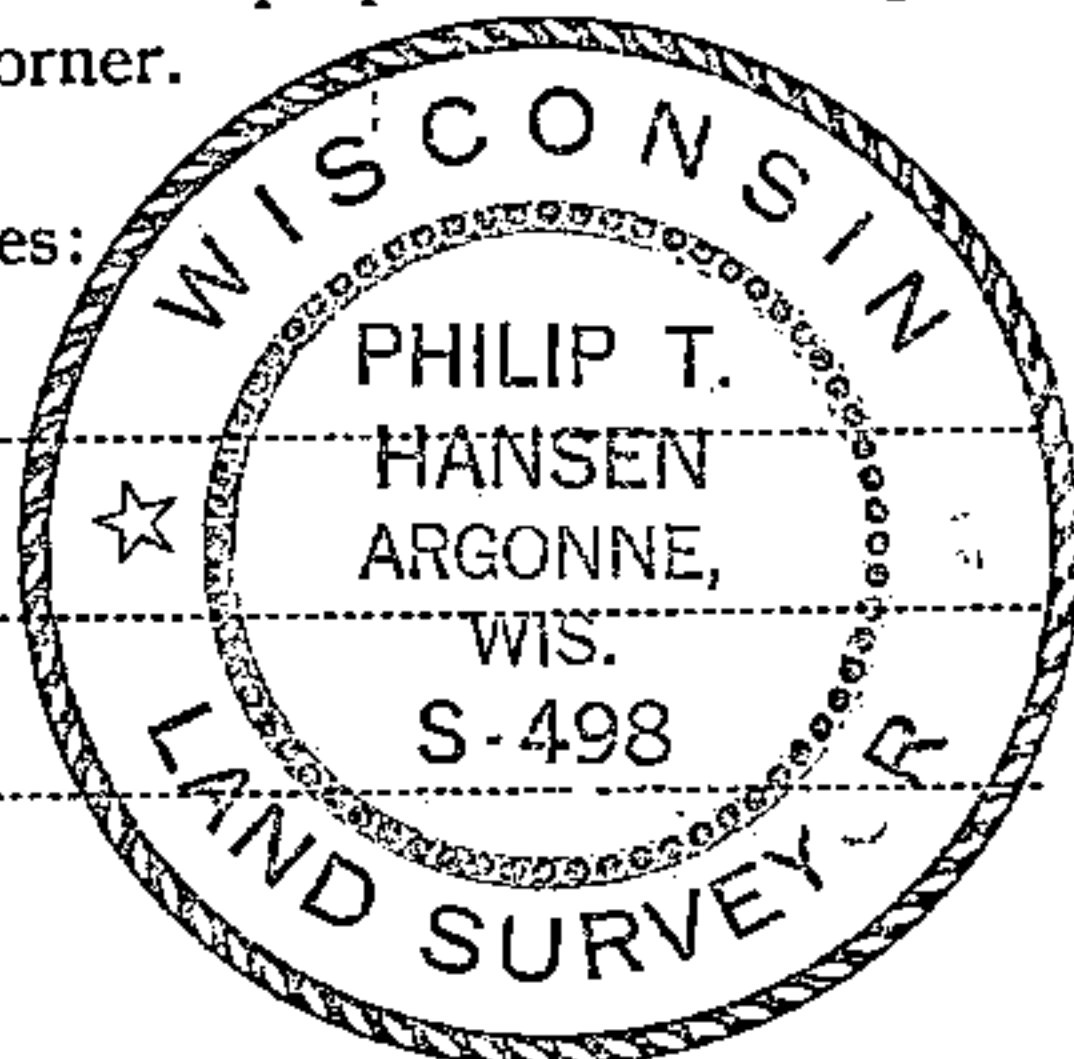

T36N R15E

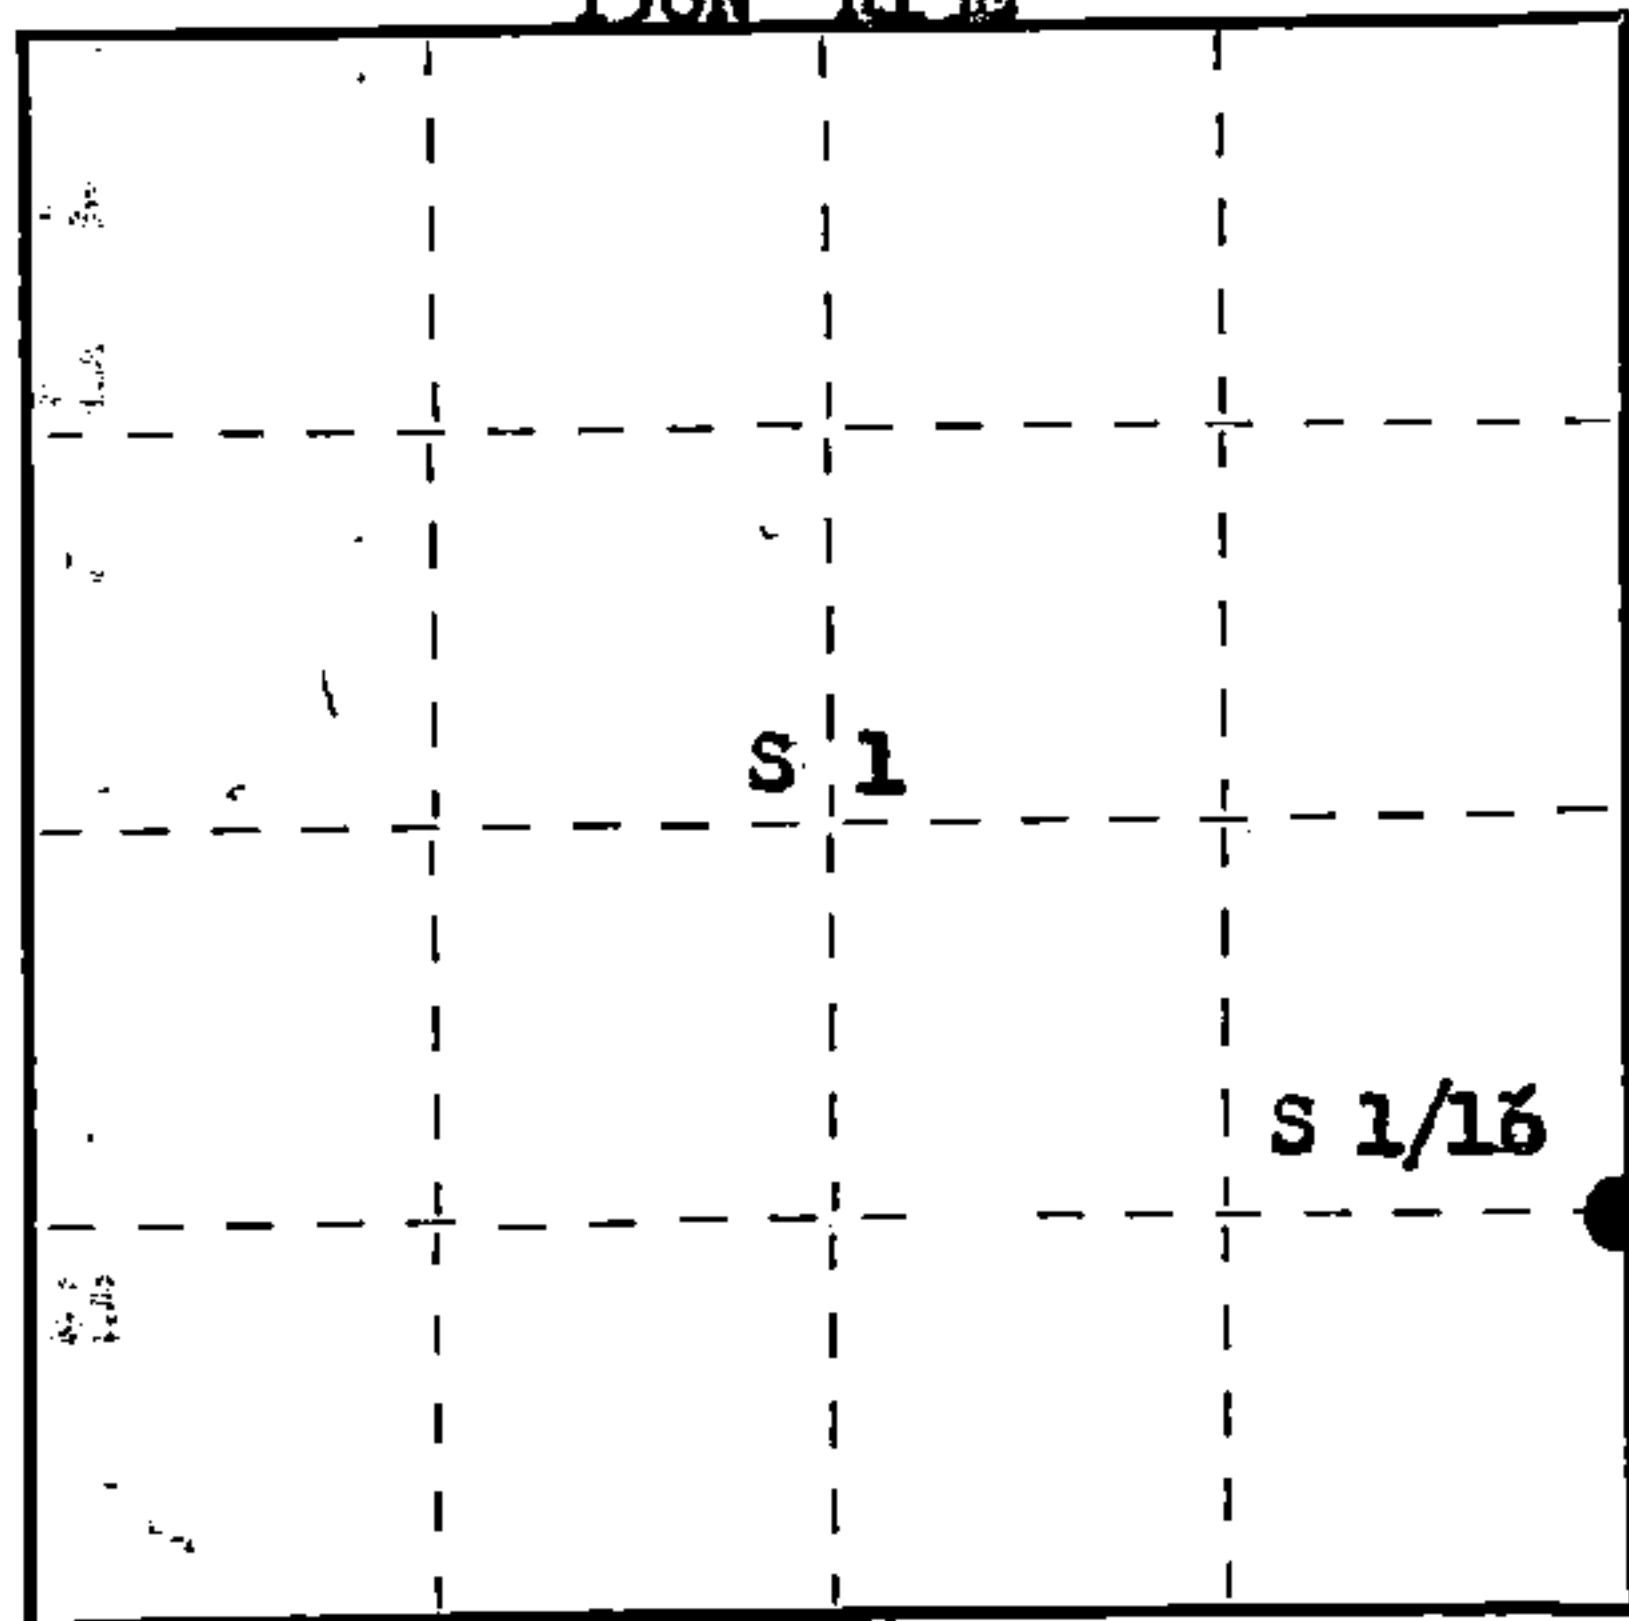

○ = Corner monument restored.

History of original corner establishment:

While running north from recovered Section Corner, found an old 3" squared cedar post, scribed 1/8S. This corner had been accepted by Ray Leigh, Consolidated forester, for many years. Origin of cedar post unknown.

Description of corner evidence found:

Recovered this post in fair condition. The post was still intact with point in ground. No evidence of any BTs were recovered.

Description of monument and accessories I established to perpetuate the original location of this corner.

Replaced cedar post with 1 1/2" iron pipe with 2" brass cap stamped:
Monument projects 24" above ground.

NBTs - Cedar 14" N 19° E 44 links

Cedar 16" N 60° E 57.2 links, scribed 1/16 BT.

S498
T36N
R 15 S 1/16 16
E 16 E
CPI-1976

Dated at Rhineland, Wis., this 3rd day of January, 1977

Signature Philip T. Hansen Title Registered Land Surveyor Registration No. S-498
(County Surveyor, Registered Land Surveyor, or other duly authorized official)

Office of Register of Deeds, County of Forest, I hereby certify that the within instrument was filed in this office for record on the 21st day of January, 1977 at 4:00 o'clock P. M.

Eugene Stutzny
(Register of Deeds)
By _____ Deputy

DOCUMENT NUMBER **110882**

FORM 985 H. C. MILLER CO., MILWAUKEE

4301501000