

CERTIFIED LAND CORNER RESTORATION

Index No. D-2

State of Wisconsin }
County of Forest } ss.


I Philip T. Hansen, do hereby certify that on the 22nd day of September, 1979, I found evidence of the SW 1/16 corner of Section 6 Township 36, North, Range 15 East, Fourth Principal Meridian, as described hereon; and that from this evidence I established a new monument and accessories as described hereon to perpetuate the original location of this corner.

Resident witnesses:


Glen Barker

Jim Claflin

Herb Wagoner

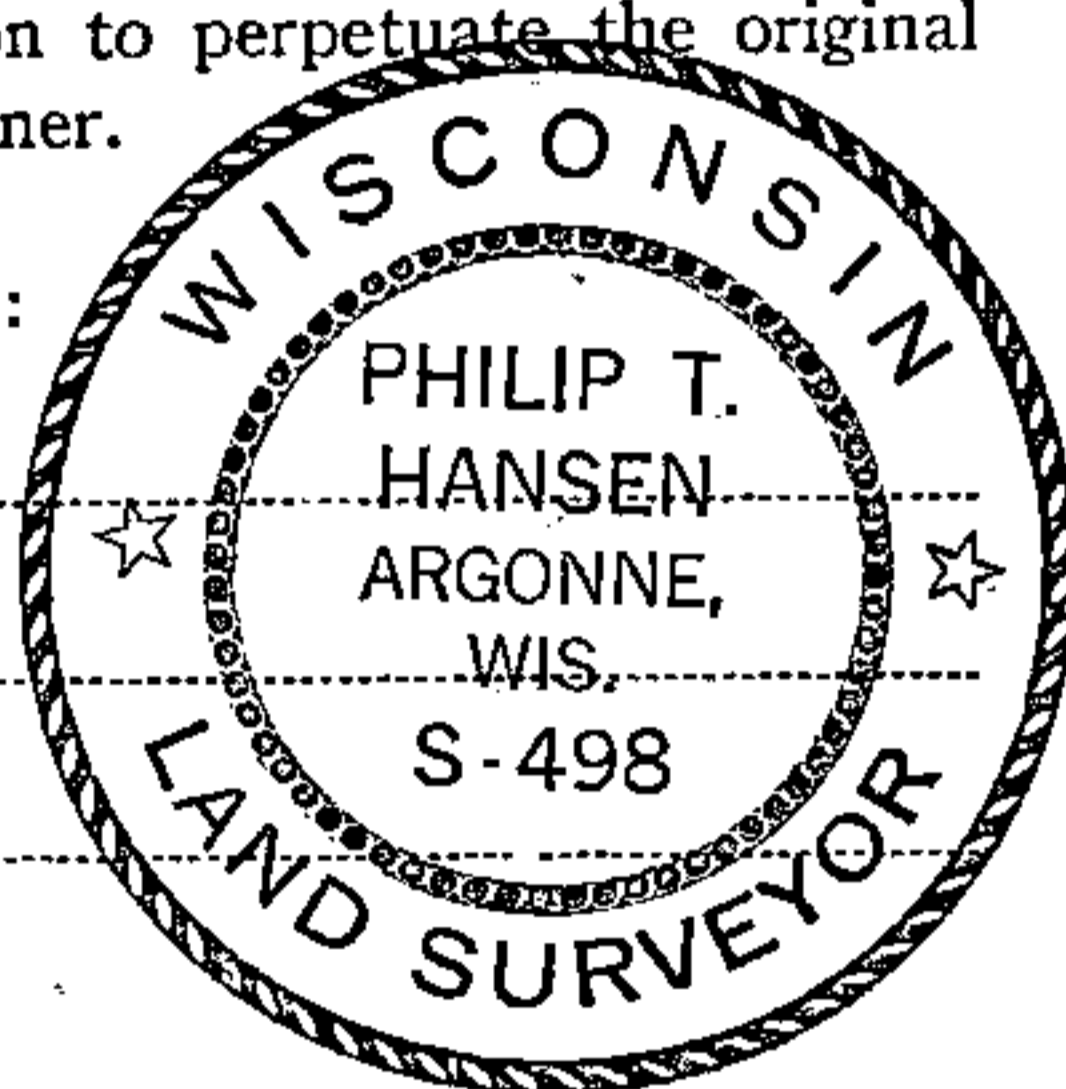

FORM 985 H. C. MILLER CO., MILWAUKEE

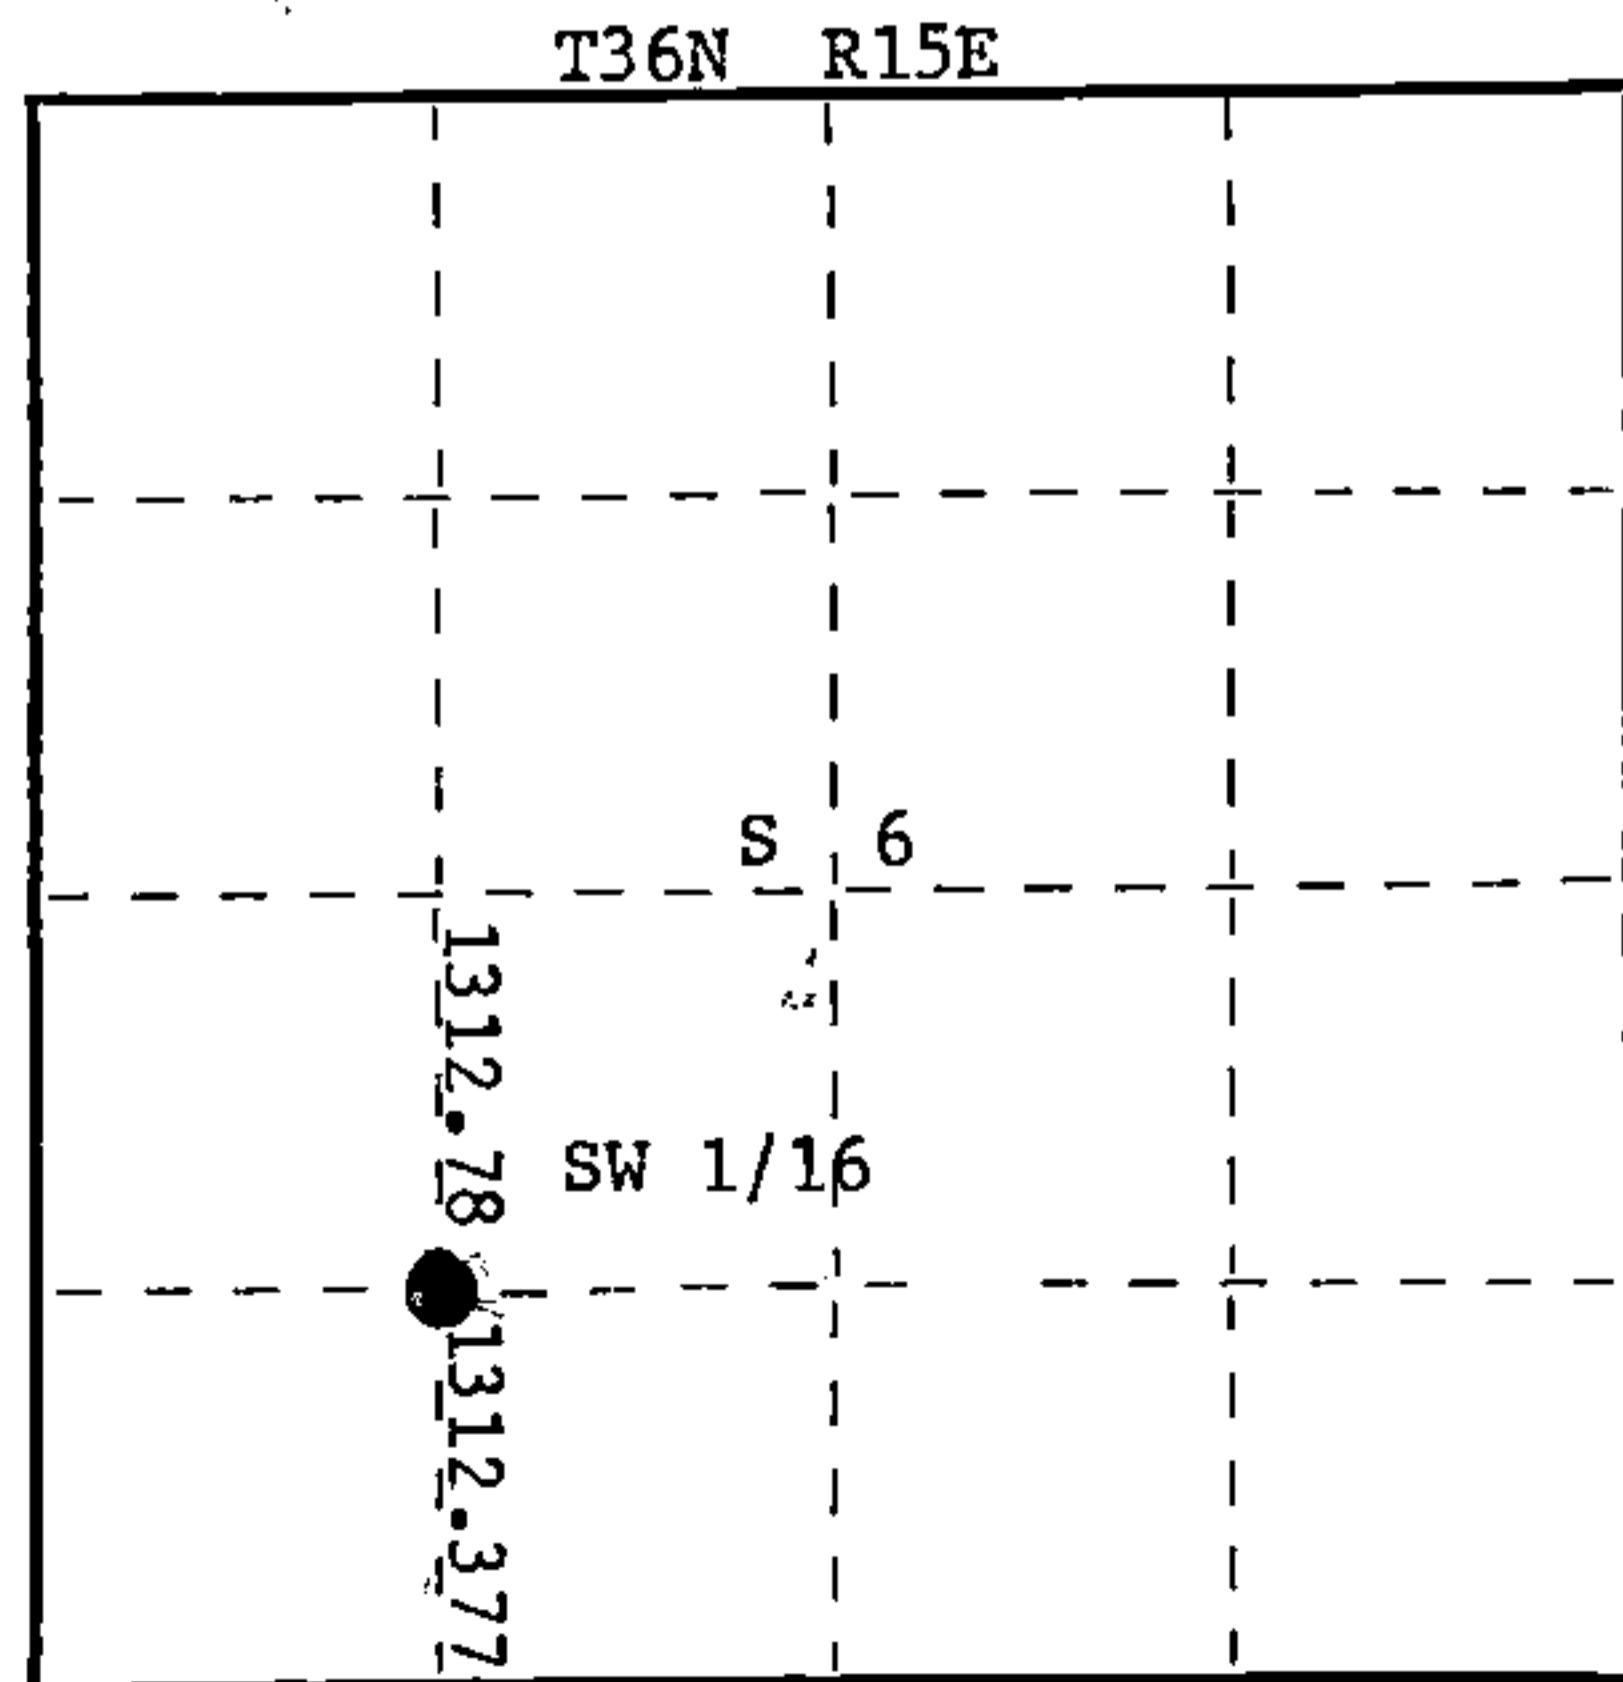

○ = Corner monument restored.

History of original corner establishment:

No records of any surveys available. No evidence of any corner recovered.

Description of corner evidence found:

Corner established by traverse and computation. Computed distance and bearings of traverse from W 1/16 between sections 6 and 7 to WC 1/16, section 6 is 2624.757 feet at bearing N 1° 56' 53" E. Computed location of SW 1/16 is 1312.277 feet of W 1/16 and 1312.38' from WC 1/16.

Description of monument and accessories I established to perpetuate the original location of this corner.

Set a 1-1/2" iron pipe with 2" brass cap, stamped:
Monument projects 24" above ground.

Marked NBT's -

Cedar 5" S69°E 18.95 feet
B.Spruce 5" N27°E 2.98 feet
both scribed 1/16 BT.

S498
T36N R15E
SW 1/16 S+6
CPI-1979

Dated at Rhineland, Wis., this 9th day of October, 1979

Signature Philip T. Hansen Title Registered Land Surveyor Registration No. S-498
(County Surveyor, Registered Land Surveyor, or other duly authorized official)

Office of Register of Deeds, County of Forest, I hereby certify that the within instrument was filed in this office for record on the 13th day of November, 1979 at 8:30 o'clock A. M.

Eugene Stutzman
(Register of Deeds)
By _____ Deputy

DOCUMENT NO. **117090**

4361506 1030