

CERTIFIED LAND CORNER RESTORATION

State of Wisconsin }
County of Forest } ss.

I, Jean F. Resvick, do hereby certify that on the 20th day of August, 1974, I found evidence of the north quarter corner of Section 4 Township 35 North, Range 15 East, Fourth Principal Meridian, as described hereon; and that from this evidence I established a new monument and accessories as described hereon to perpetuate the original location of this corner:

Description of original monument and accessories and subsequent restorations:



Surveyed in 1857 by Artemas Curtis .
40.00 chains west between sections 4 and 33 set post
Hemlock 8, N36E, 41 lks
Sugar 12, S32W, 39 lks

Description of corner evidence found:

4" x 4" squared post with a well point driven in the ground alongside.
From squared post, a hemlock scribed snag, 14", bears N39°E, 45 lks
At a point, S36°W, 41 lks from the hemlock bearing tree snag, a sugar stump bears, S32°W, 39 lks.

Description of monument and accessories I established to perpetuate the location of this corner:

At the corner position as determined from the original evidence found, set a 2 inch inside diameter galvanized pipe 3 ft. long, filled with concrete with a brass cap stamped: T36N, R15E, 1/4, S4, S33, T35N, 1975, S-802.
From which the following new blazed and scribed bearing trees bear:
Hemlock, 10", S50°W, 22.65 feet
Hemlock, 14", N12°W, 35.16 feet
Set a steel sign post 1.0 feet north of the monument.

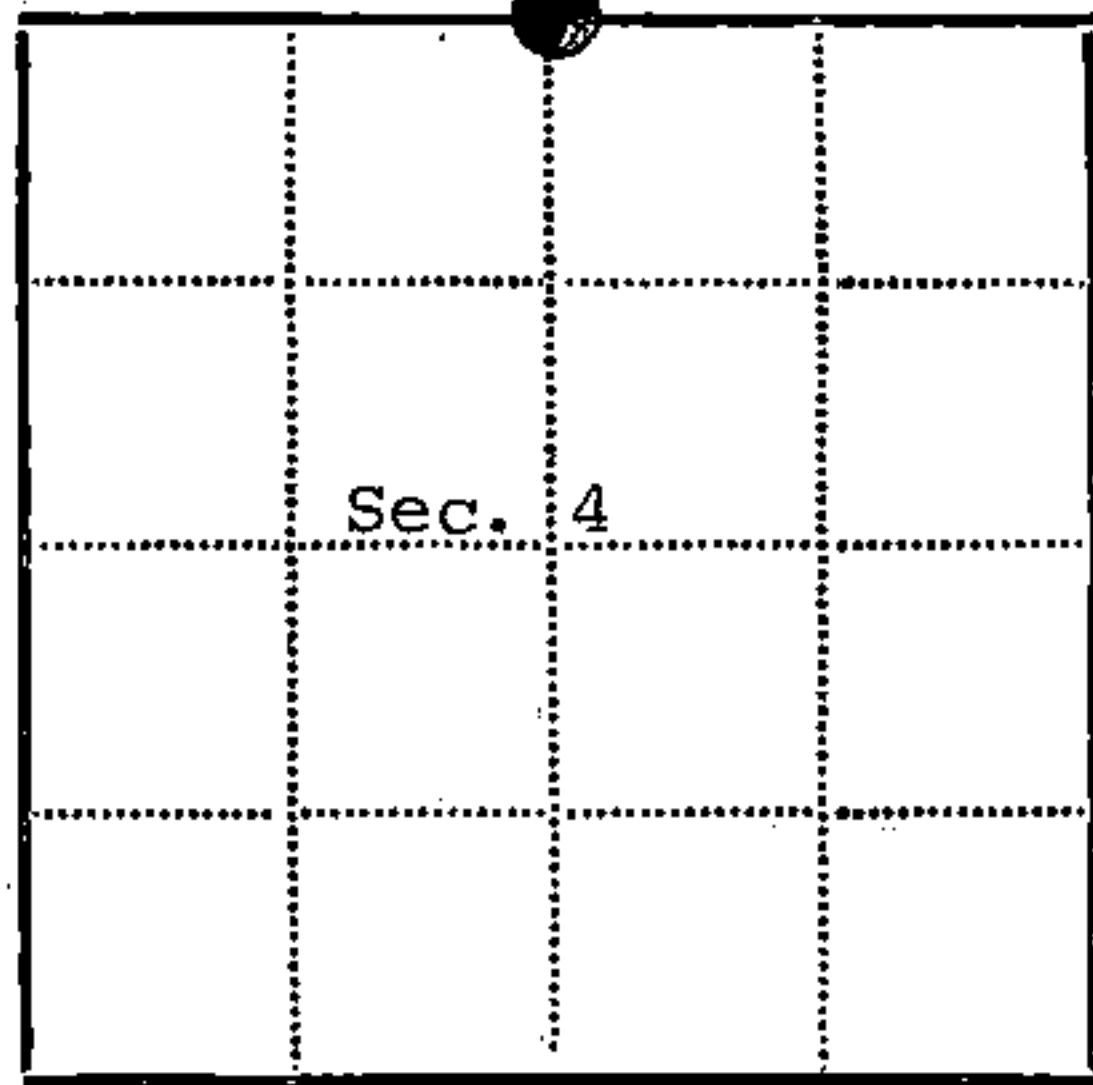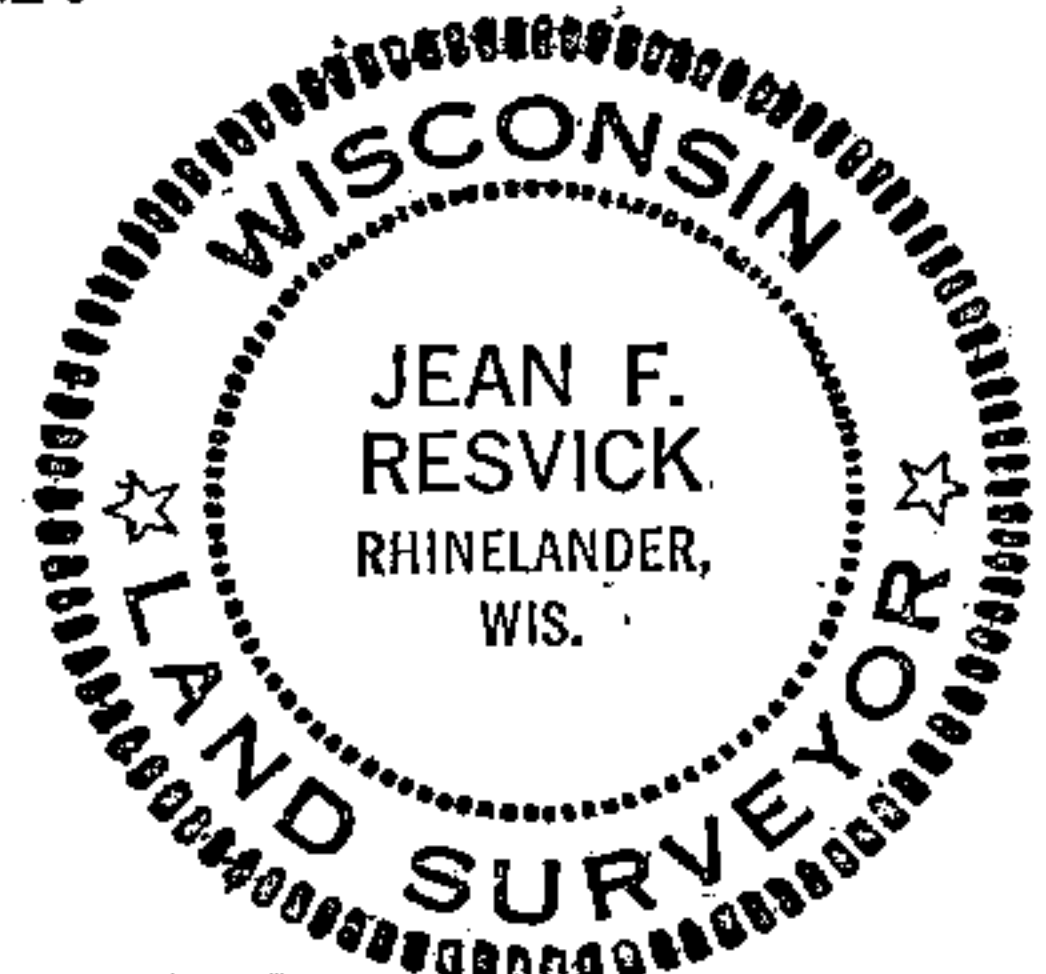

● = Corner monument restored
□ =

Resident witnesses.....

Dated at Rhinelander Wisconsin, this 20 day of March 1975.

Signature Jean F. Resvick Title Land Surveyor
(County Surveyor, Registered Land Surveyor, or other duly authorized official)

Surveyors Registration No. S-802

Office of Register of Deeds County of Forest

I hereby certify that the within instrument was filed in this office for record on the 31st day of March 1975, and was filed in Book No. Corner Page No. A-11 of County Records. Restorations Document Number 106867

Signature Eugene Staszynski Title Register of Deeds

Township 35 North, Range 15 East, Section 4, Index No. A-11, Page No.

A 11