

CERTIFIED LAND CORNER RESTORATION

State of Wisconsin }  
 County of Forest } ss.

I, Milo E. Stefan, do hereby certify that on the 13th day of January, 1983, I found evidence of the North Quarter corner of Section 3 Township 35 North, Range 15 East, Fourth Principal Meridian, as described hereon; and that from this evidence I established a new monument and accessories as described hereon to perpetuate the original location of this corner:

Description of original monument and accessories and subsequent restorations:

Surveyed in 1859 by Artemas Curtis  
 40.00 chains, set wood post  
 Cedar, 15", N22°E, 45 lks.  
 Hemlock, 12", S37°W, 29 lks.


Description of corner evidence found:

Hemlock stump remains, S37°W, 19.5'  
 Cedar windfall, N22°E, 29.6'  
 Local Evidence: 6" x 6" x 5' Cedar post with 2" iron pipe in mound of stone  
 Hemlock, 10", N17°W, 17.1'  
 Fir, 6", S29°W, 7.6'  
 Yellow Birch with location poster (874-9)

Description of monument and accessories I established to perpetuate the location of this corner:

Replaced iron pipe and Cedar post with a 2" x 60" aluminum monument in mound of stone with tablet stamped as follows:  
 T36N, R15E, 1/4, S34, S3, T35N, 1983, RLS-1558  
 From which the following bear:  
 Yellow Birch, 7", N66°E, 23.44'  
 Hemlock, 14", S7°E, 16.56'  
 Hemlock, 12", N22°W, 16.61'  
 Steel Sign Post, 7', South, 1.8'

DOCUMENT NO.  
 124182

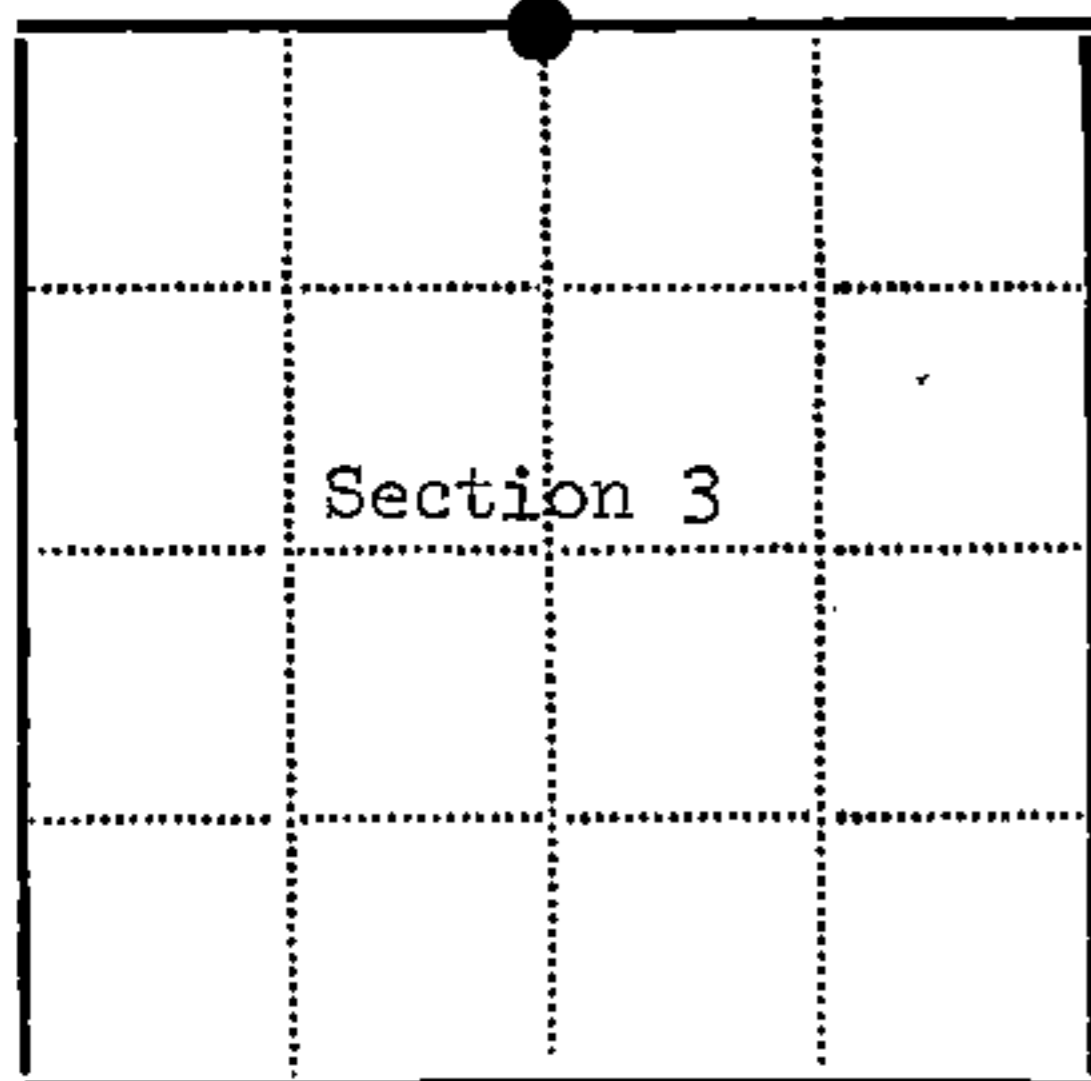

● - Corner monument restored  
 □ -

Resident witnesses.....

Dated at Rhinelander, Wisconsin, this 2 day of MAY, 1983.

Signature Milo E. Stefan Title Land Surveyor  
 (County Surveyor, Registered Land Surveyor, or other duly authorized official)

Surveyors Registration No. RLS-1558

Office of Register of Deeds County of Forest

I hereby certify that the within instrument was filed in this office for record on the 12th day of September, 1983, and was filed in Book No. .... Page No. .... of County Records.

Signature Eugene Stratney Title Register of Deeds

Township 35 North, Range 15 East, Section 3, Index No. A-15, Page No. 21

A 15