

CERTIFIED LAND CORNER RESTORATION

State of Wisconsin }
County of Forest } ss.

I, Milo E. Stefan, do hereby certify that on the 10th day of September, 1981, I found evidence of the Northwest corner of Section 11 Township 36 North, Range 16 East, Fourth Principal Meridian, as described hereon; and that from this evidence I established a new monument and accessories as described hereon to perpetuate the original location of this corner:

Description of original monument and accessories and subsequent restorations:
Surveyed in 1858 by James McBride 80.00 chains, set wood post Hemlock, 20", N3W, 57 lks.
Hemlock, 16", N54E, 28 lks.
Sugar, 12", S79E, 30 lks.
Hemlock, 12", S78W, 31 lks.
Surveyed in October, 1927, by Goodman Lumber Co. Placed 2" iron flue pipe alongside ironwood post. Area recently burnt, no BTs remain.


Description of corner evidence found:

Accepted iron pipe as best remaining evidence, as it was used by Goodman and the Forest Service for many years.

Description of monument and accessories I established to perpetuate the location of this corner:

Replaced flue pipe with a 2" x 30" aluminum pipe in mound of stone with tablet stamped as follows:
T36N, R16E, S3, S2, S10, S11, 1981, RLS-1558
From which the following bear:
S. Maple, 6", N24E, 40.58 feet
Y. Birch, 6", S25E, 33.35 feet
S. Maple, 6", S69W, 16.91 feet
S. Maple, 8", N60W, 30.93 feet
Set a steel sign post Northwest 2.3 feet

DOCUMENT NO.
124218

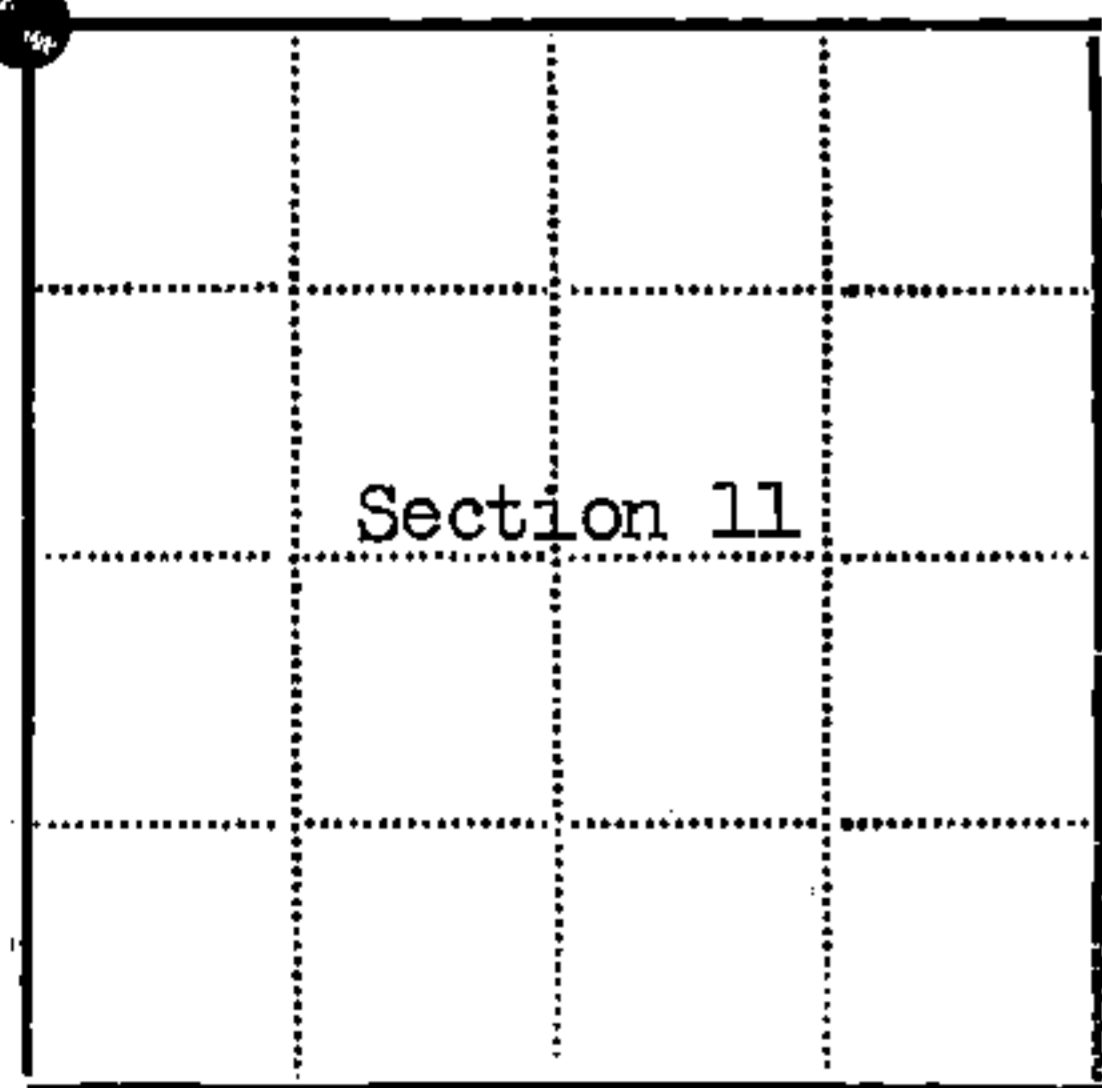

● - Corner monument restored
□ -

Resident witnesses.....

Dated at Rhinelander Wisconsin, this 4 day of MARCH 1982.

Signature Milo E. Stefan Title Land Surveyor
(County Surveyor, Registered Land Surveyor, or other duly authorized official)

Surveyors Registration No. RLS-1558

Office of Register of Deeds County of Forest

I hereby certify that the within instrument was filed in this office for record on the 14th day of September 1983, and was filed in Book No. Page No. of County Records.

Signature Eugene Steyry Title Register of Deeds

Township 36 North, Range 16 East, Section 11, Index No. E-17, Page No. 47

43616030000

3
17