

CERTIFIED LAND CORNER RESTORATION

State of Wisconsin }
County of Forest } ss.

I Milo E. Stefan, do hereby certify that on the 29th day of July, 1982, I found evidence of the East Quarter corner of Section 14 Township 36 North, Range 16 East, Fourth Principal Meridian, as described hereon; and that from this evidence I established a new monument and accessories as described hereon to perpetuate the original location of this corner:

Description of original monument and accessories and subsequent restorations:

Surveyed in 1858 by James McBride
40.00 chains, set wood post
Birch, 18", S41°E, 25 lks., 16.50 feet
Fir, 8", N71°W, 16 lks., 10.56 feet

Description of corner evidence found:

No original evidence found
Local Evidence: Found 2 1/2 foot flue pipe, as set by Goodman Lumber Company in 1926.


Description of monument and accessories I established to perpetuate the location of this corner:

Replaced flue pipe with a 2" x 36" aluminum monument in mound of stone with tablet stamped as follows:
T36N, R16E, S14, 1/4, S13, 1982, RLS-1558
From which the following bear:
Black Cherry, 6", N55°E, 29.23 feet
Black Cherry, 6", S2°W, 23.70 feet
White Spruce, 6", N23°W, 36.11 feet
Steel Sign Post, North, 3.90 feet



DOCUMENT NO.
124223

4361614 zppp

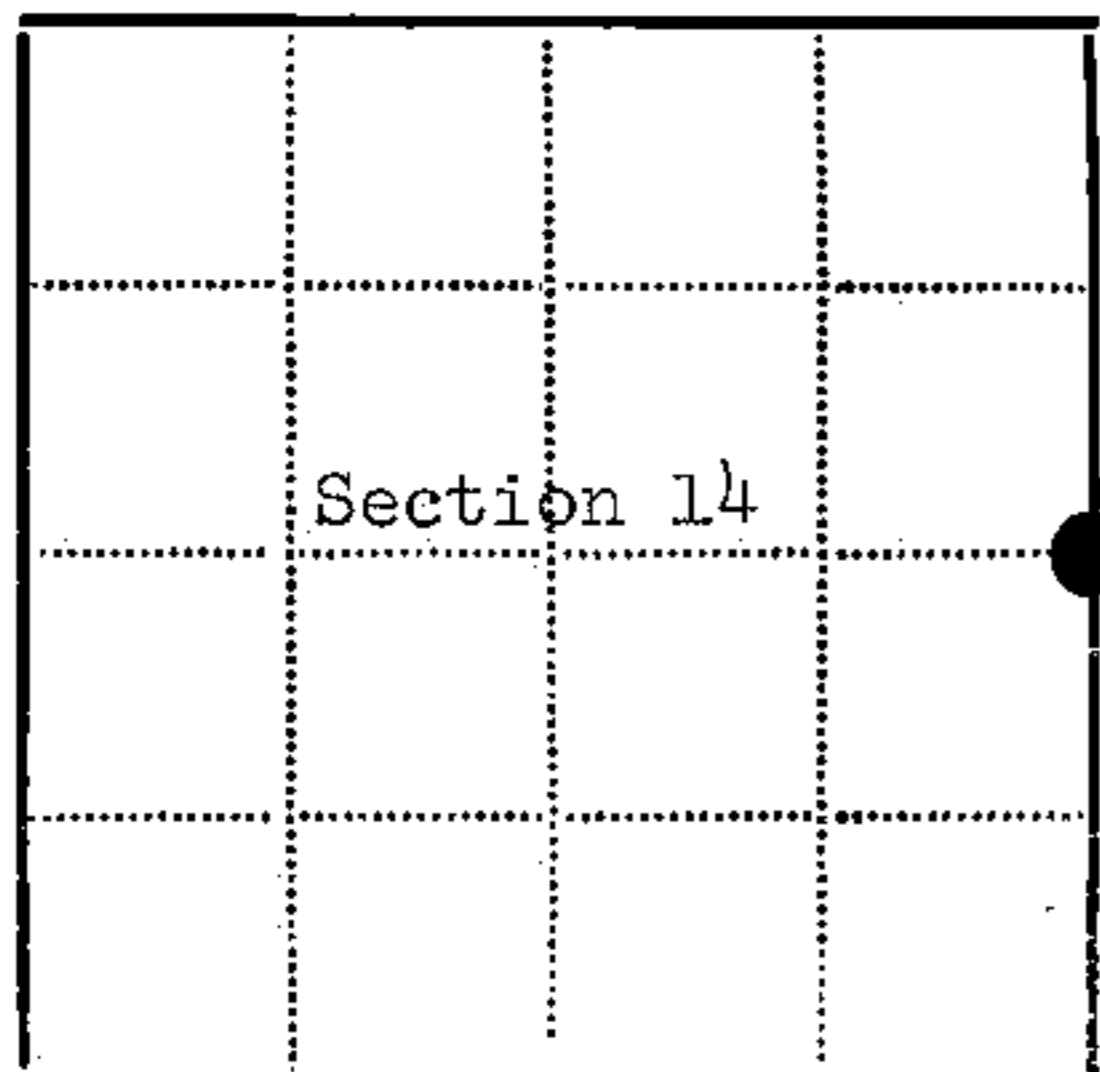

● - Corner monument restored
□ -

Resident witnesses.....

Dated at Rhinelander Wisconsin, this 29th day of July, 1982.

Signature Milo E. Stefan Title Land Surveyor
(County Surveyor, Registered Land Surveyor, or other duly authorized official)

Surveyors Registration No. RLS-1558

Office of Register of Deeds County of Forest

I hereby certify that the within instrument was filed in this office for record on the 14th day of September, 1983, and was filed in Book No. Page No. of County Records.

Signature Eugene Statyons Title Register of Deeds

Township 36 North, Range 16 East, Section 14, Index No. L-21, Page No. 6

U.S. PUBLIC LAND SURVEY MONUMENT RECORD

Index No. L-21

State of Wisconsin }
County of Forest } ss.

I, Gary L. Pisoni, do hereby certify that on the 4th day of April, 1994, I found evidence of the West Quarter corner of Section 13 Township 36, North, Range 16 East, Fourth Principal Meridian, as described hereon; and that from this evidence I established a new monument and accessories as described hereon to perpetuate the original location of this corner.

Resident witnesses:

.....
.....
.....

History of original corner establishment:

Original Government Survey in 1858 by James McBride. North between Sections 13 and 14, at 40.00 chains, set Quarter Section post from which the following bear: Birch, 18" S 41° E, 25 lks; Fir, 8", N 71° W, 16 lks.

In 1982, Milo E. Stefan, RLS, with the Forest Service found a 2 1/4' flue pipe set by Goodman Lumber Company in 1926, no original evidence found. Replaced flue pipe with an aluminum capped pipe monument and blazed and scribed the following B.T.s:

Black Cherry	6"	N 55° E	29.23 feet	Black Cherry	6"	S 02° W	23.70'
White Spruce	6"	N 23° W	36.11 feet	Steel sign post		North	3.90'

Description of corner evidence found:


Found the monument and bearing trees as described above:

Black Cherry	8"	S 02° W	23.70 feet
White Spruce	9"	N 23° W	36.11 feet

Description of monument and accessories I established to perpetuate the original location of this corner.

Blazed and scribed the following new bearing trees: (Measurements taken to a nail in side of tree)

Elm	6"	N 64° E	12.28 feet
Black Cherry	7"	N 71° W	18.93 feet

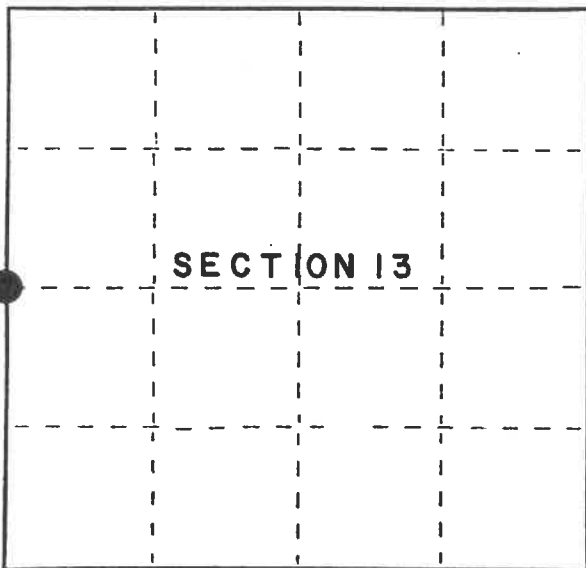

● = Corner monument restored.

Dated at Iron River, MI, this 26th day of May, 1995

Signature Gary L. Pisoni Title Land Surveyor Registration No. S-1634
(County Surveyor, Registered Land Surveyor, or other duly authorized official)

Office of Register of Deeds, County of Forest, I hereby certify that the within instrument was filed in this office for record on the 10th day of March, 1997 at 1:30 o'clock P M.

(Register of Deeds)

By John Tombury Deputy

FORM NO. 985-A



Stock No. 26273

158117

H3016142000

