

U.S. PUBLIC LAND SURVEY MONUMENT RECORD


Index No. E-5

State of Wisconsin }
County of FOREST } ss.

I, John C. Schulke, do hereby certify that on the third day of September, 1986, I found evidence of the Northwest Section corner of Section 8 Township thirty-seven, North, Range twelve East, Fourth Principal Meridian, as described hereon; and that from this evidence I established a new monument and accessories as described hereon to perpetuate the original location of this corner.

Resident witnesses:

.....
.....
.....

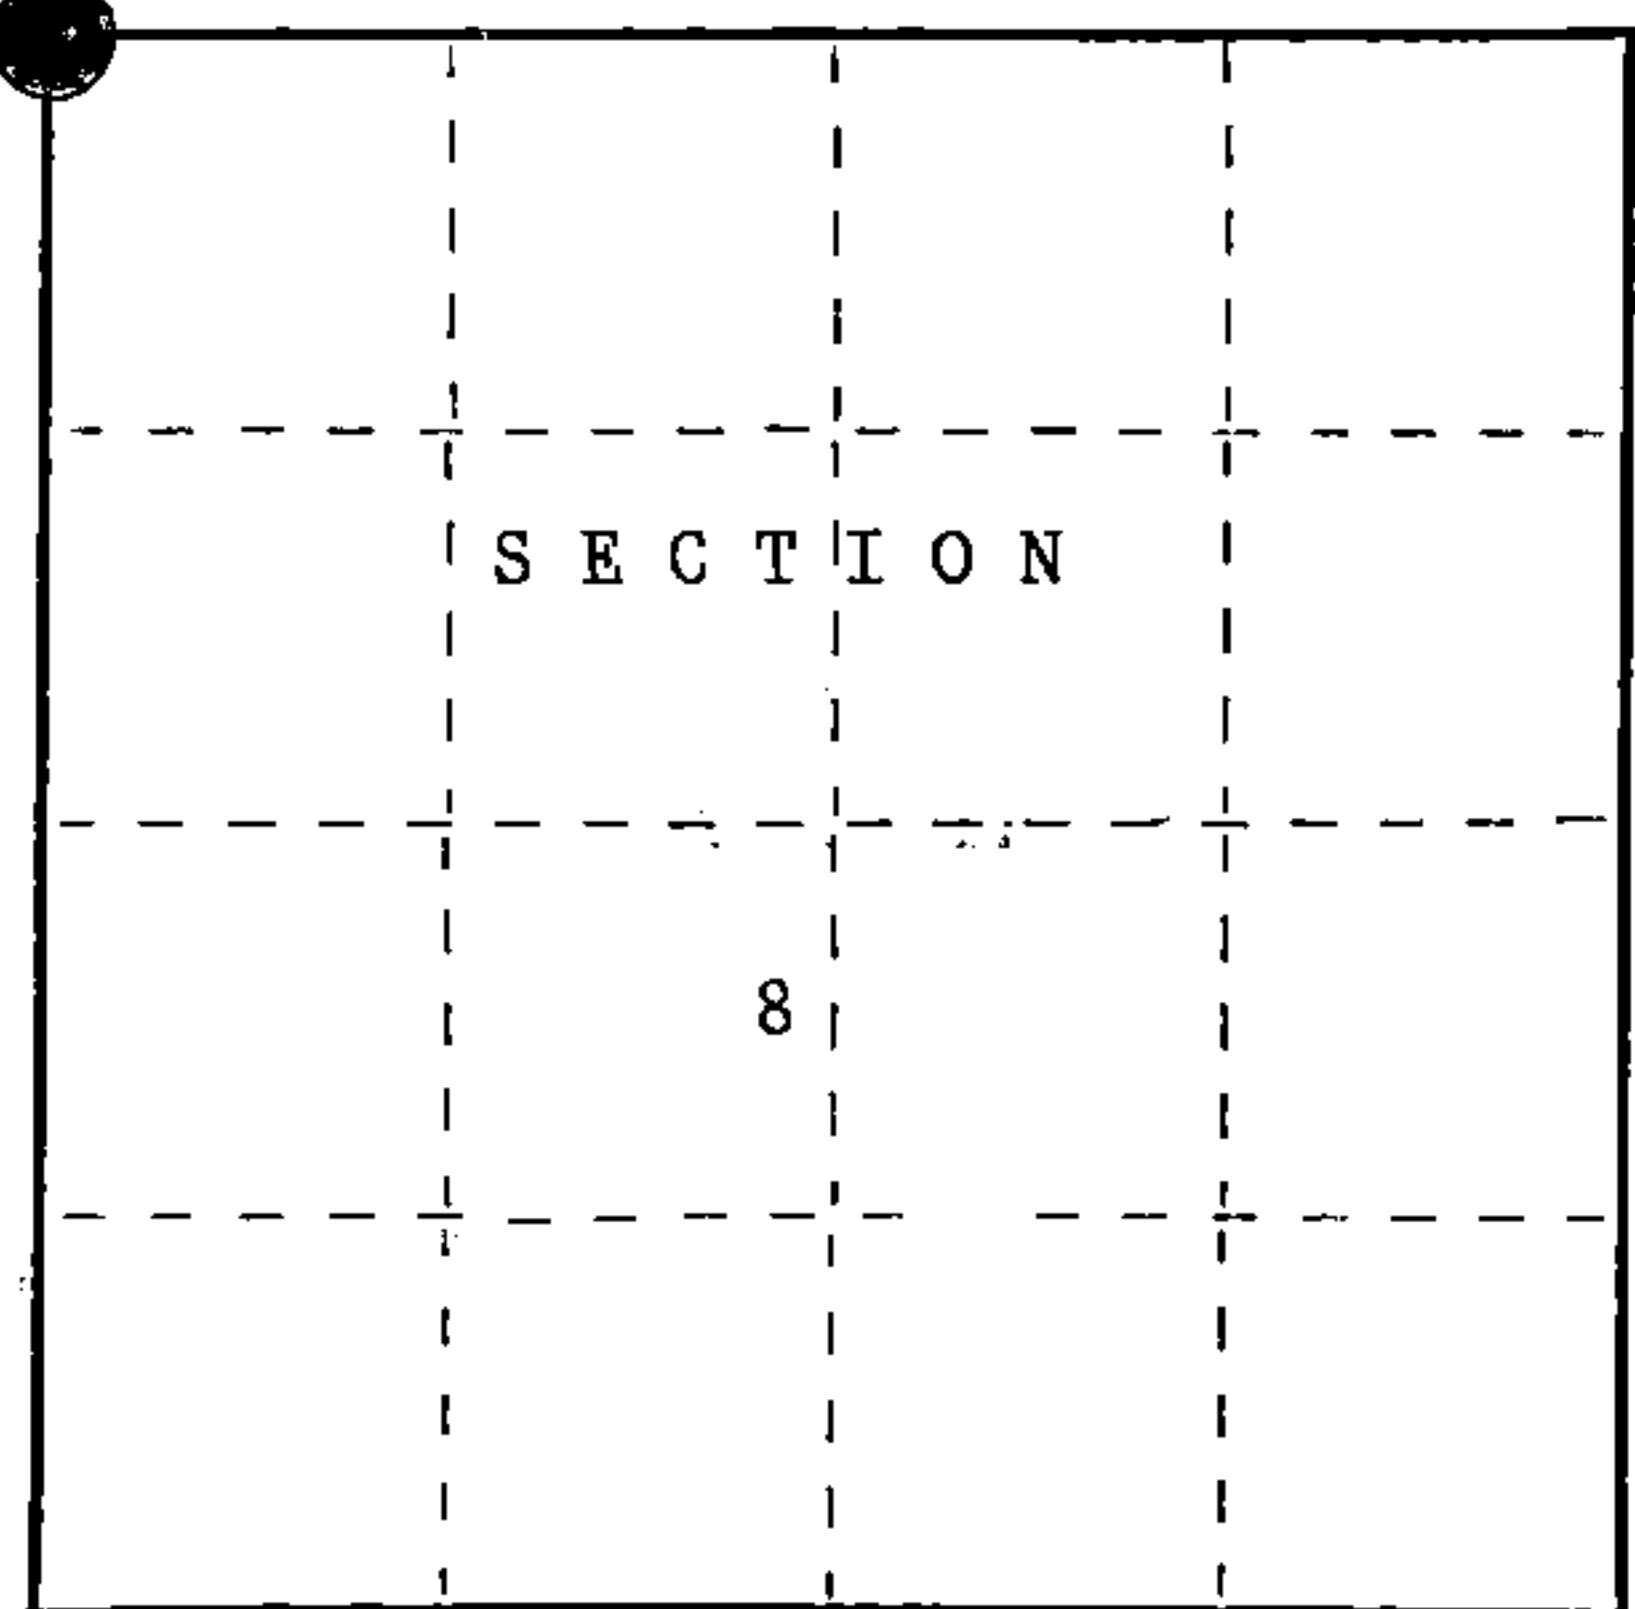

○ = Corner monument restored.

History of original corner establishment:

Original corner established in 1859 by William Daugherty, U.S. Deputy Surveyor.

Set a wooden post with the following bearing trees:

Tamarack 12" S67°W 26 lks.
Tamarack 9" N19°E 15 lks.

Description of corner evidence found:

Found Tamarack with blaze on Southeast side.

Description of monument and accessories I established to perpetuate the original location of this corner.

Set 2 1/2" diameter aluminum pipe monument, 5 feet long, 4 feet in the ground with an aluminum cap stamped; T37N, R12E, S5, S6, S7, S8, 1986, S-1665. Set a steel sign post South a distance of 1 foot. No bearing trees available since the corner falls in an open swamp.

Dated at Hiles, Wisconsin, Wis., this Eleventh day of November, 1987

Signature: John C. Schulke Title Land Surveyor Registration No S-1665
(County Surveyor, Registered Land Surveyor, or other duly authorized official)

Office of Register of Deeds, County of Forest, I hereby certify that the within instrument was filed in this office for record on the 2nd day of February, 1988 at 9:40 o'clock A. M.

Paul Achenbrenner
(Register of Deeds)

By.....Deputy

FORM NO. 985-A

H.C. Miller Company
MILWAUKEE, WISCONSIN

Stock No. 26273

DOCUMENT NUMBER 134565

21-11-87
43712060000

(e) Describe any material discrepancy between the location of the corner as restored or reestablished and the location of that corner as previously restored or reestablished by distance and direction. Show the discrepancy on the plan view drawing under (d), above. Show the distances between the corner as previously restored or reestablished and (1) the corner as restored or reestablished, and (2) to at least 2 of the witness monuments shown on the drawing in (d), above.


No discrepancy.

(f) Was the corner restored through acceptance of (1) an obliterated evidence location, or, (2) a found perpetuated location?

The corner restored through acceptance of an obliterated evidence location. The railroad records were used to restore the position of the corner.

(g&h) Was the corner reestablished through lost corner proportionate methods? If so, show the method, including the directions and distances to other public land survey corners used as evidence or used for proportioning in determining the corner location?

No. There are no available living bearing trees as the area had been flooded by beavers.

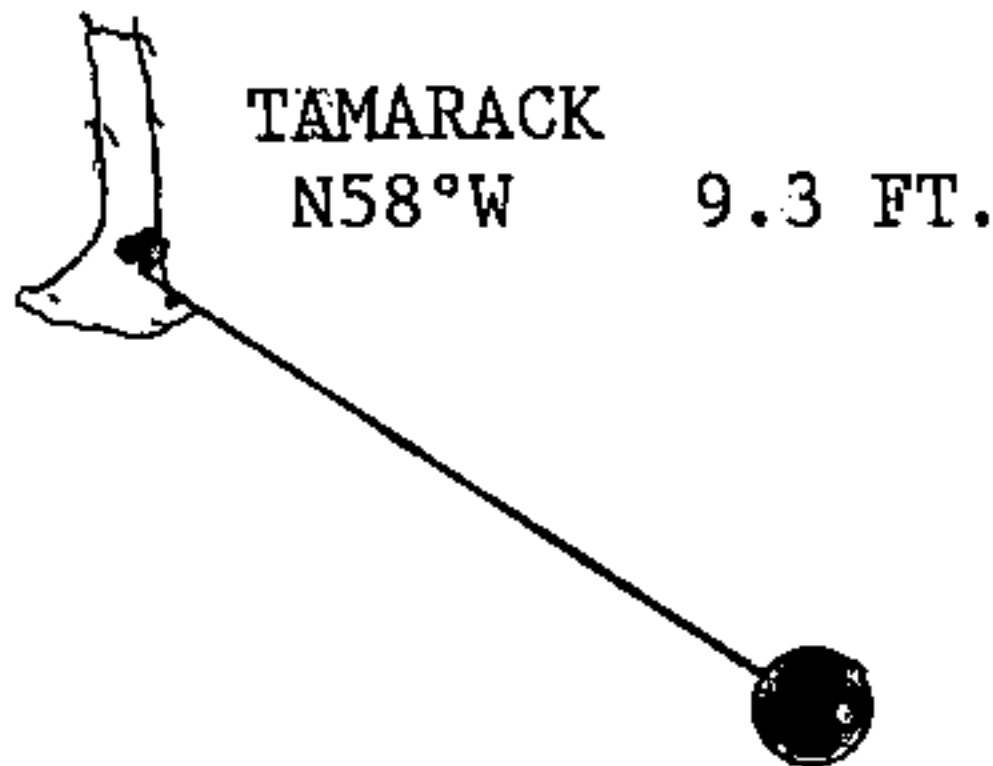

SECTION CORNER

S6		S5
S7	+	S8



(i) 1. John C. Schulke
[type or print name] certify that the corner location shown on this record was determined by me or under my direction and control and that this U.S. Public Land Survey Monument Record is correct and complete to the best of my knowledge and belief.

John C. Schulke Signature Nov 11, 1987 Date

Survey requested by: Dale Ortega District Ranger 2/1/88 Date