

U.S. PUBLIC LAND SURVEY MONUMENT RECORD


Index No. G-21

State of Wisconsin }
County of FOREST } ss.

I, John Schulke, do hereby certify that on the 15th day of August, 1989, I found evidence of the East Quarter corner of Section 11 Township 37 North, Range 12 East, Fourth Principal Meridian, as described hereon; and that from this evidence I established a new monument and accessories as described hereon to perpetuate the original location of this corner.

Resident witnesses:

Al Tauer
Roman Tauer
John Tauer

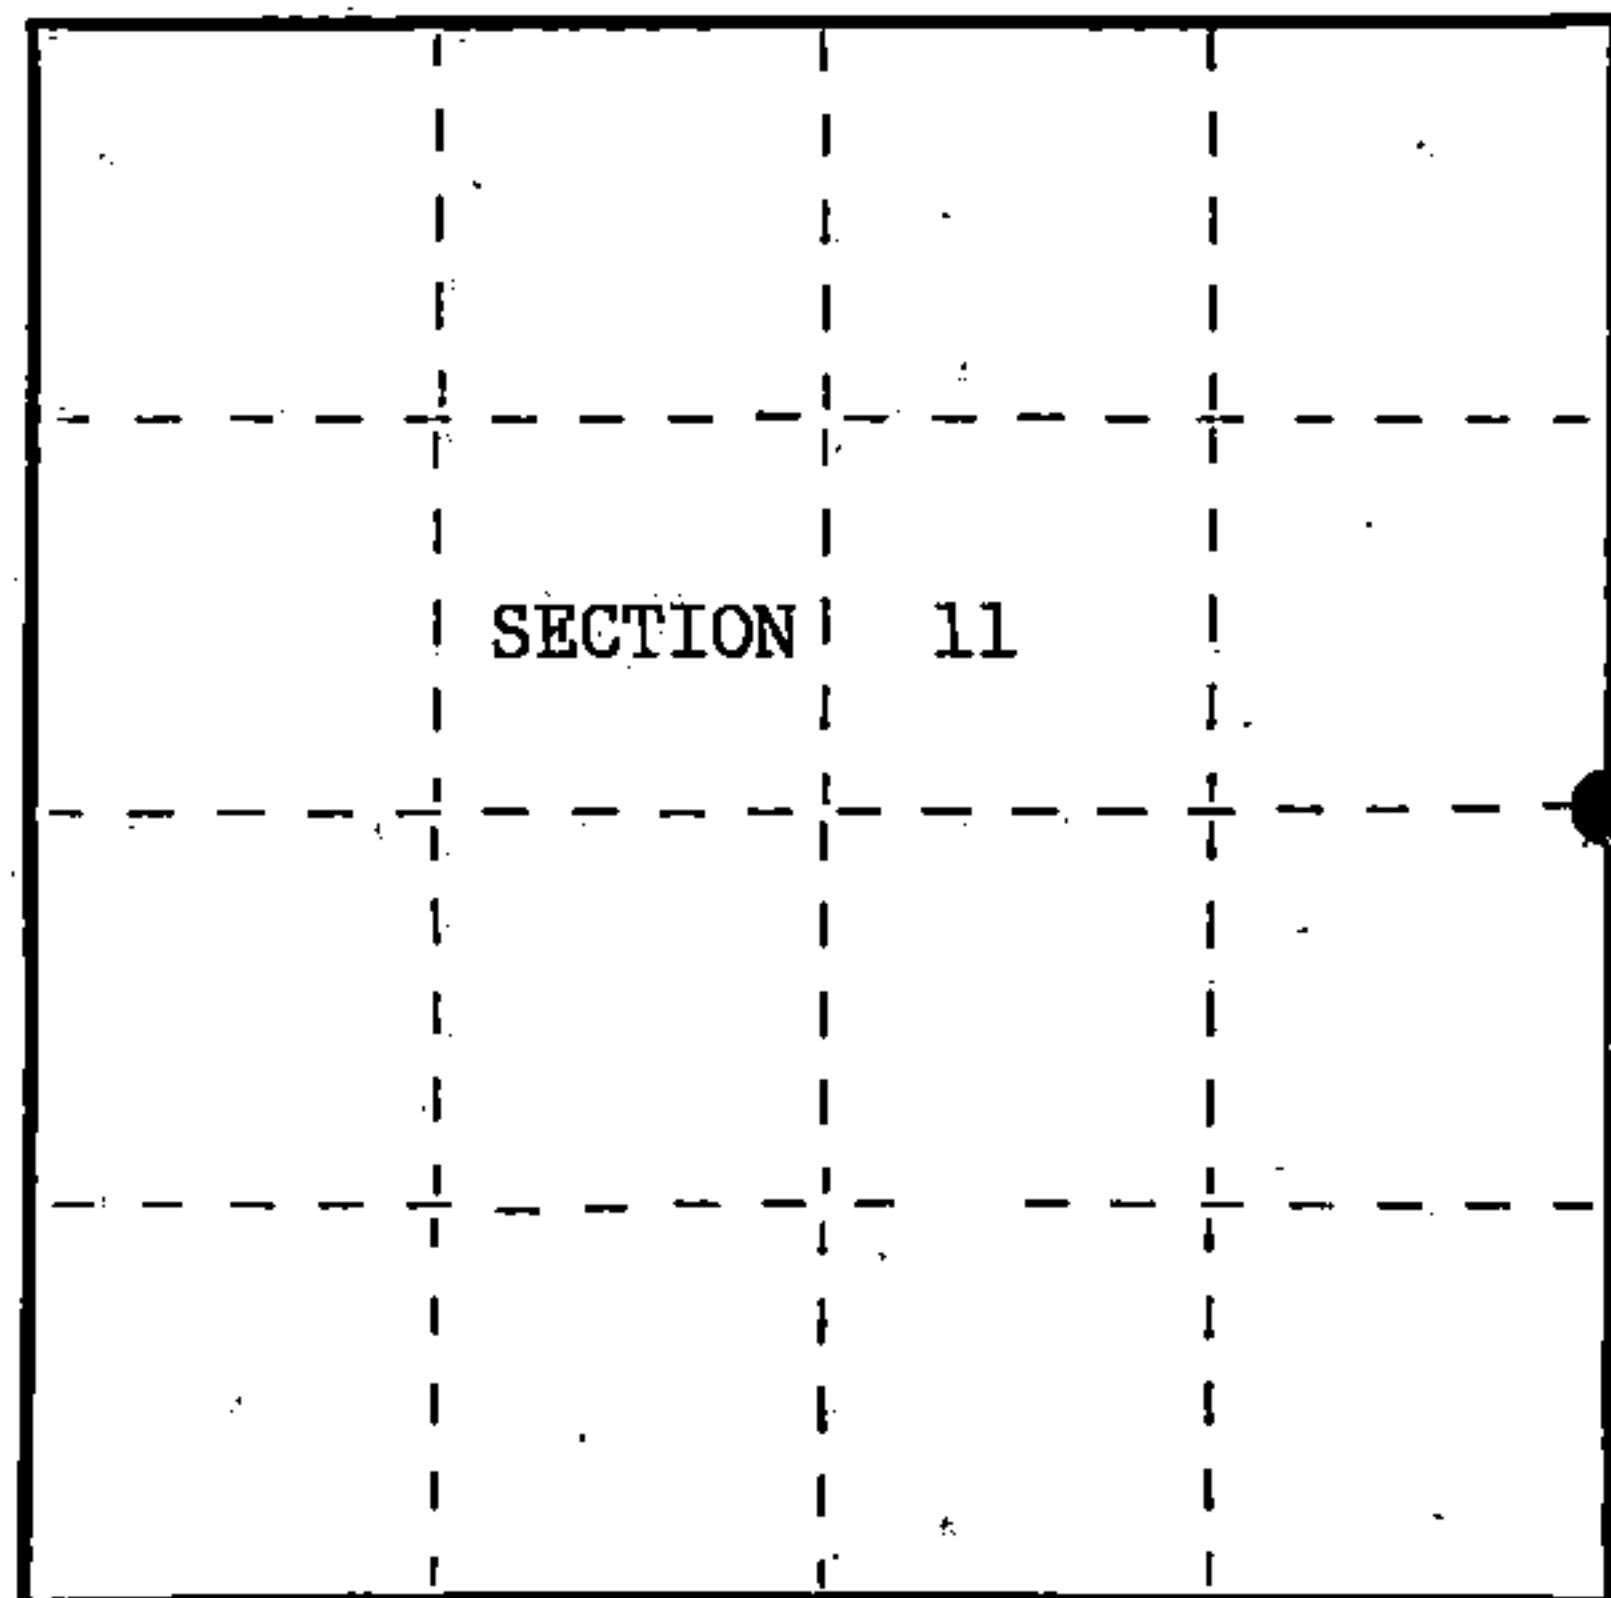

● = Corner monument restored.

History of original corner establishment:

In 1859, Original Government Surveyed by Wm. E. Daugherty. Set a wood post with the following corner references: Hemlock 10" S70°E 24 lks. Lind 10" S40°W 34 lks.

In 1931, S.M. Battell recovered a 38" dia. Hemlock stump. Placed a Metal Location Poster on a 2" dia. Aspen tree bearing S30°W. Corner at the end of town road running East and West through Section 11.

Description of corner evidence found:

Found no original evidence. Forest Service road running East and West had been recently improved. Resident witnesses stated original corner had been located on the North edge of road on West edge of a Spruce plantation. I accepted this as being the best available evidence of the corner position.

Description of monument and accessories I established to perpetuate the original location of this corner.

Set a 2 1/2" dia. X 36" aluminum magnetic cap monument stamped to identify the corner. Set a steel sign post 14.4 ft. North of the monument. Monument is 0.9 ft. below the surface of the ground. Center line of the Forest Road #2391, runs East and West, bears South a distance of 5.5 ft. from the monument.

The following corner references:

Spruce 15" N17°E 32.72 ft.
Spruce 11" S31°E 32.57 ft.
Twin Sug. Maple 12" S44°W 42.43 ft.
Sug. Maple 13" N50°W 43.04 ft.

Dated at Wabeno, Wis., this 25th day of October, 1989.

Signature John C. Schulke Title Register Land Surveyor Registration No. S-1665
(County Surveyor, Registered Land Surveyor, or other duly authorized official)

Office of Register of Deeds, County of Forest, I hereby certify that the within instrument was filed in this office for record on the 8th day of March, 1990 at 1:00 o'clock P.M.

Paul Schentzner
(Register of Deeds)

By Deputy

FORM NO. 985-A

H.C. Miller Company

Stock No. 26273

DOCUMENT NUMBER

139255

43712112000

e) Describe any material discrepancy between the location of the corner as restored or reestablished and the location of that corner as previously restored or reestablished by distance and direction. Show the discrepancy on the plan view drawing under (d), above. Show the distances between the corner as previously restored or reestablished and (1) the corner as restored or reestablished, and (2) to at least 2 of the witness monuments shown on the drawing in (d), above.


No.

(f) Was the corner restored through acceptance of (1) an obliterated evidence location, or, (2) a found perpetuated location?


(1) an obliterated evidence location.

(g&h) Was the corner reestablished through lost corner proportionate methods? If so, show the method, including the directions and distances to other public land survey corners used as evidence or used for proportioning in determining the corner location?

No.

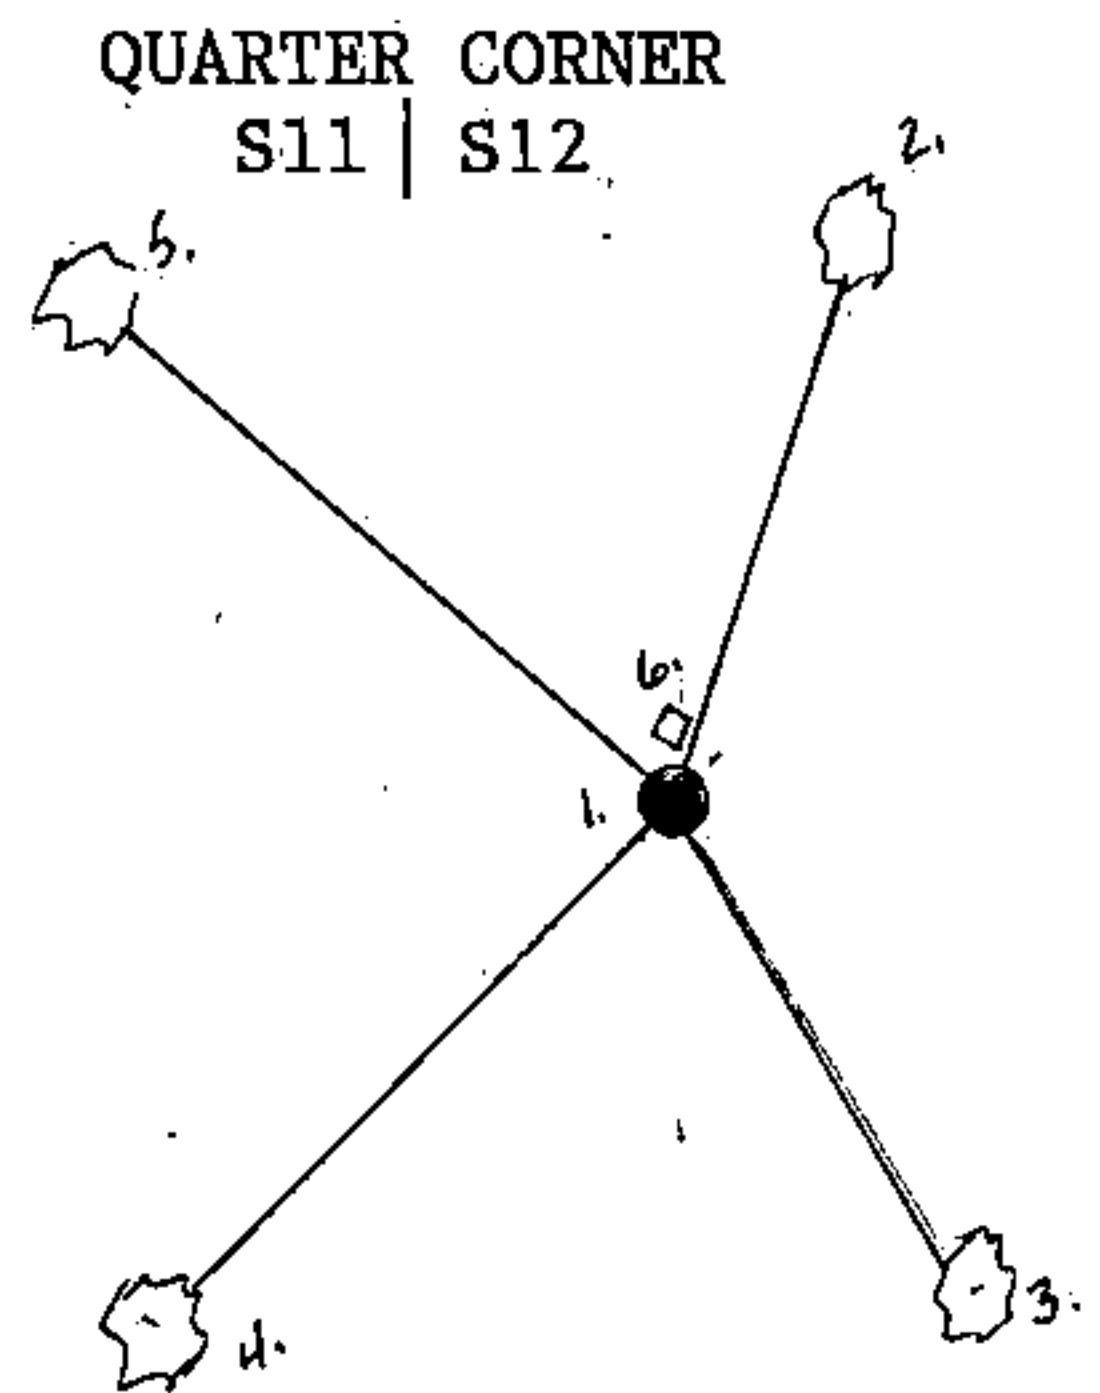

1. 2 1/2" X 36" aluminum monument
2. Spruce 15" N17°E 32.72 ft.
3. Spruce 11" S31°E 32.57 ft.
4. Twin Sug. Maple 12" S44°W 42.43 ft.
5. Sugar Maple 13" N50°W 43.04 ft.
6. Steel sign post North 14.4 ft.

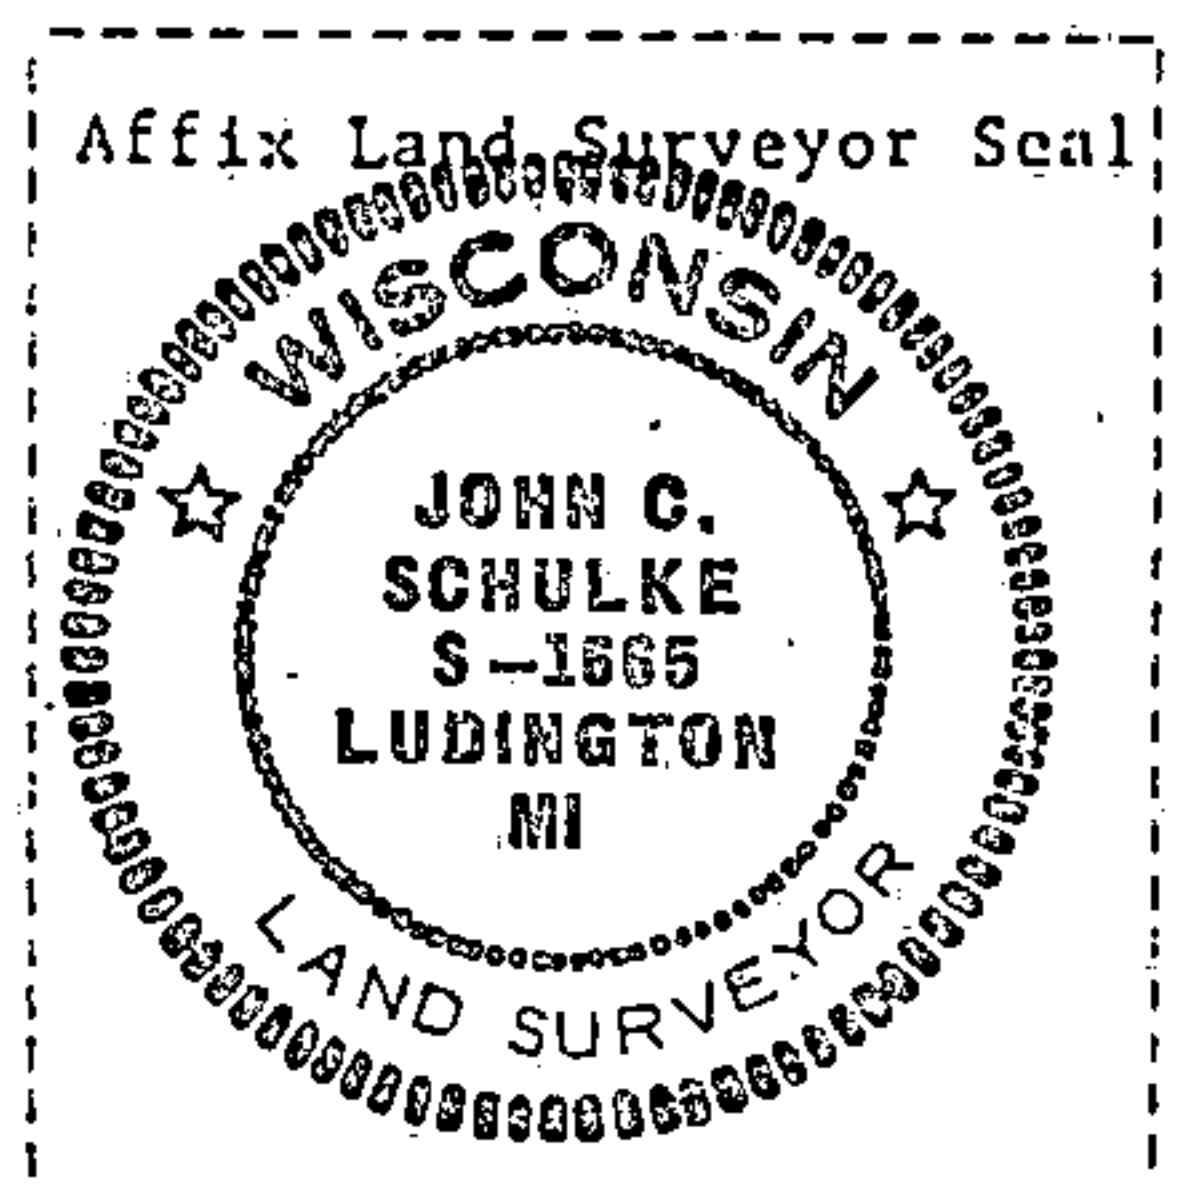

(i) I, John Schulke (RL.S-1665)
 (type or print name) certify that the corner location shown on this record was determined by me or under my direction and control and that this U.S. Public Land Survey Monument Record is correct and complete to the best of my knowledge and belief.

John C Schulke Signature Oct 25th, 1989 Date

Survey requested by: Dale Staege District Ranger 1989 Date