

CERTIFIED LAND CORNER RESTORATION

State of Wisconsin }  
County of Forest } ss.

I Milo E. Stefan, do hereby certify that on the 13th day of May, 1982, I found evidence of the South Quarter corner of Section 17 Township 37N, Range 12E, Fourth Principal Meridian, as described hereon; and that from this evidence I established a new monument and accessories as described hereon to perpetuate the original location of this corner:

Description of original monument and accessories and subsequent restorations:

Surveyed in 1859 by William Daugherty  
11.00 chains east, set 1/4 section wood post  
Cedar, 8", S23E, 10 lks.  
Tamarack, 8", N7W, 11 lks.


Description of corner evidence found:

Found 4" x 4" x 5" Cedar post with fence south and east  
Stump hole, S23E, 7 feet  
Stump mound, NW, 7 feet - 8 feet

Description of monument and accessories I established to perpetuate the location of this corner:

Replaced Cedar post with a 2" x 36" aluminum pipe with tablet stamped as follows:  
T37N, R12E, S17, 1/4, S20, 1982, RLS-1558  
From which the following bear:  
Red Maple, 6", S19E, 9.71 feet  
Red Maple, 5", N62W, 7.79 feet  
Red Maple, 8", N43E, 13.79 feet  
Steel sign post, East, 2.4 feet

DOCUMENT NO.  
**124242**

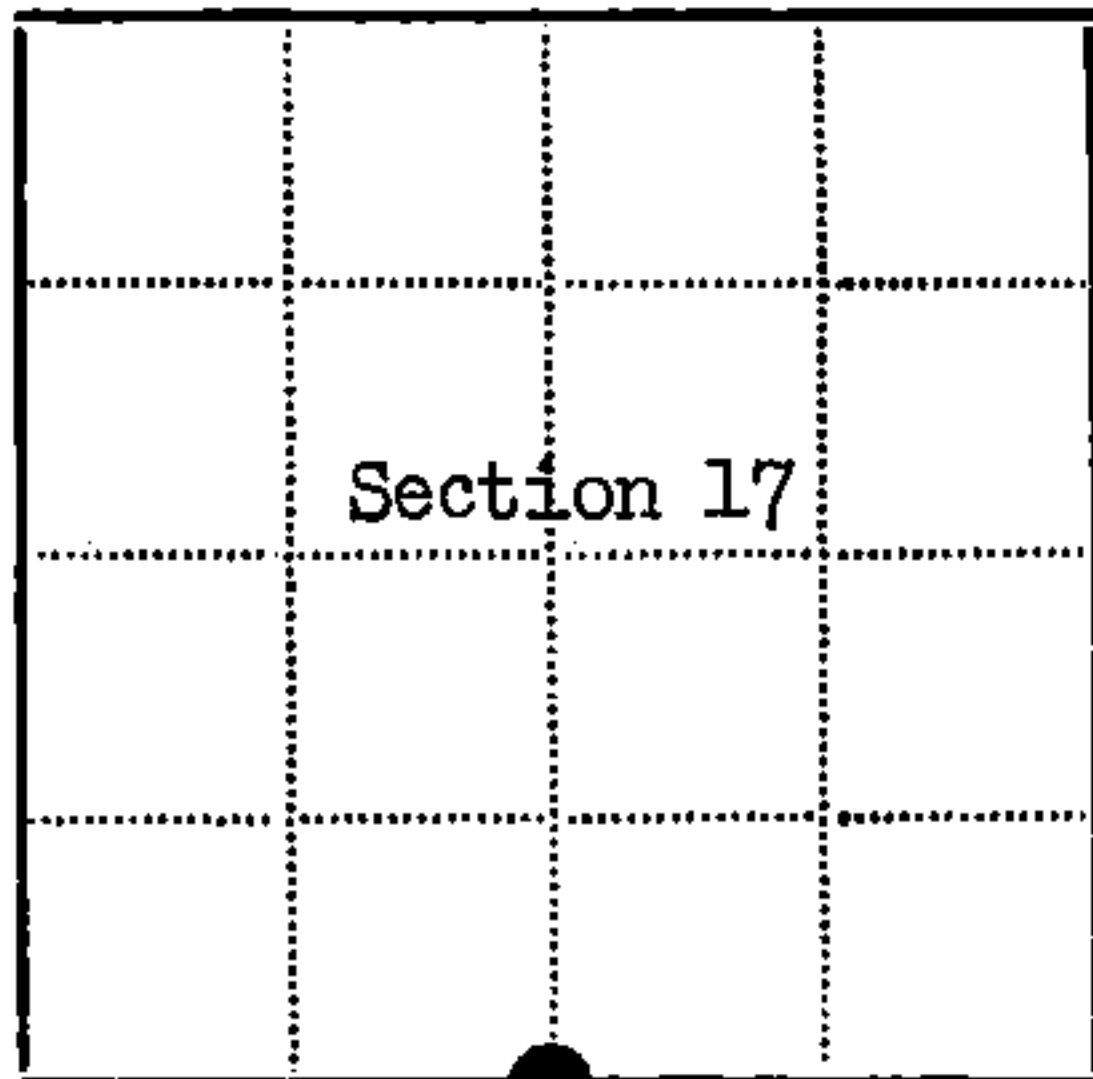

● - Corner monument restored  
□ -

Resident witnesses.....

Dated at Rhineland Wisconsin, this 13 day of May 1982

Signature Milo E. Stefan Title Land Surveyor  
(County Surveyor, Registered Land Surveyor, or other duly authorized official)

Surveyors Registration No. RLS-1558

Office of Register of Deeds County of Forest

I hereby certify that the within instrument was filed in this office for record on the 15th day of September 1983, and was filed in Book No. Page No. of County Records.

Signature Eugene Statynj Title Register of Deeds

Township 37N, Range 12E, Section 17, Index No. N-7, Page No. 49

43712170020