

CERTIFIED LAND CORNER RESTORATION

State of Wisconsin }
County of Forest } ss.

I Milo E. Stefan, do hereby certify that on the 5th day of August, 1982, I found evidence of the Southwest corner of Section 36 Township 37N, Range 12E, Fourth Principal Meridian, as described hereon; and that from this evidence I established a new monument and accessories as described hereon to perpetuate the original location of this corner:

Description of original monument and accessories and subsequent restorations:

Surveyed in 1858 by Alfred Millard
80.00 chains, set wood post
Yellow Birch, 9", N20W, 29 lks., 19.18 feet
Yellow Birch, 14", N58E, 28 lks., 18.48 feet
Maple, 14", S50E, 12 lks., 7.92 feet
Yellow Birch, 10", S40W, 27 lks., 17.82 feet


Description of corner evidence found:

Found scribed post in fence corner
Yellow Birch stump, N20W, 19.2 feet
Yellow Birch stump, 16" - 18", N78E*, 18.5 feet
Stump hole, S40W, 17.8 feet
*Note 20° error.

Description of monument and accessories I established to perpetuate the location of this corner:

Removed fence post and re-rod and placed a 2" x 36" aluminum monument in mound of stone with tablet stamped as follows:
T37N, R12E, S35, S36, S2, S1, T36N, 1982, RLS-1558
From which the following bear:
Sugar, 8", N63E, 47.27 feet
Sugar, 6", S52E, 23.39 feet
Sugar, 5", S57W, 23.39 feet
Hemlock, 12", N53W, 14.12 feet
Steel sign post, West, 1.5 feet

DOCUMENT NO.
124243

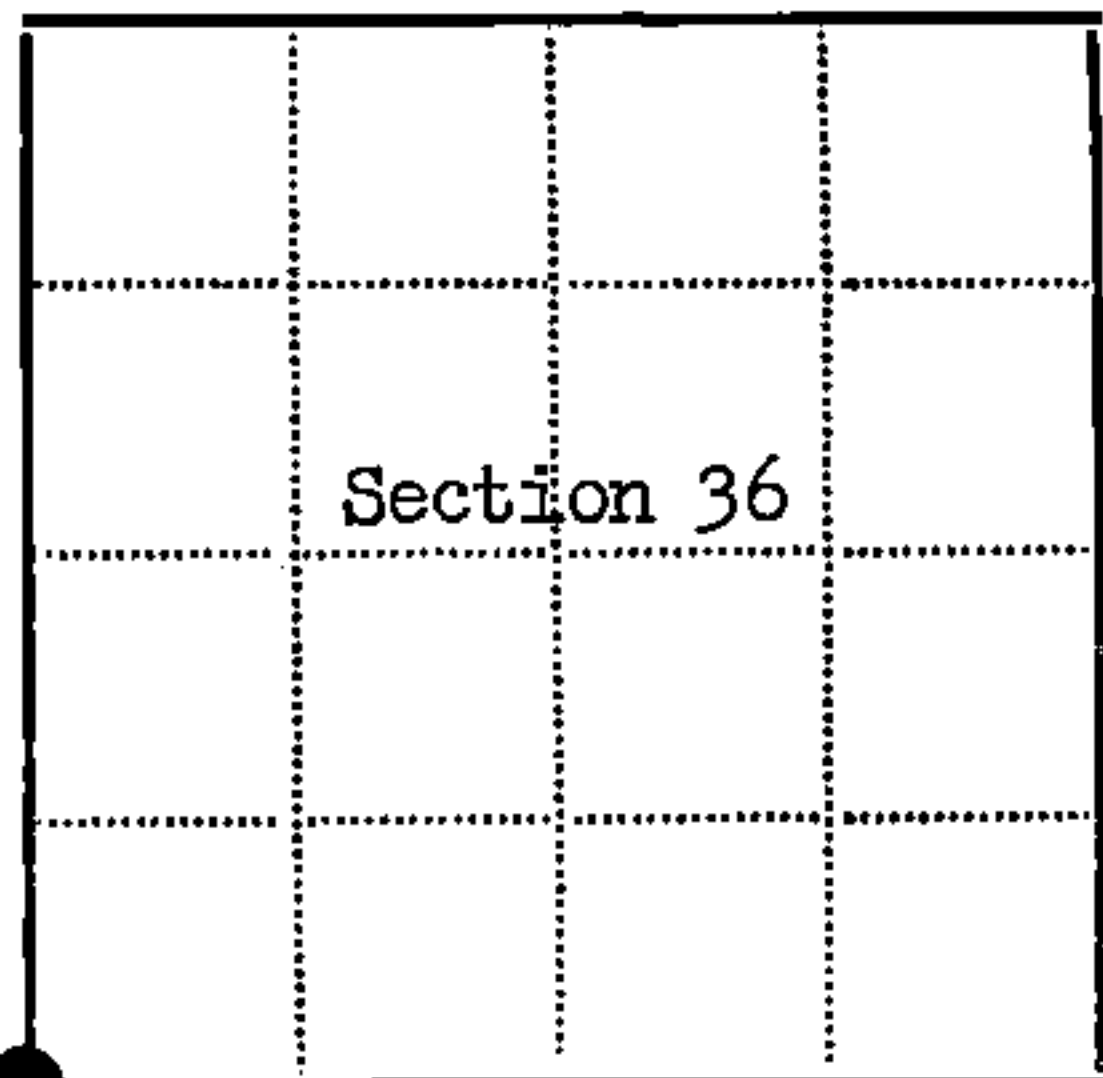

● - Corner monument restored
□ -

Resident witnesses.....

Dated at Rhinelander Wisconsin, this 2 day of MAY 1982

Signature Milo E. Stefan Title Land Surveyor
(County Surveyor, Registered Land Surveyor, or other duly authorized official)

Surveyors Registration No. RLS-1558

Office of Register of Deeds County of Forest

I hereby certify that the within instrument was filed in this office for record on the 15th day of September 1983, and was filed in Book No. Page No. of County Records.

Signature Eugene Stetson Title Register of Deeds

Township 37N, Range 12E, Section 36, Index No. Z-21, Page No. 6

43712350000

721