

U.S. PUBLIC LAND SURVEY MONUMENT RECORD

Index No. N-5

State of Wisconsin }
 County of Forest } ss.

I, William B. Cochrane, do hereby certify that on the 10th day of April, 1991, I found evidence of the Southwest Section corner of Section 17 Township 37, North, Range 13 East, Fourth Principal Meridian, as described hereon; and that from this evidence I established a new monument and accessories as described hereon to perpetuate the original location of this corner.

Resident witnesses:

Dean Young

History of original corner establishment:

Original Government Survey in 1865 by J.L. Nowlin. North between Sections 19 and 20, at 80.00 chains, set Section Corner Post, from which the following bear;

Tamarac	6"	N31°E	50 lks.
Tamarac	5"	N83°W	45 lks.

Description of corner evidence found:

Found a 2 inch diameter iron pipe and an old post point lying on the ground next to the pipe.

Also found badly decayed Tamarac stumps at the bearings and distances described above.

I accept the iron pipe as the best available evidence for restoring the corner position.

Description of monument and accessories I established to perpetuate the original location of this corner.

In place of iron pipe, set a 2½ inch diameter aluminum pipe monument, 10 feet long, 9 feet in the ground, with an aluminum cap stamped; T37N R13E, S17, S18 S19, S20, 1991, S-1107. From which the following new blazed and scribed bearing trees bear;

Spruce	5"	N03°E	16.33 feet
Tamarack	5"	N88°E	12.99 feet
Spruce	5"	S04°E	12.45 feet
Tamarack	4"	S58°W	20.78 feet
Steel Sign Post		Northeast	1.00 feet

Dated at Hiles, Wis., this 19th day of February, 1992


Signature William B. Cochrane Title Land Surveyor Registration No. S-1107
 (County Surveyor, Registered Land Surveyor, or other duly authorized official)

Office of Register of Deeds, County of Forest. I hereby certify that the within instrument was filed in this office for record on the 31st day of August, 1992 at 10:15 o'clock A. M.

Paul Aschenbrenner

 (Register of Deeds)

By _____ Deputy

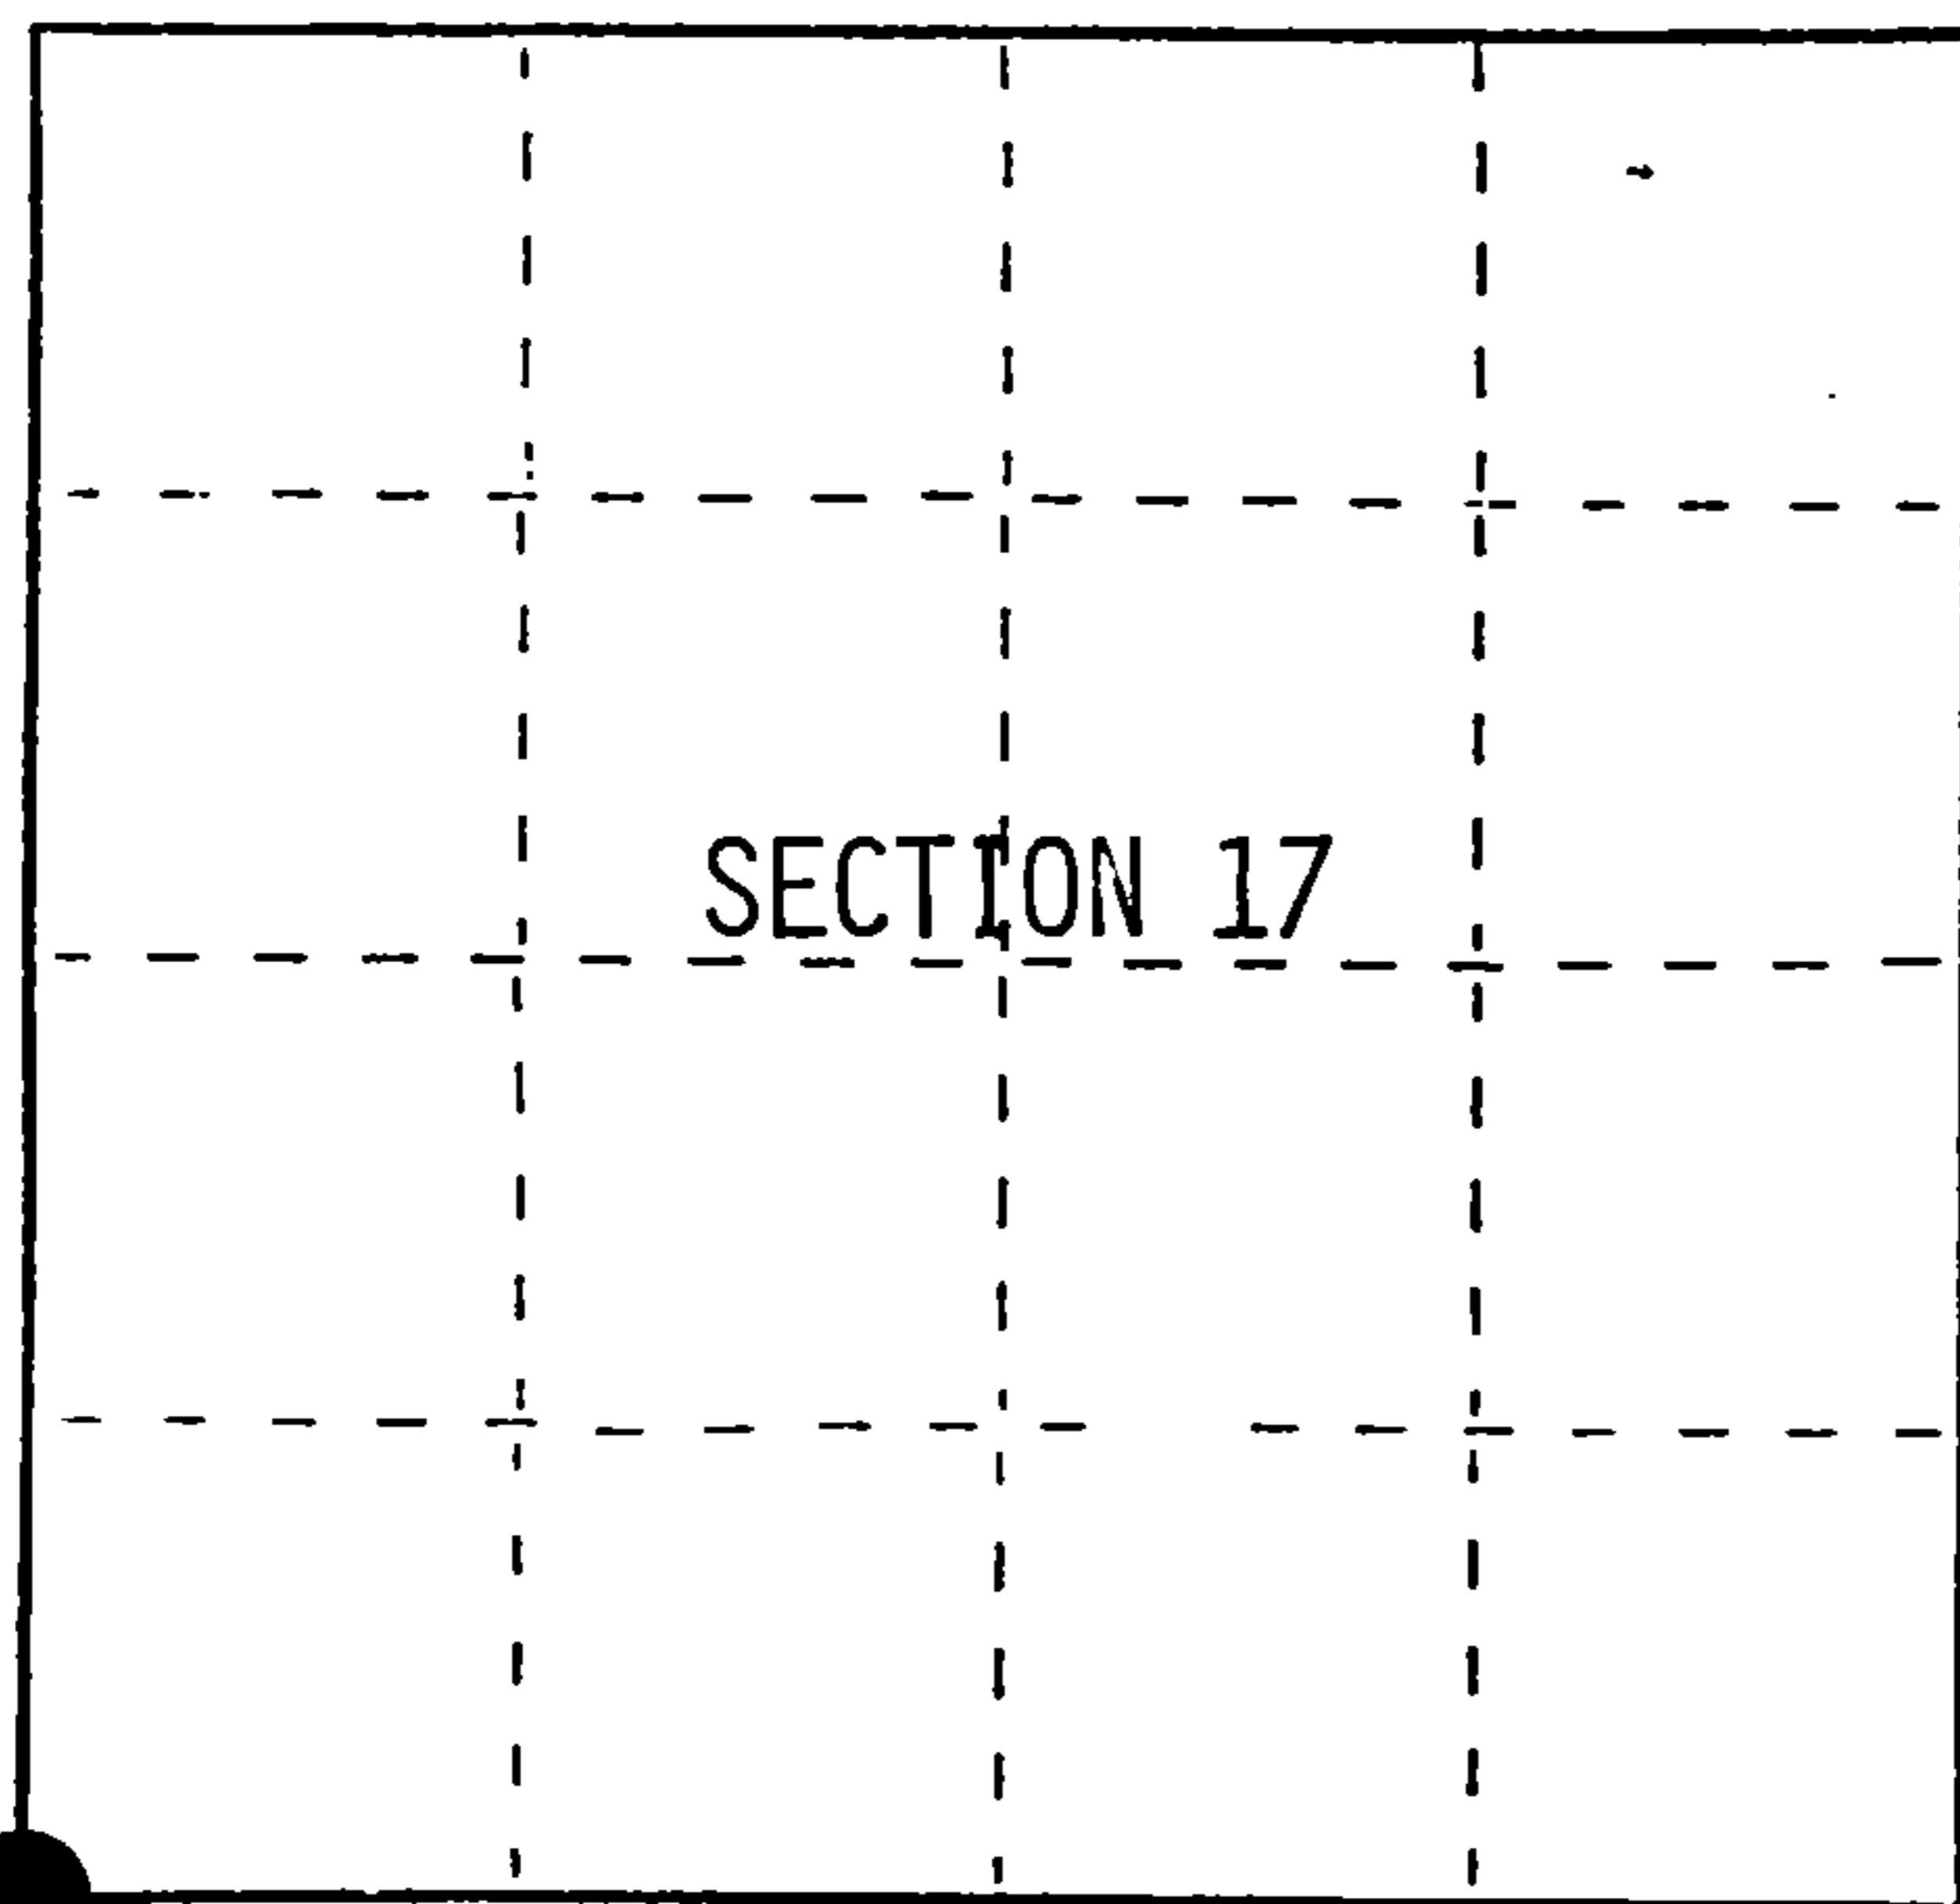

● = Corner monument restored.

FORM NO. 965-A



Stock No. 26273
 DOCUMENT NUMBER
 1453339

4371318000

