

CERTIFIED LAND CORNER RESTORATION

Index No. T-5

State of Wisconsin }
County of Forest } ss.


I Philip T. Hansen, do hereby certify that on the 14th day of November, 1977, I found evidence of the Quarter corner of Section 29 - 30 Township 37, North, Range 13 East, Fourth Principal Meridian, as described hereon; and that from this evidence I established a new monument and accessories as described hereon to perpetuate the original location of this corner.

Resident witnesses:


Glen Barker

Jim Claflin

Herb Wagoner

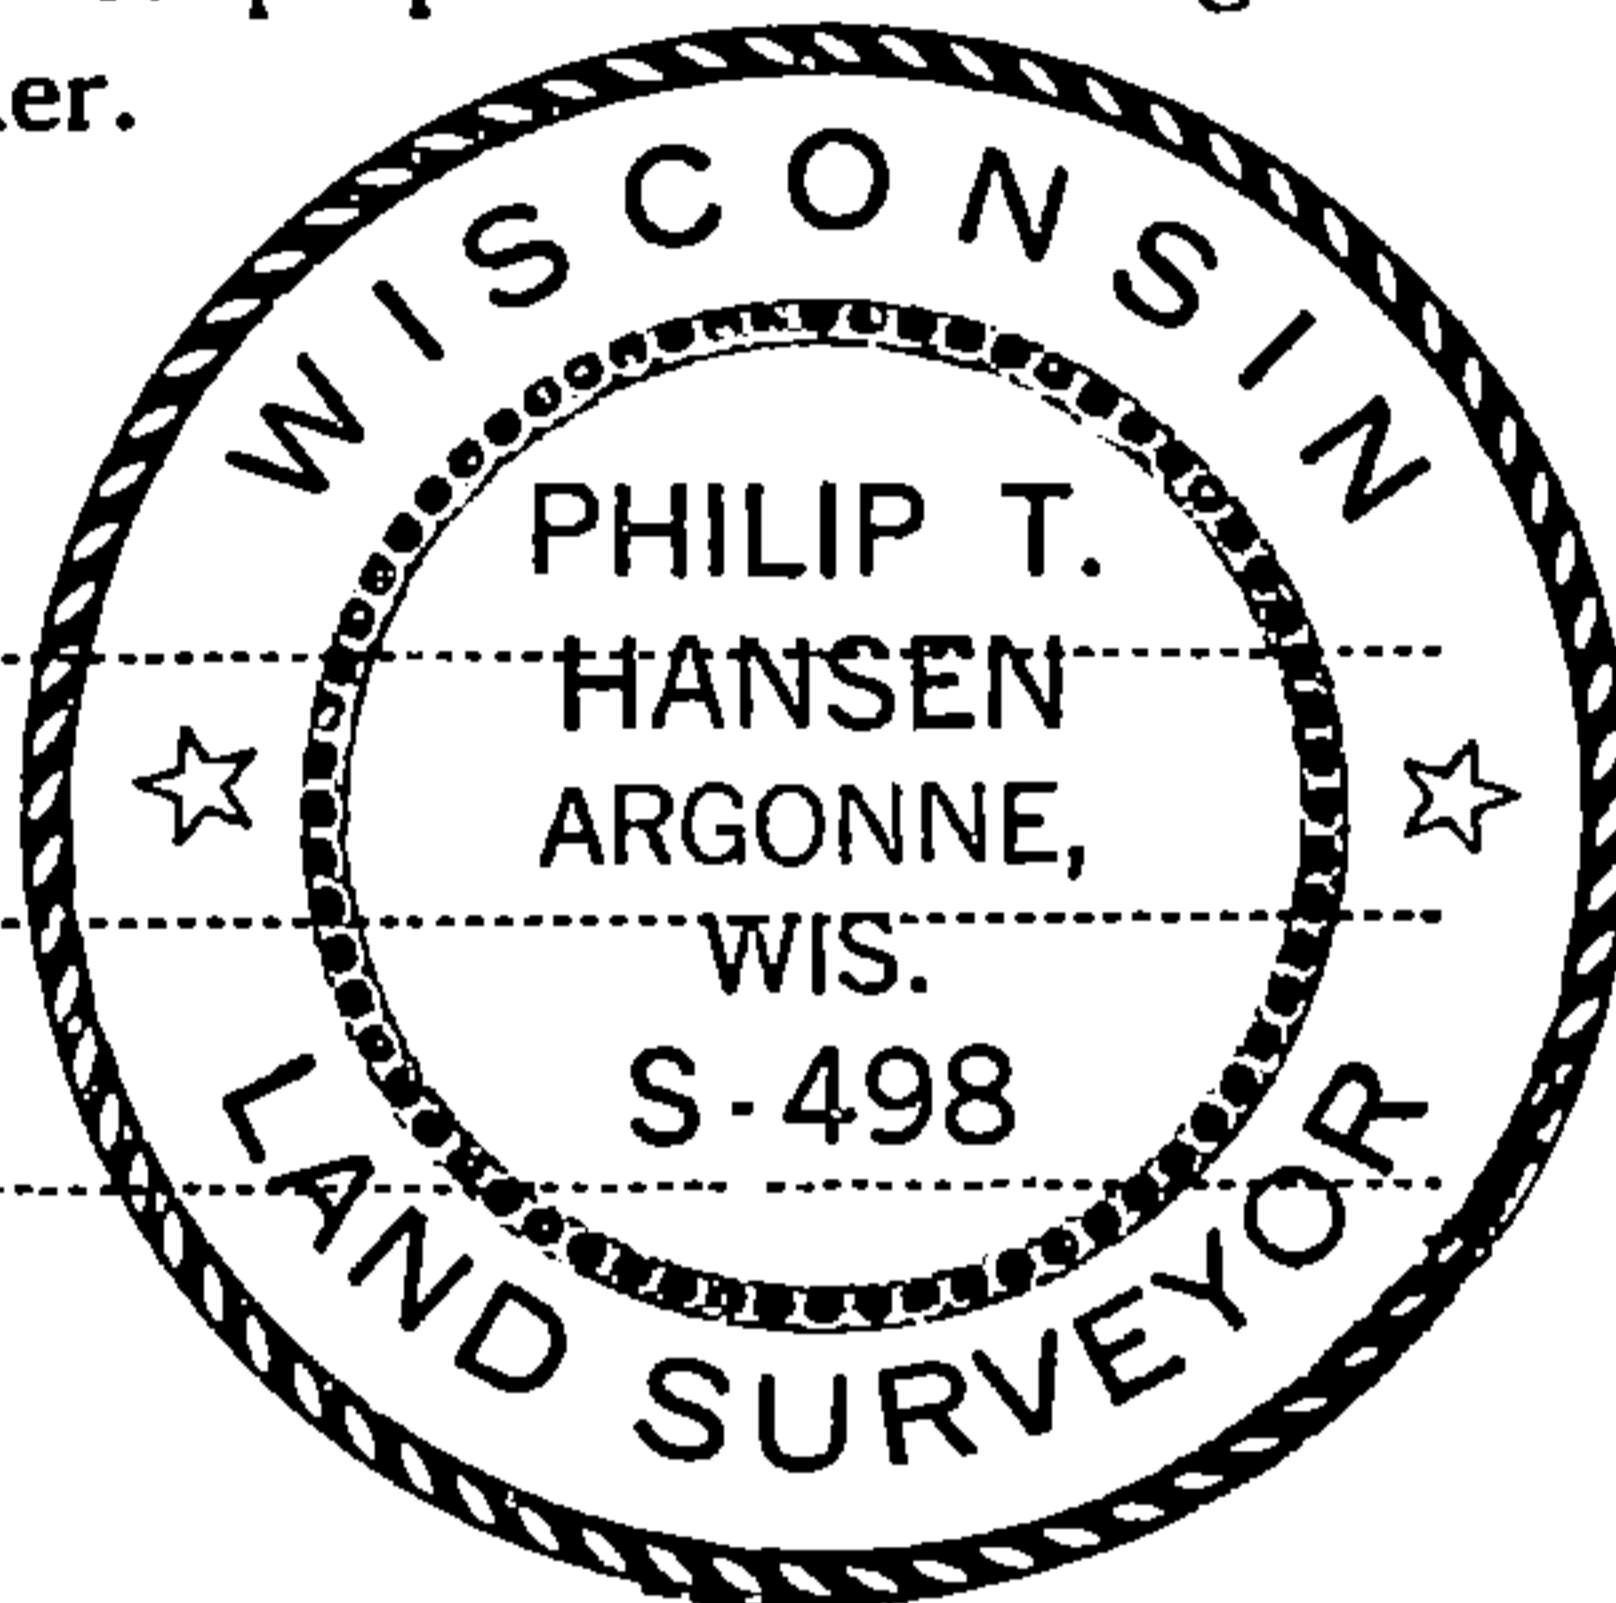

FORM 985 H. C. MILLER CO., MILWAUKEE

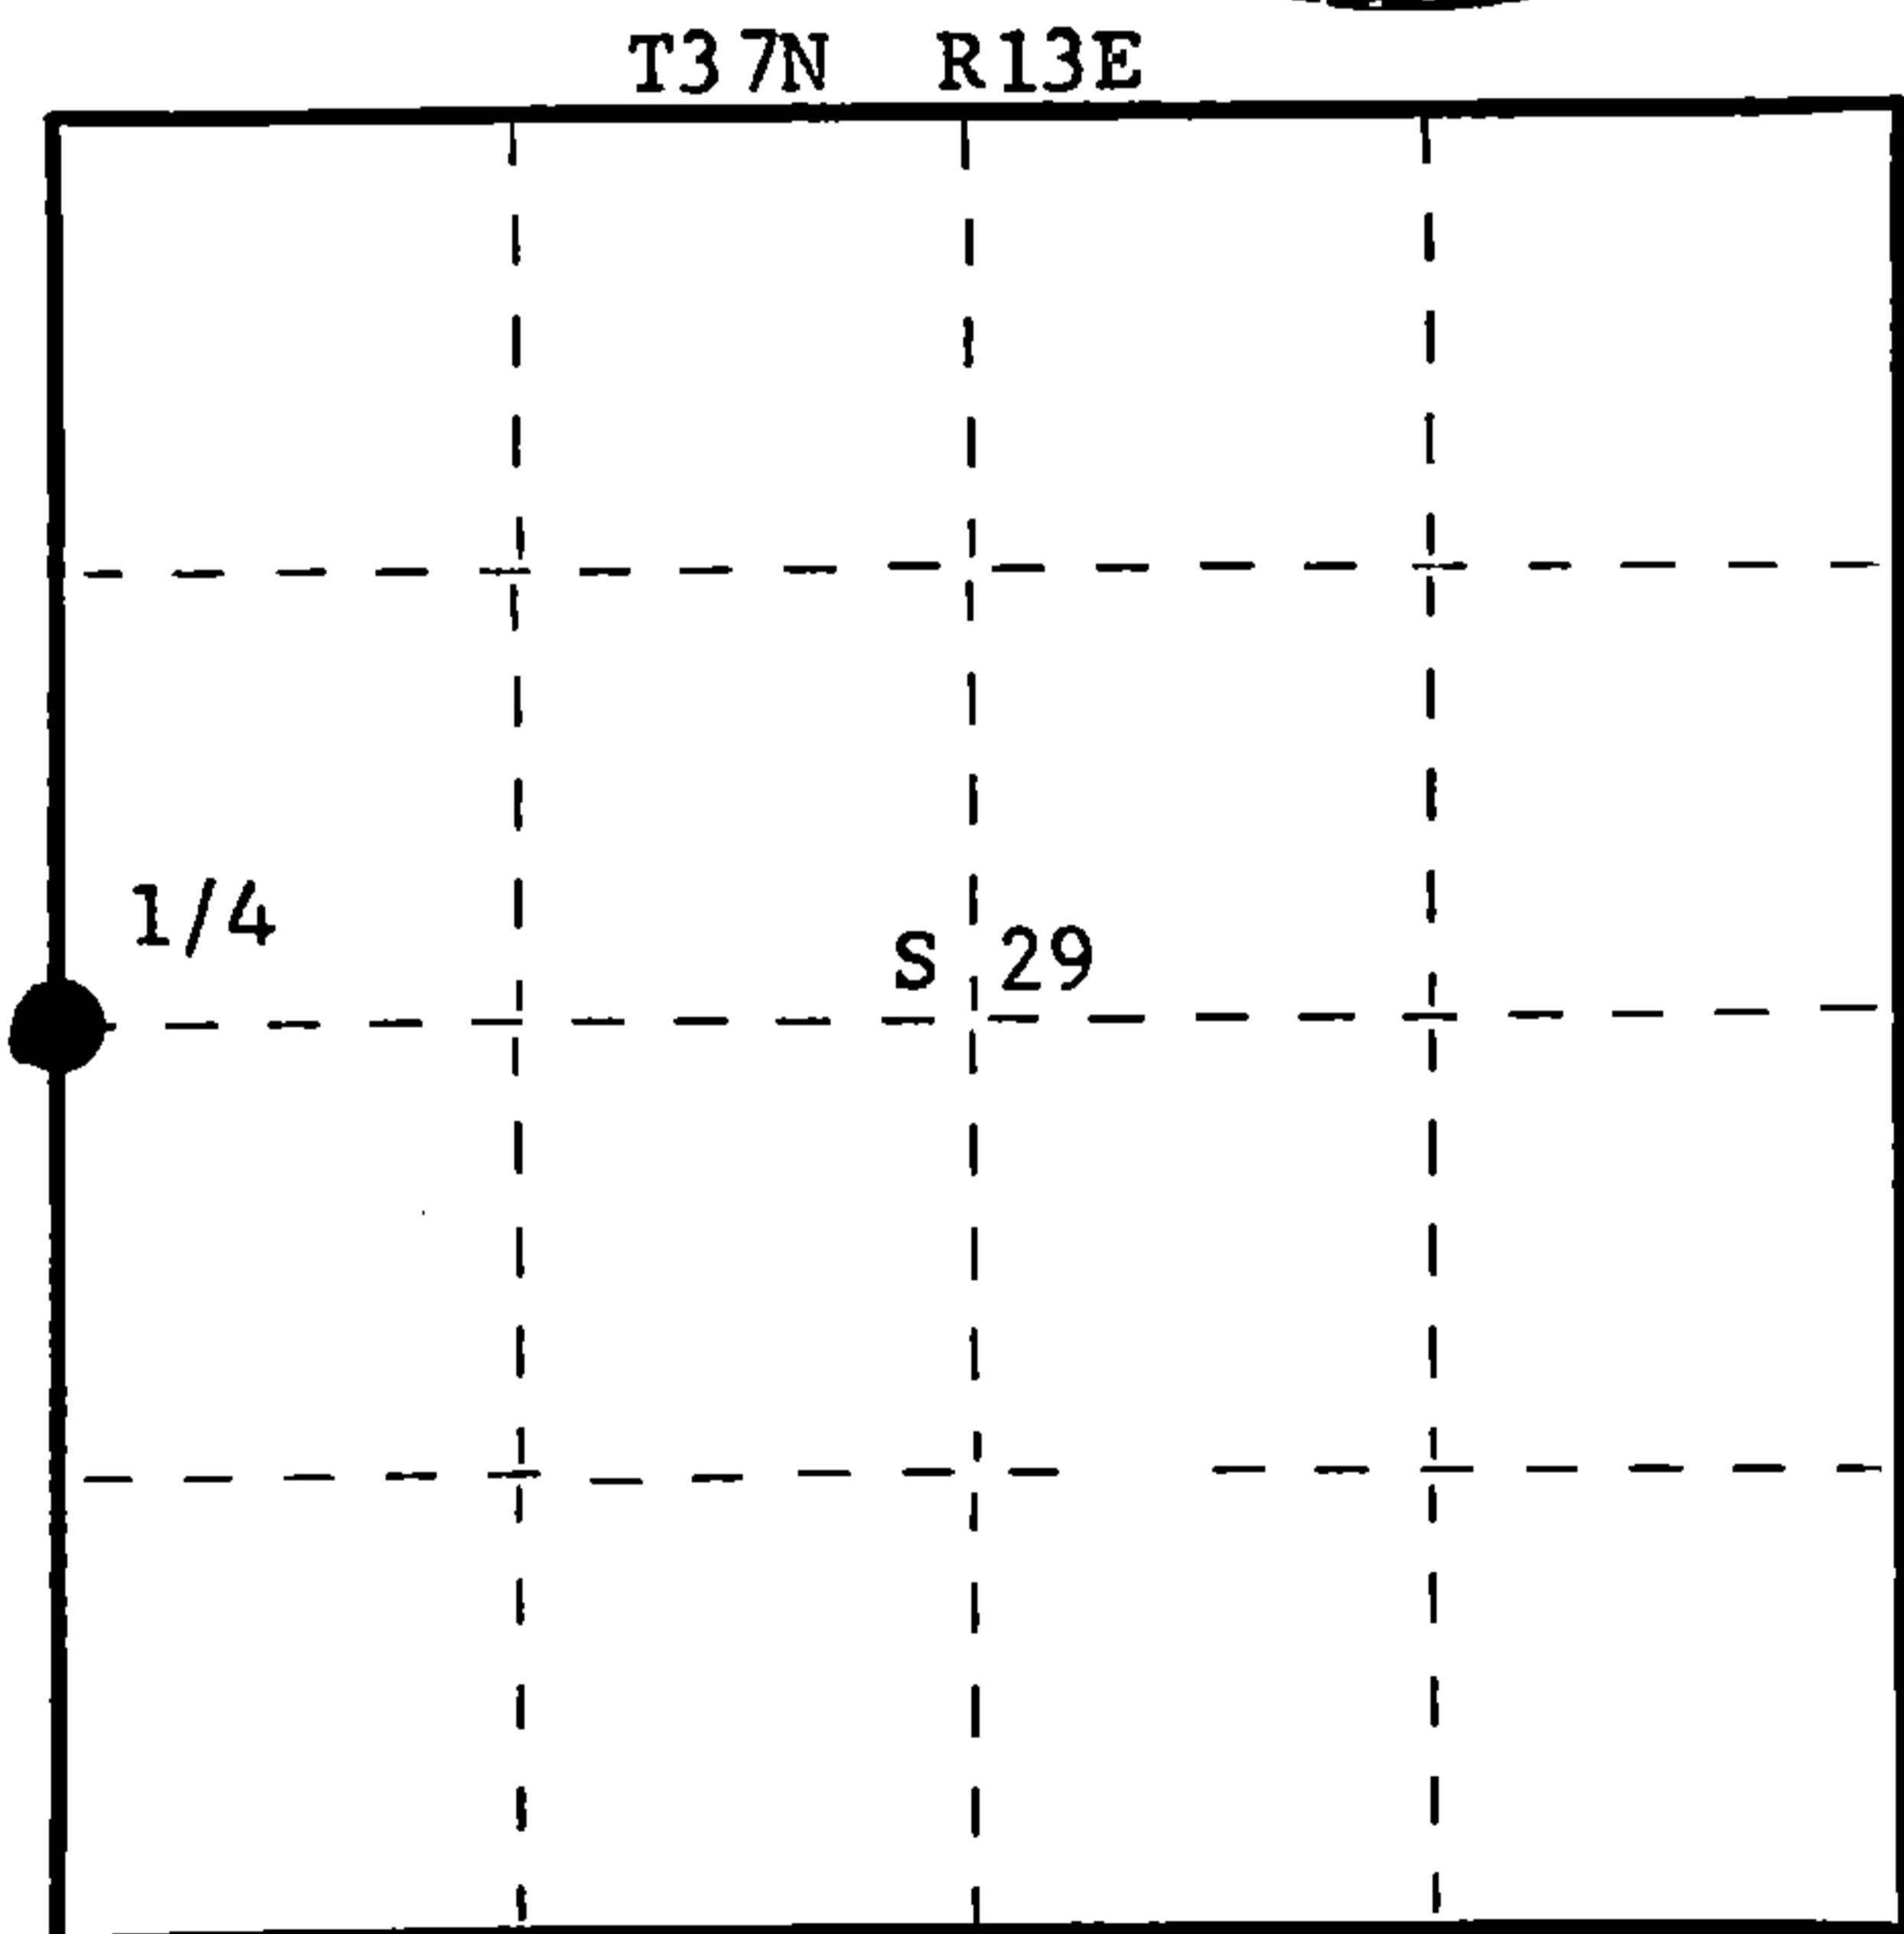

○ = Corner monument restored.

History of original corner establishment:
No record of any survey subsequent to original survey.

Description of corner evidence found:
No evidence of any corner found. Accepted the intersection of section line with centerline of Cemetery Road East and the old section line fence west as the 1/4 corner.

Description of monument and accessories I established to perpetuate the original location of this corner.
Set a survey spike 1/2" x 6" below surface of road at intersection for corner.
Set a 2 1/2" Berntsen A-1 Federal Monument, aluminum with magnet in cap and base 50 links west of corner for witness corner.
Monument projects 10" above ground. Cap stamped:
Marked B.O. to true corner.
Power pole 3713 30R1 S26°W, 47.4 links (spike).
Road sign - County N & 1/4 line road N48°E, 60.4 links.

T37N R13E
1/4 S30 | S29 W.C.
S498 - 1977
E 50 lks to Cor.

Dated at Rhineland, Wis., this 16th day of November, 1977

Signature Philip T. Hansen Title Registered Land Surveyor Registration No. S-498
(County Surveyor, Registered Land Surveyor, or other duly authorized official)

Office of Register of Deeds, County of Forest, I hereby certify that the within instrument was filed in this office for record on the 17th day of November, 1977 at 4:00 o'clock P. M.

Eugene Stutzman
(Register of Deeds)

By _____ Deputy

DOCUMENT NUMBER
112818

43713302000