

CERTIFIED LAND CORNER RESTORATION

Index No. X 5

State of Wisconsin }
County of Forest } ss.

I William B. Cochrane, do hereby certify that on the 10 th day of September, 1977, I found evidence of the East Quarter corner of Section 31 Township 37, North, Range 13 East, Fourth Principal Meridian, as described hereon; and that from this evidence I established a new monument and accessories as described hereon to perpetuate the original location of this corner.

Resident witnesses:

Miles H. Cochrane

History of original corner establishment:

Surveyed in 1865 by J. L. Nowlin
North between Sections 31 and 32
40.00 chs. Set 1/4 Section post
Sugar, 12", N 21° E, (No record distance given)
Sugar, 8", S 64° W, 20 lks.
30.00 chs. South, Stream, 15 lks. wide, runs East

Description of corner evidence found:

At the point of the center-line intersection of Town road East and West and North and South, I found a 2" diameter iron pipe, 30 inches long, with the top 6" bent over. The pipe was buried 6" below the blacktop. This position was pointed out to me by the adjacent owners as being the corner position. I could find no other evidence to contradict this position. I accept the pipe as being the best available evidence of the corner position.

Description of monument and accessories I established to perpetuate the original location of this corner.


I replaced the iron pipe with a 2½" Berntsen A-1 Federal Monument, 30 inches long, buried 6" below the road, with the cap stamped:

T37N R13E, ¼, S31, S32, 1977, S-1107


From which the following bear:

Power Pole #3713-32L1, S 47° E, 31.00 FT.
No other references were available

FORM 985 M. C. MILLER CO., MILWAUKEE

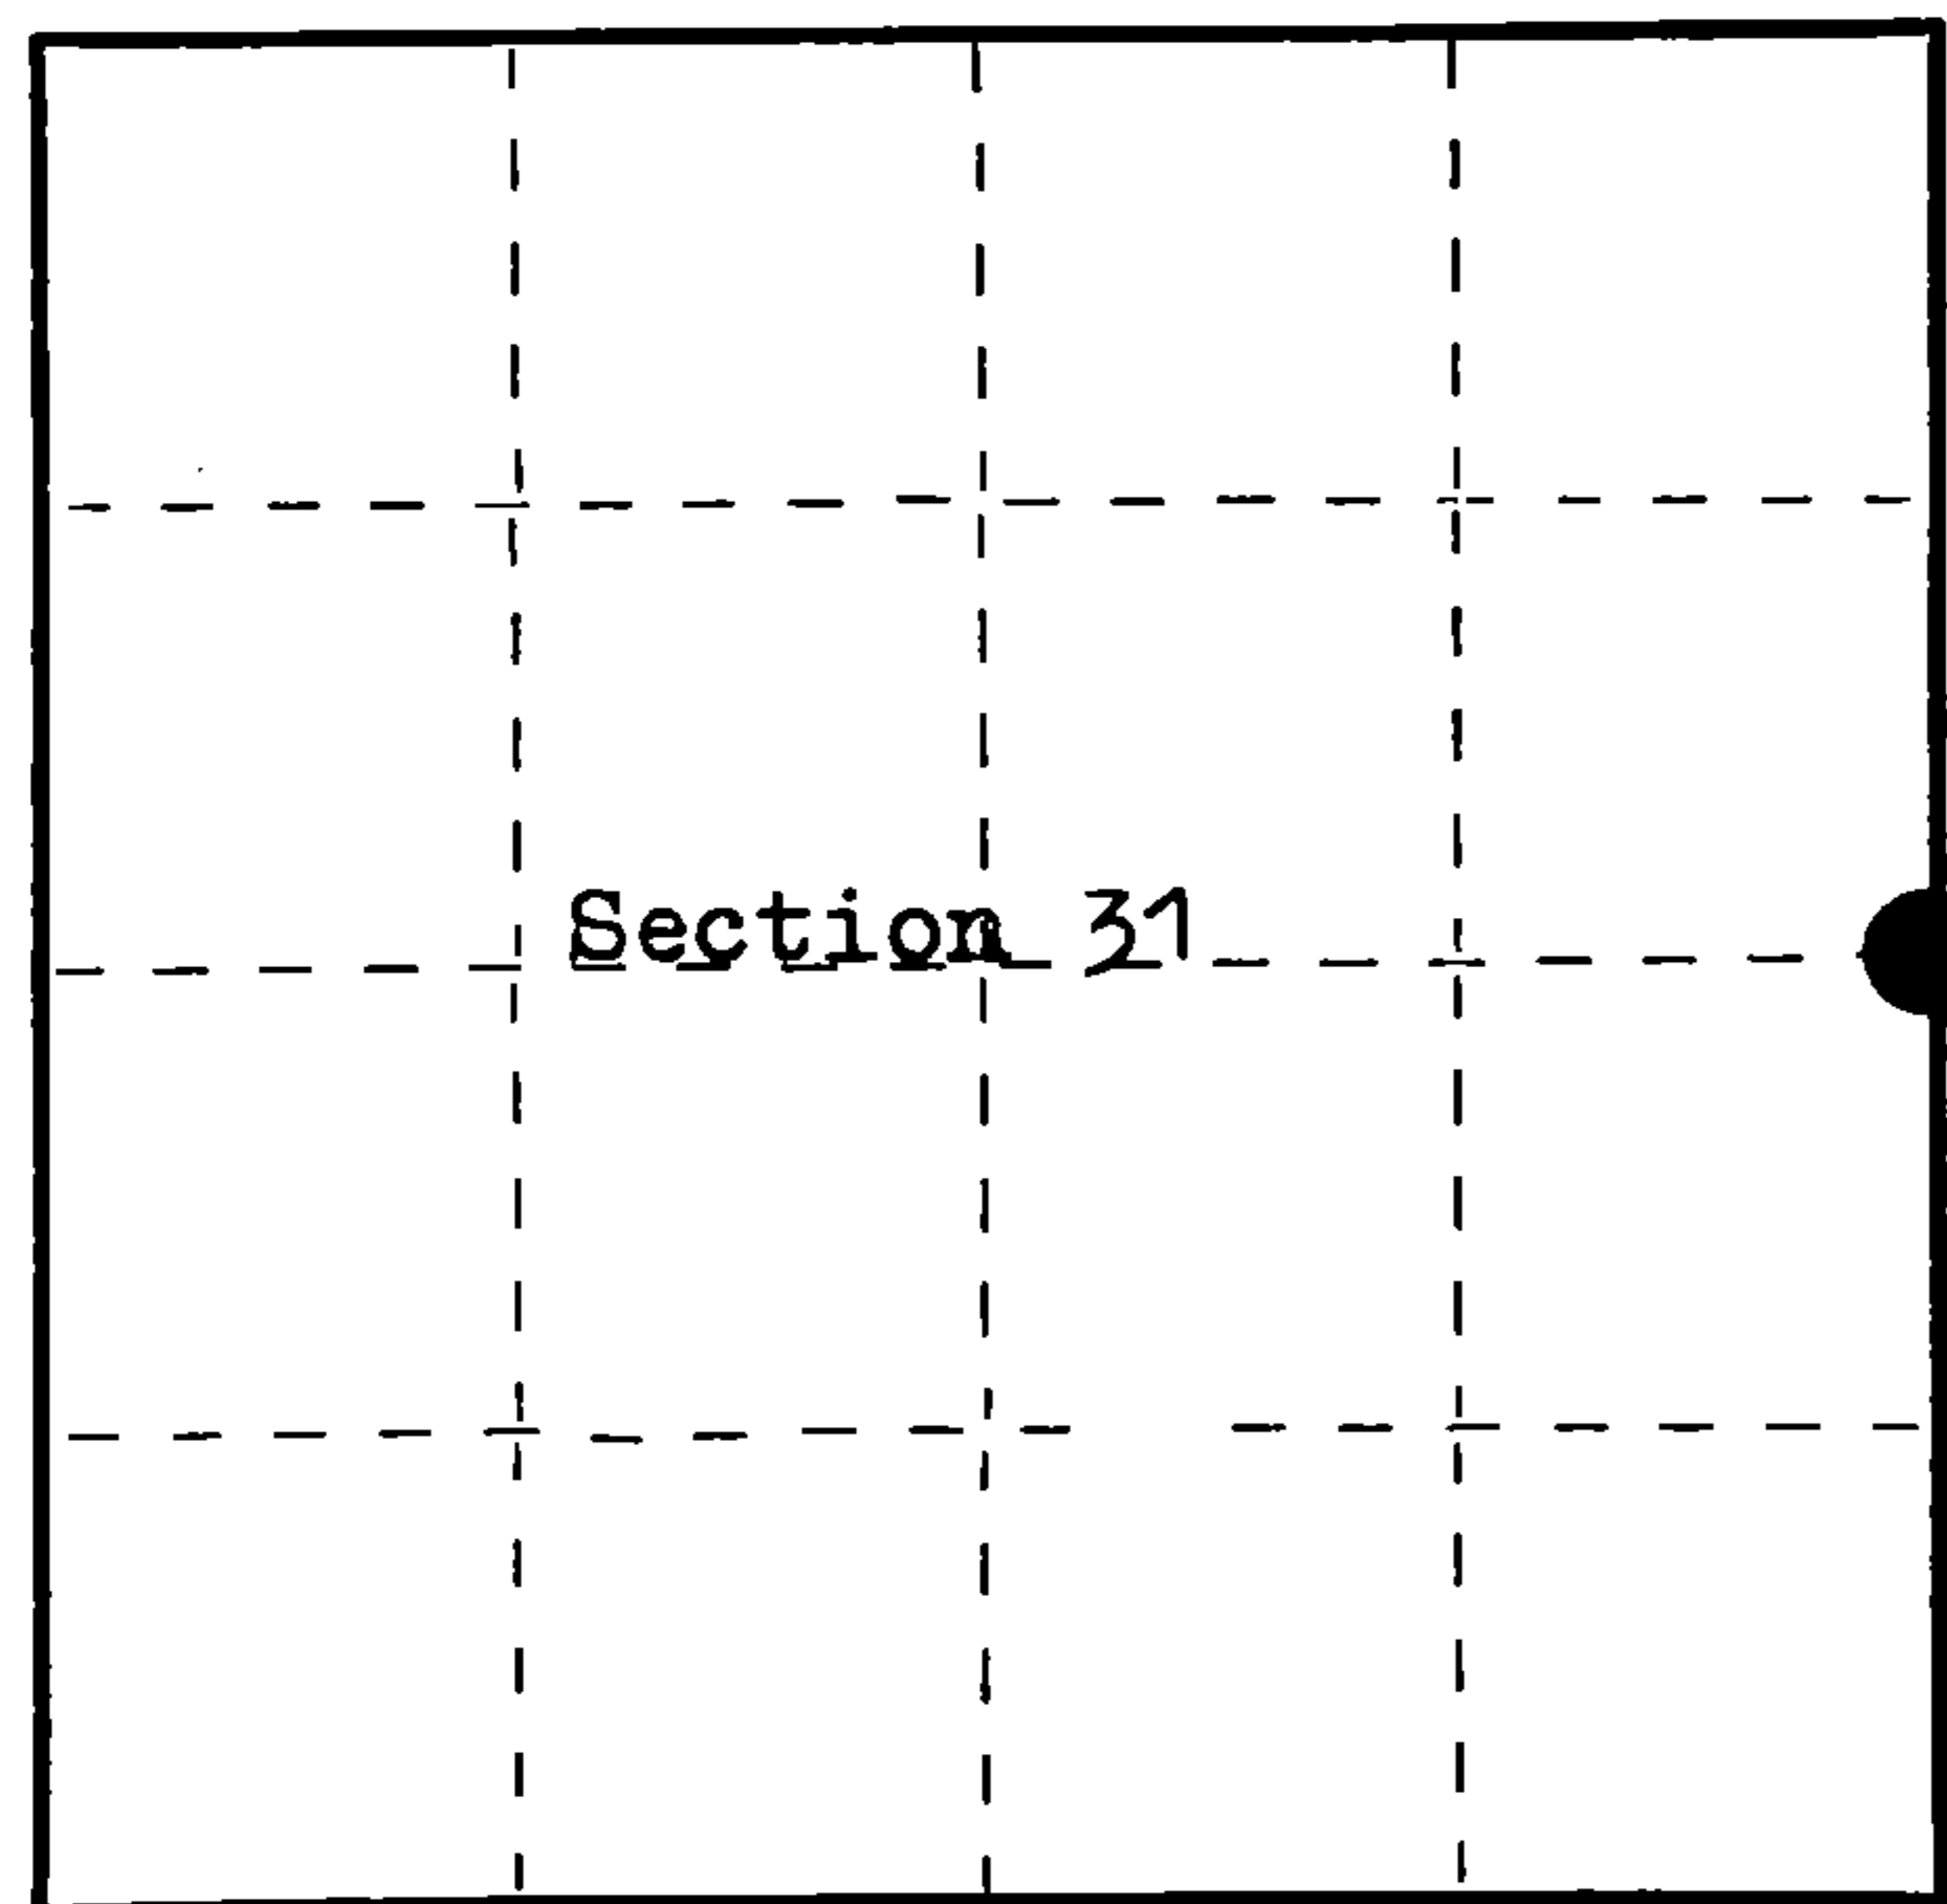

○ = Corner monument restored.

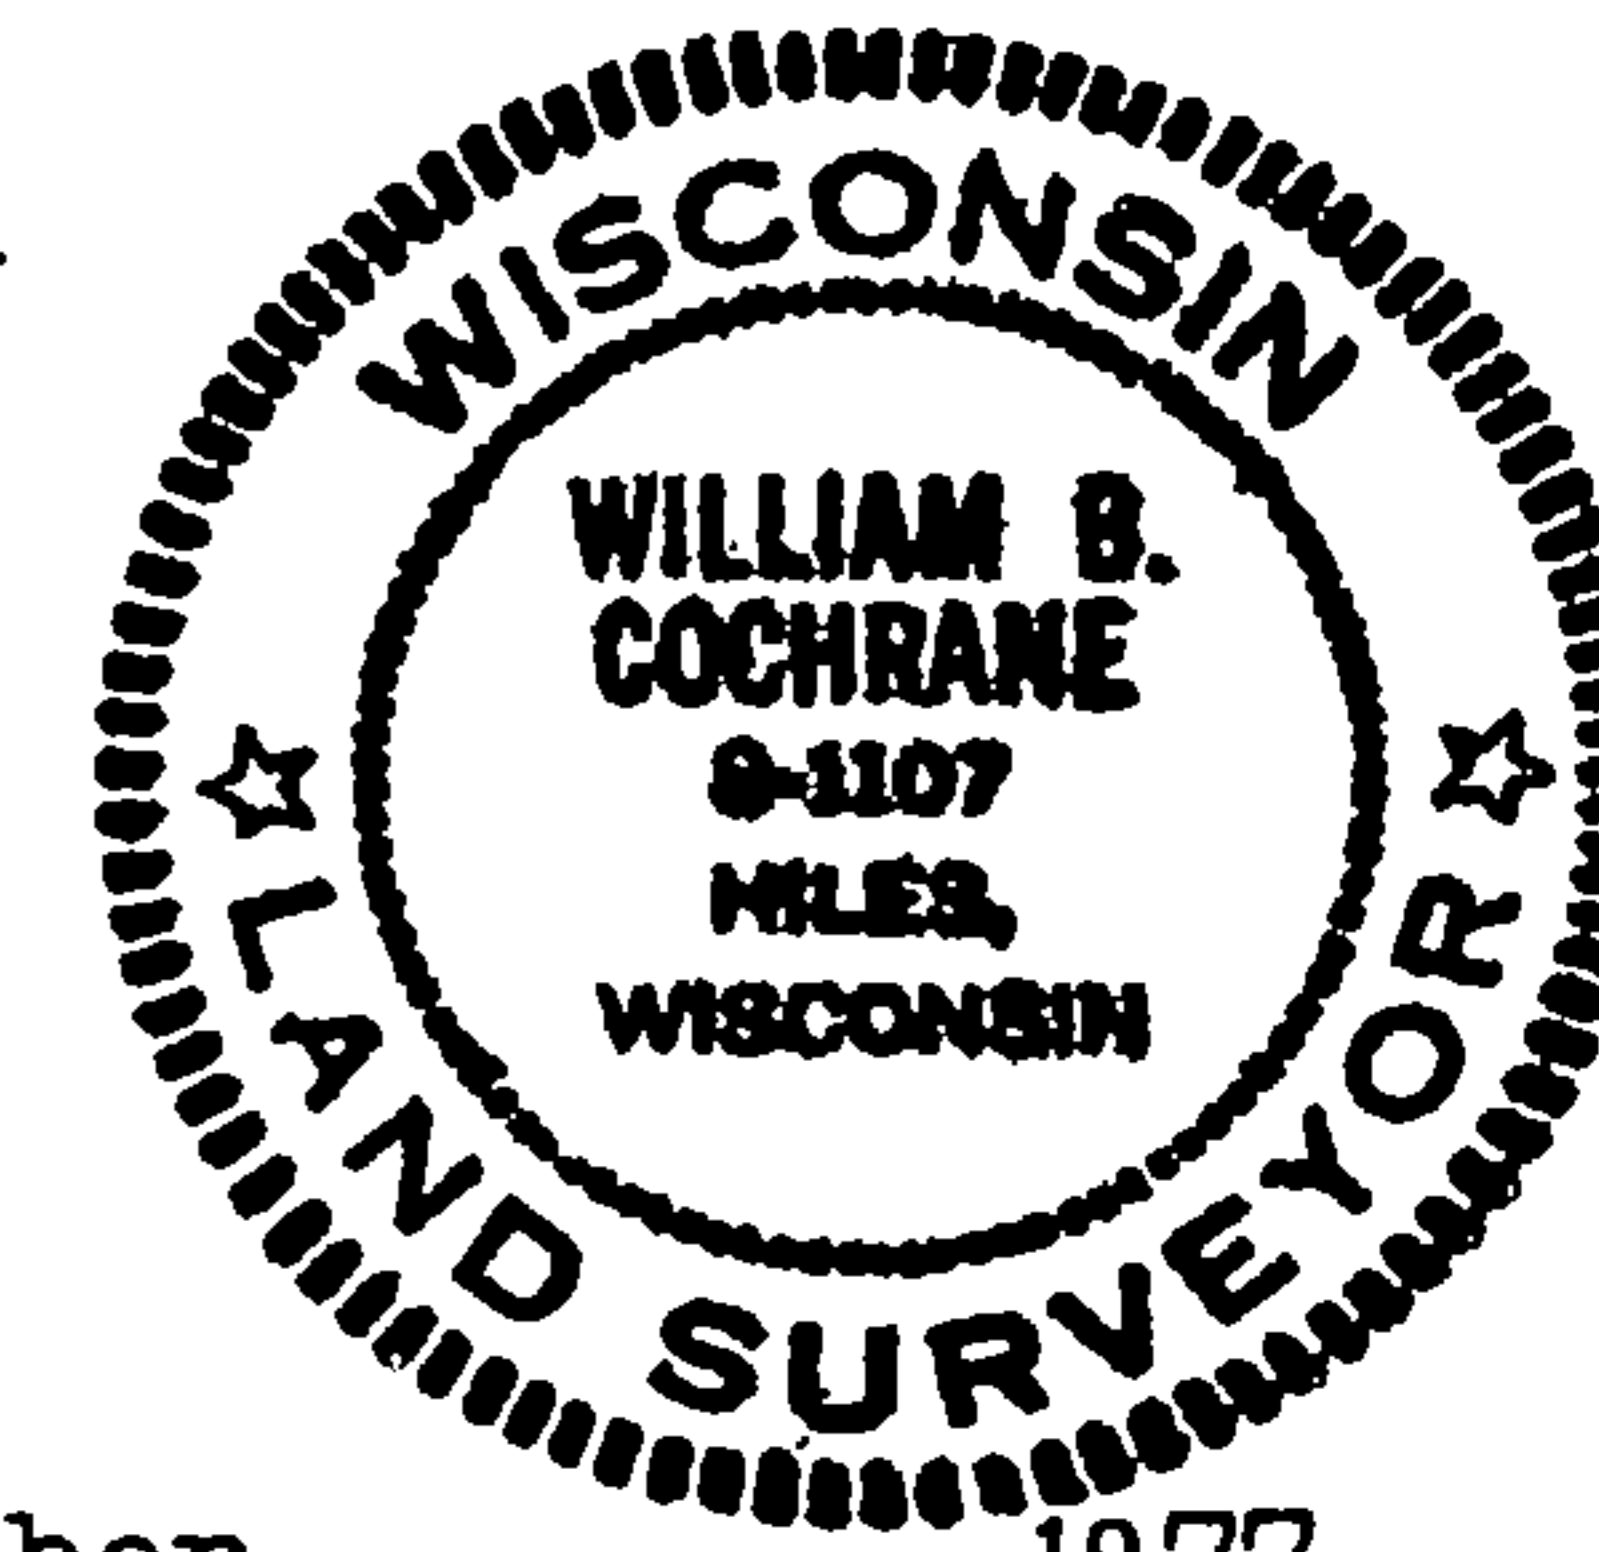

Dated at Hiles, Wis., this 19 th day of September, 1977

Signature William B. Cochrane Title Land Surveyor Registration No. S-1107
(County Surveyor, Registered Land Surveyor, or other duly authorized official)

Office of Register of Deeds, County of Forest, I hereby certify that the within instrument was filed in this office for record on the 20 th day of September, 1977 at 9:00 o'clock A. M.

Eugene Stutzman
(Register of Deeds)

By _____ Deputy

DOCUMENT NUMBER -- 112381

43713312000