

CERTIFIED LAND CORNER RESTORATION


Index No. **J 5**

State of Wisconsin }
County of Forest } ss.


I Philip T. Hansen, do hereby certify that on the 17th day of December, 1975, I found evidence of the Section corner of S7, 8, 17, and 18 Township 37, North, Range 14 East, Fourth Principal Meridian, as described hereon; and that from this evidence I established a new monument and accessories as described hereon to perpetuate the original location of this corner.

Resident witnesses:

Glen Barker
Jim Claflin

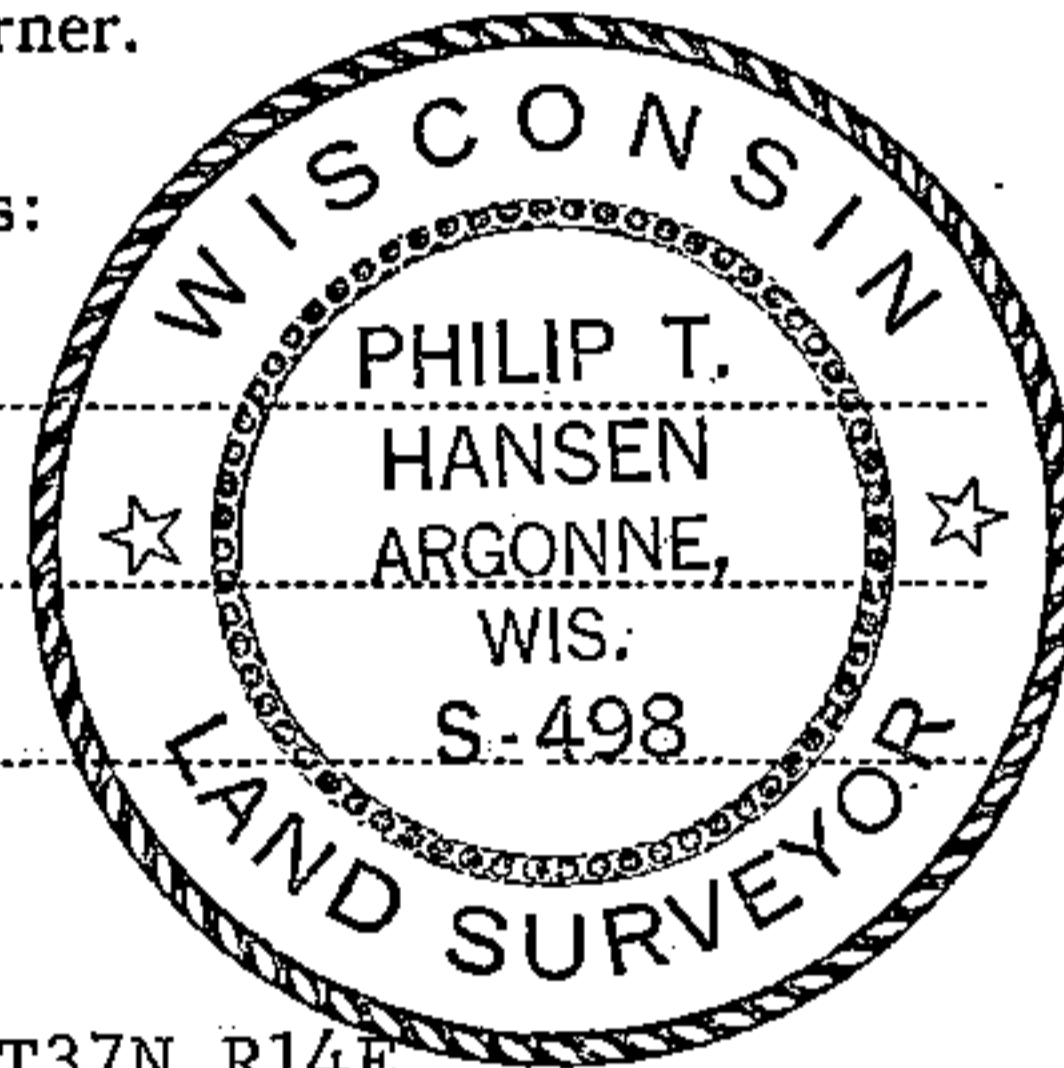

T37N R14E

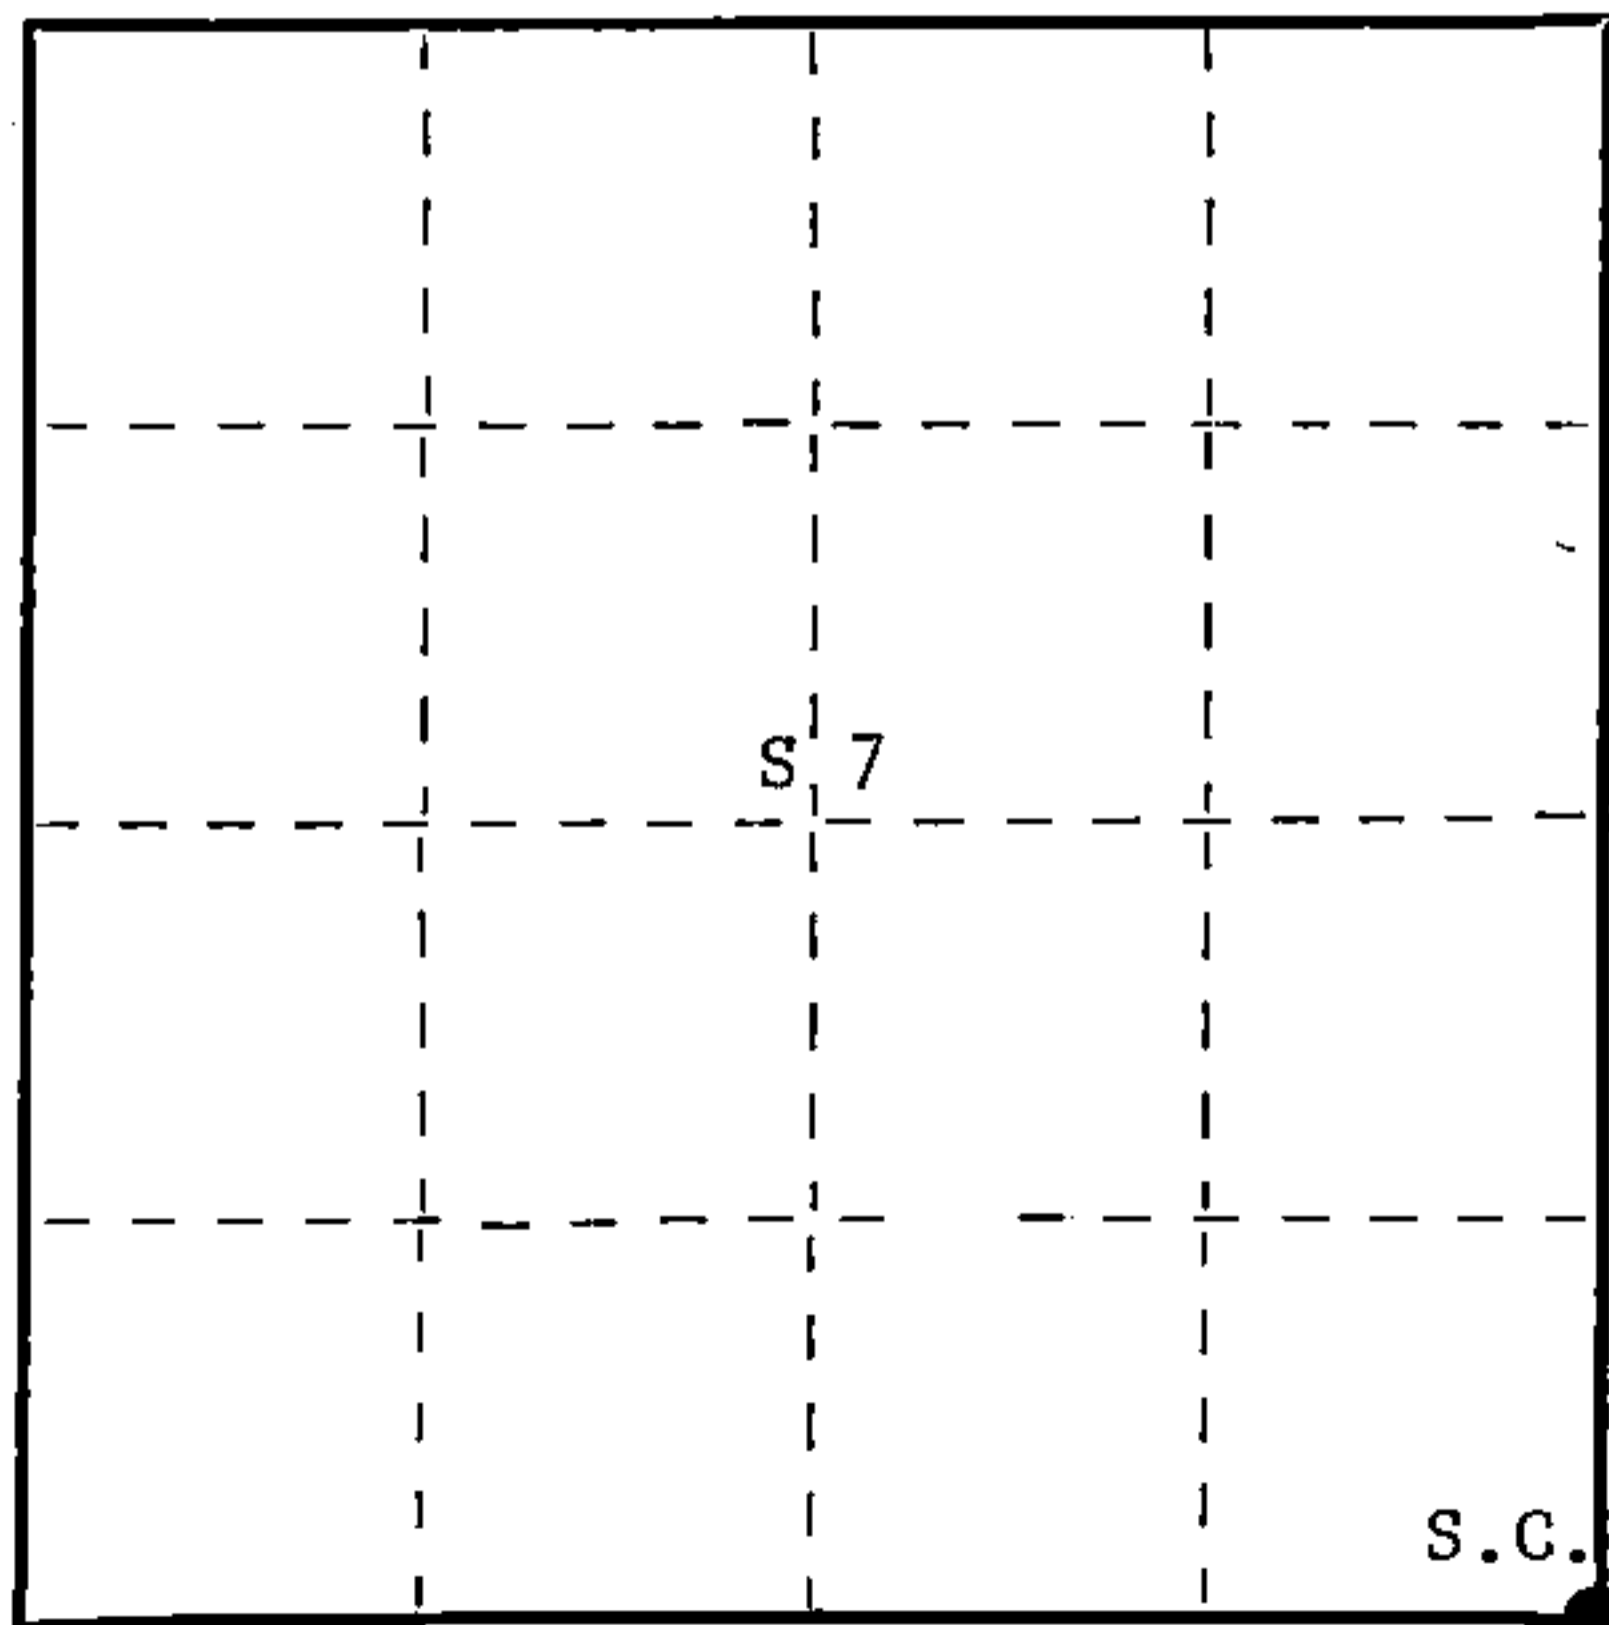

○ = Corner monument restored.

History of original corner establishment: Original corner established by J.W. Nowlin, Deputy Surveyor, in 1865, from which birch 15" bears N17°W 15 links, and birch 12" bears N50°E 20 links. This corner restored by Ray Leigh, Consolidated Forester, and Frank Hill in 1948 during cruising and mapping of this area. Corner was also recovered by J. Lindbloom in 1937, while doing similar mapping.

Description of corner evidence found: Recovered 4" cedar post, squared and scribed S7, S8, S17, and S18, in poor condition.

No evidence of any old BT's visible.

Description of monument and accessories I established to perpetuate the original location of this corner.

Replaced 4" cedar post with 2 1/2" Berntsen, A-1 Federal Monument, aluminum, with magnet, installed in cap and base. Pipe projects 18" above ground. Cap stamped -

NBT's - Sugar 10" N18°W 21 links, scribed SC BT
Sugar 6" S59°W 81 links, scribed SC BT
Sugar 9" S6°W 18.7 links, scribed SC BT

S498
T37N R14E
Sec. 7 | 8
18 | 17
1975

Pipe and BT's painted blue.

Dated at Argonne, Wis., this 22nd day of December, 1975

Signature *Philip T. Hansen* Title Registered Land Surveyor Registration No. S-498
(County Surveyor, Registered Land Surveyor, or other duly authorized official)

Office of Register of Deeds, County of Forest, I hereby certify that the within instrument was filed in this office for record on the 5th day of January, 1976 at 2:45 o'clock P.M.

DOCUMENT NUMBER -- 108496

EUGENE STATEZNY
(Register of Deeds)

By *Eileen Schmidt* Deputy

FORM 985 H. C. MILLER CO., MILWAUKEE

43714070000