

CERTIFIED LAND CORNER RESTORATION

Index No. H-25

H 25

State of Wisconsin }
County of Forest } ss.

History of original corner establishment:

No evidence of any previous corner.

I Daniel K. Pleoger, do hereby certify that on the 14th day of April, 1981, I found established S 1/16 corner of Sections 12 & 7 Township 37 North, Range 14 & 15 East, Fourth Principal Meridian, as described hereon; and that from this evidence I established a new monument and accessories as described hereon to perpetuate the original location of this corner.

Description of corner evidence found:

Total distance from section corner 12-13-7-8 T37N-R14&15E to 1/4 corner between sections 12 and 7 T37N-R14&15E is 2621.334 feet at bearing N0-11-31W. Set S 1/16 1310.667 feet intermediate.

Resident witnesses:

Description of monument and accessories I established to perpetuate the original location of this corner.


Set a 1-1/2" iron pipe with 2" diameter brass cap stamped: Monument projects 12" above ground.

Marked NBT's:

Cedar 10" S52°W 35.35 feet
Tamarack 7" N47°E 19.38 feet
scribed 1/16 BT

S1537
R14E T37N R15E
S 1/16 12+7
CPI 1981

FORM 985 H. C. MILLER CO., MILWAUKEE

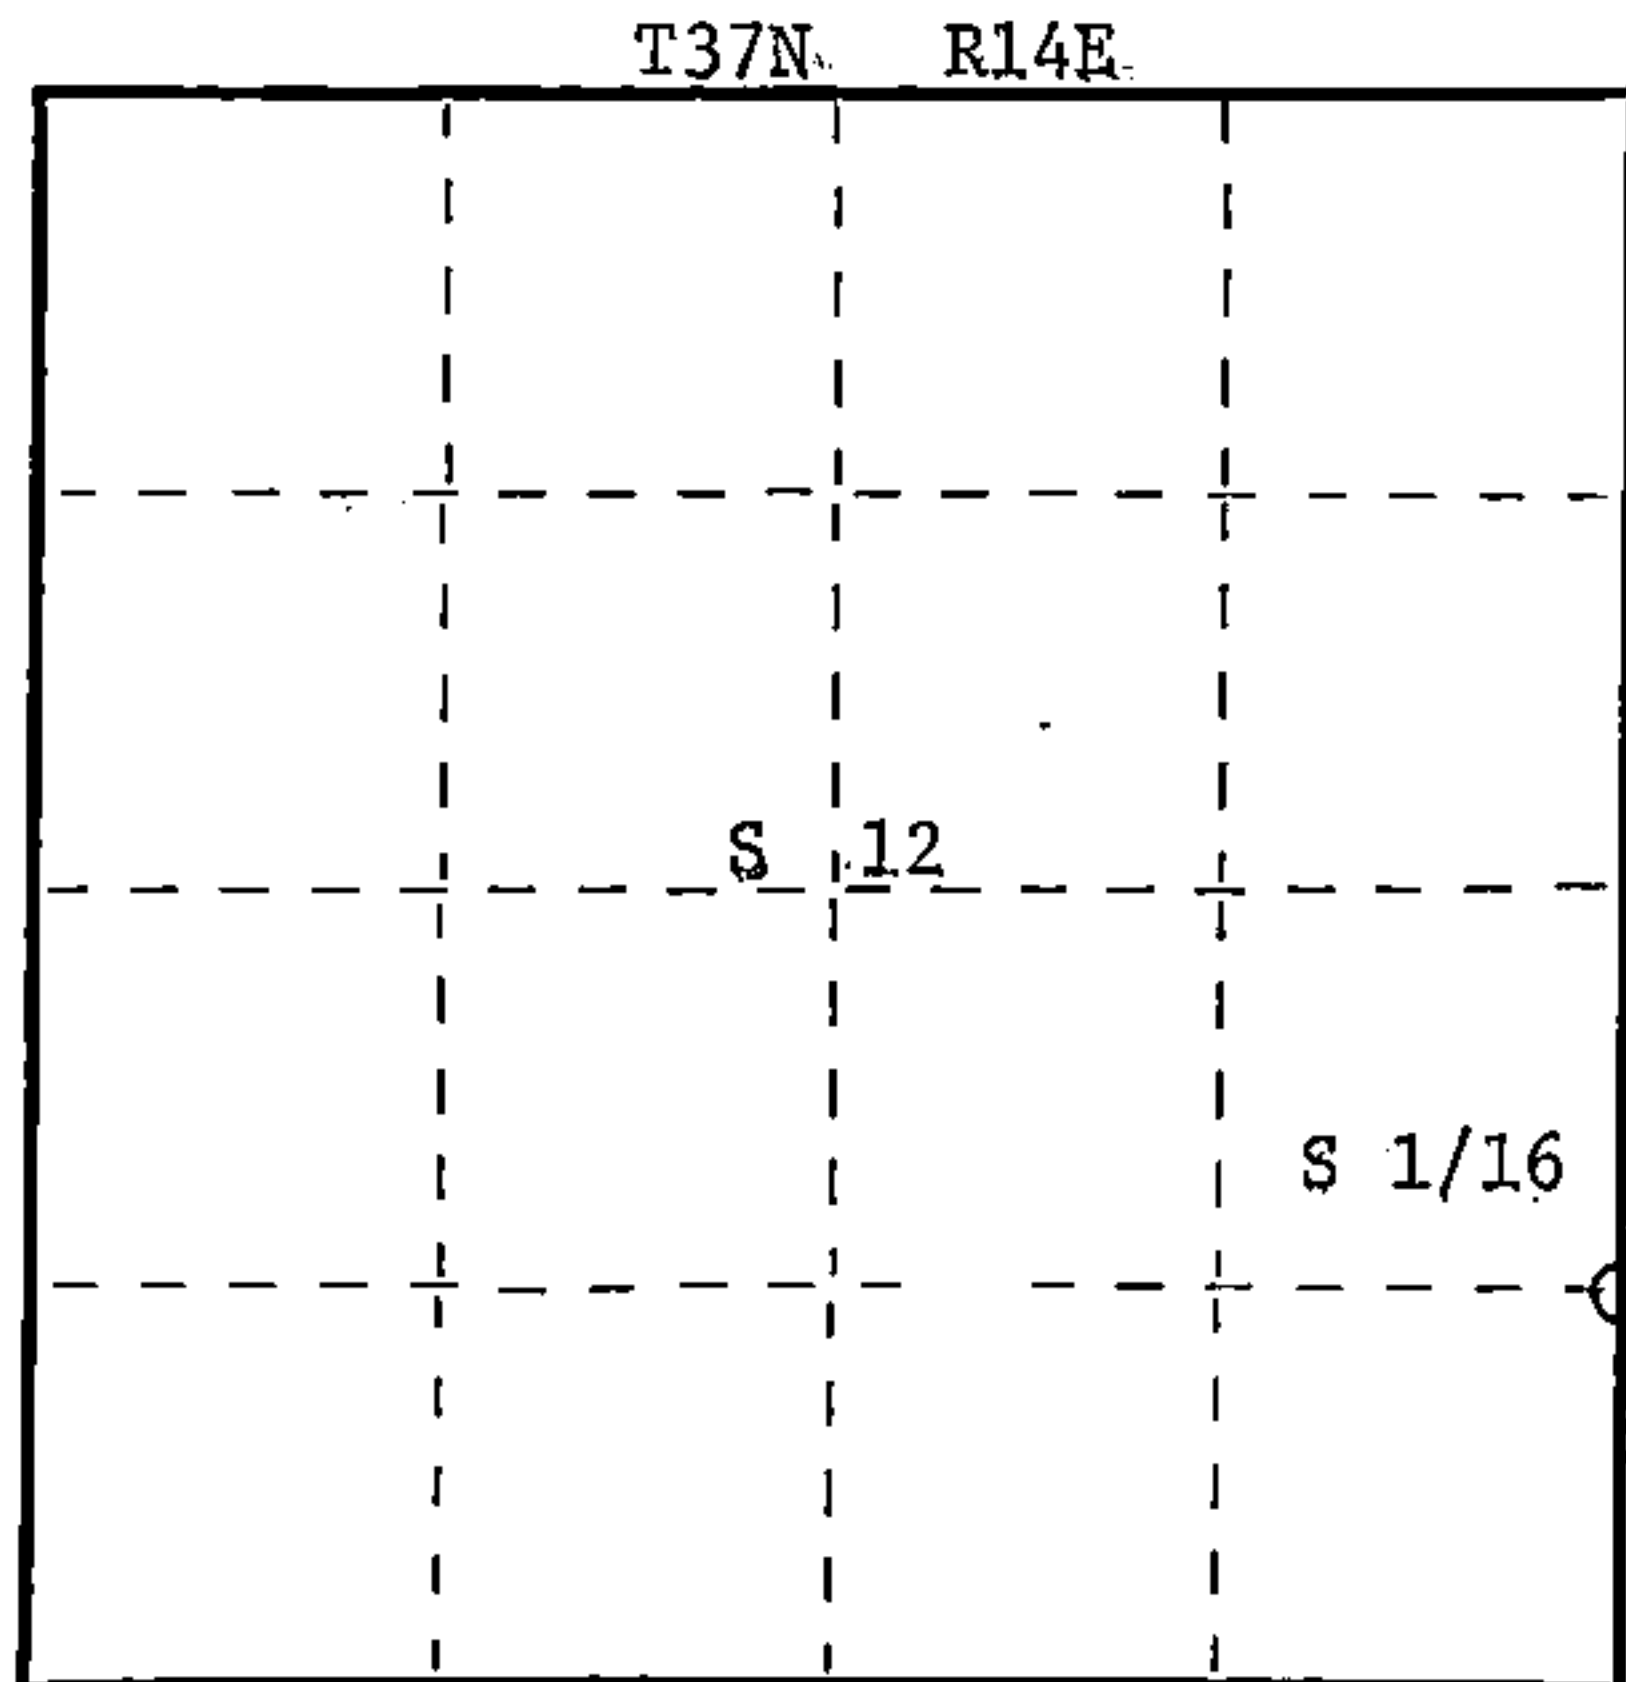

○ = Corner monument restored.

Dated at Rhinelander, Wis., this 24th day of June, 1981

Signature Daniel K. Pleoger Title Registered Land Surveyor Registration No. 1537
(County Surveyor, Registered Land Surveyor, or other duly authorized official)

Office of Register of Deeds, County of Forest, I hereby certify that the within instrument was filed in this office for record on the 1st day of July, 1981 at 8:30 o'clock A. M.

Eugene Stutzman
(Register of Deeds)
By _____ Deputy

DOCUMENT NO. 120030

43714121000