

CERTIFIED LAND CORNER RESTORATION


Index No. G-25

G 25


State of Wisconsin }
County of Forest } ss.

I Daniel K. Plegger, do hereby certify that on the 4th day of March, 19 81, I found evidence of the Quarter corner of Sections 12 & 7 Township 37 North, Range 14 & 15 East, Fourth Principal Meridian, as described hereon; and that from this evidence I established a new monument and accessories as described hereon to perpetuate the original location of this corner.

Resident witnesses:

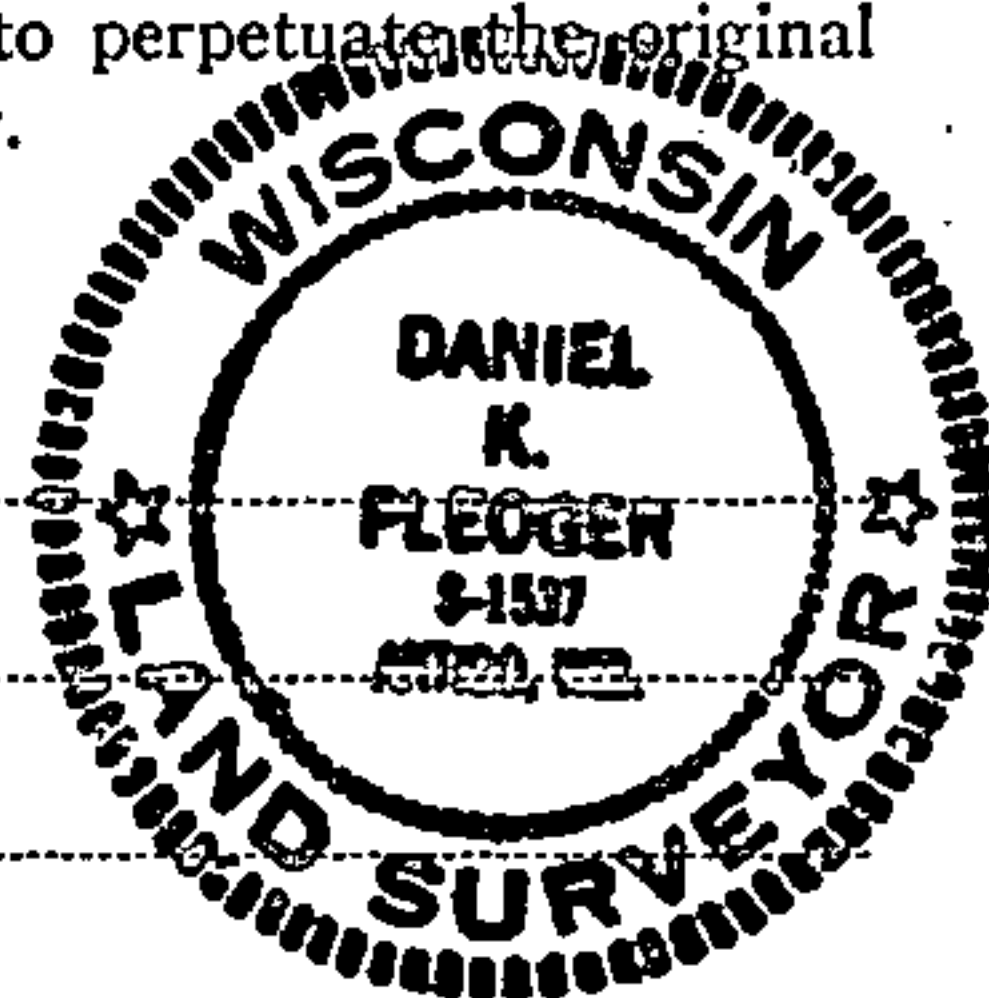

FORM 985 R. C. MILLER CO., MILWAUKEE

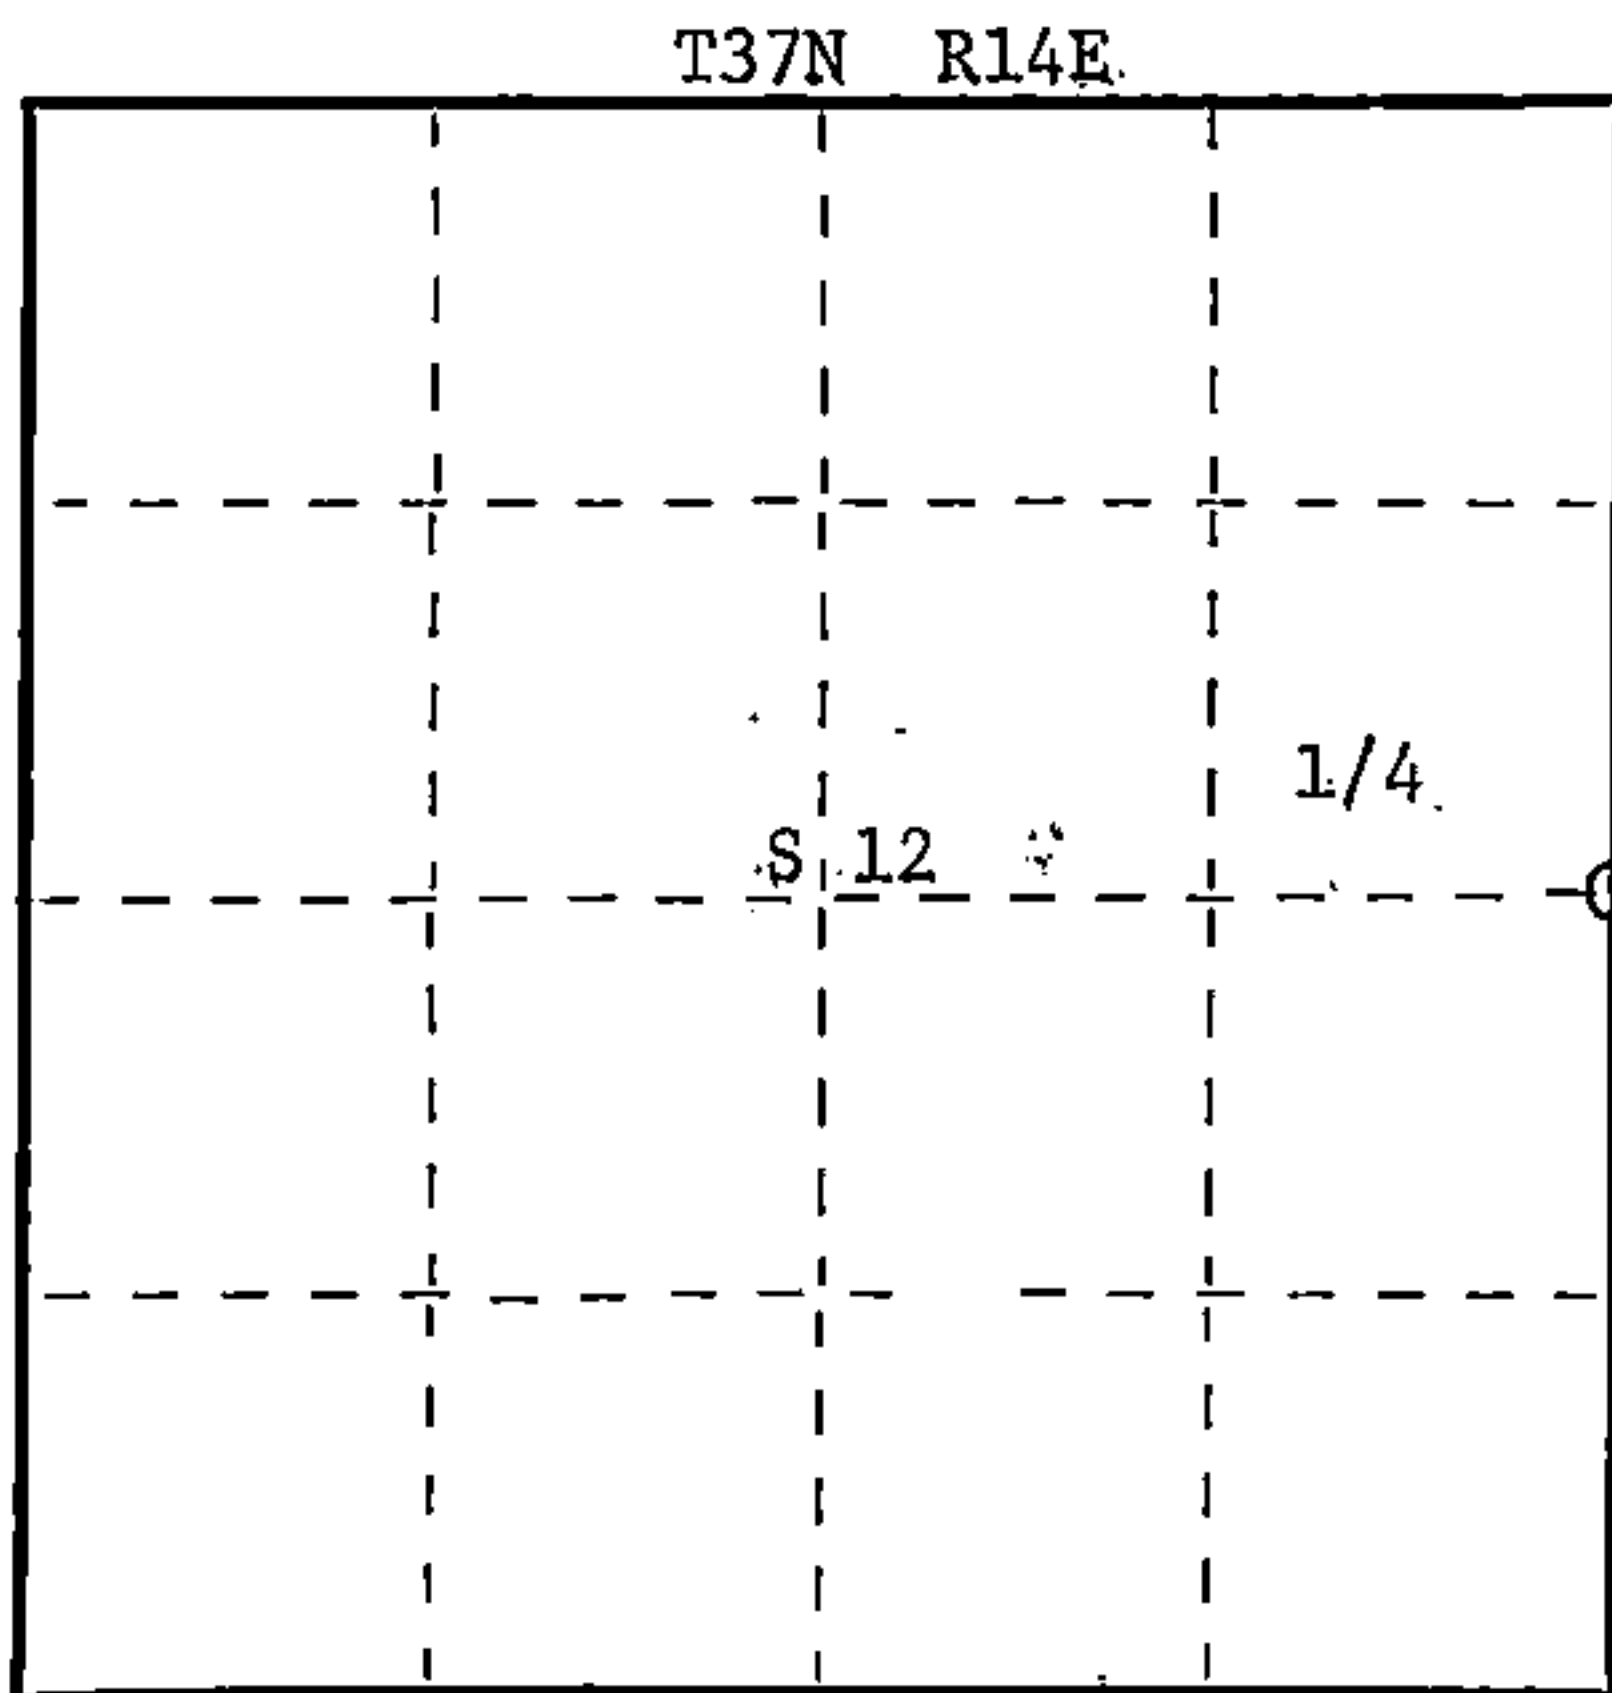

○ = Corner monument restored.

History of original corner establishment:

Original corner established by A. Curtis, deputy gov. surveyor, in 1857 from which Tamarack 10" bears N44°W 43 links and Tamarack 9" 6 links.

Description of corner evidence found:

Ran traverse from section 12-13-7-18 T37N-R14 & 15E to section corner 1-12-6-7 T37N-R14 & 15E for a distance of 5242.668 feet at bearing, N0-11-31W. Set 1/4 corner 2621.334 feet intermediate.

Description of monument and accessories I established to perpetuate the original location of this corner.

Set a 2-1/2" Federal A-1 monument (Forest County) with alloy cap - stamped: Projecting 6" above ground.

Marked NBT's:

Cedar 6" S72°E 11.30 feet
Cedar 7" S88°W 12.60 feet
Cedar 7" N16°E 4.60 feet
scribed 1/4 B.T.

R14E T37N R15E
1/4 12+7
S1537-1981

Dated at Rhinelander, Wis., this 22nd day of June, 19 81

Signature Daniel K. Plegger Title Registered Land Surveyor Registration No. 1537
(County Surveyor/Registered Land Surveyor, or other duly authorized official)

Office of Register of Deeds, County of Forest, I hereby certify that the within instrument was filed in this office for record on the 1st day of July, 19 81 at 8:30 o'clock A. M.

Register of Deeds
By Deputy

DOCUMENT NO.
120029

43714 122000