


CERTIFIED LAND CORNER RESTORATION

R-9 Index No. **R 9**

State of Wisconsin }
County of Forest } ss.


I Philip T. Hansen, do hereby certify that on the 15th day of September, 1975, I found evidence of the Section corner of S20, 21, 28, 29 Township 37 North, Range 14 East, Fourth Principal Meridian, as described hereon; and that from this evidence I established a new monument and accessories as described hereon to perpetuate the original location of this corner.

Resident witnesses:

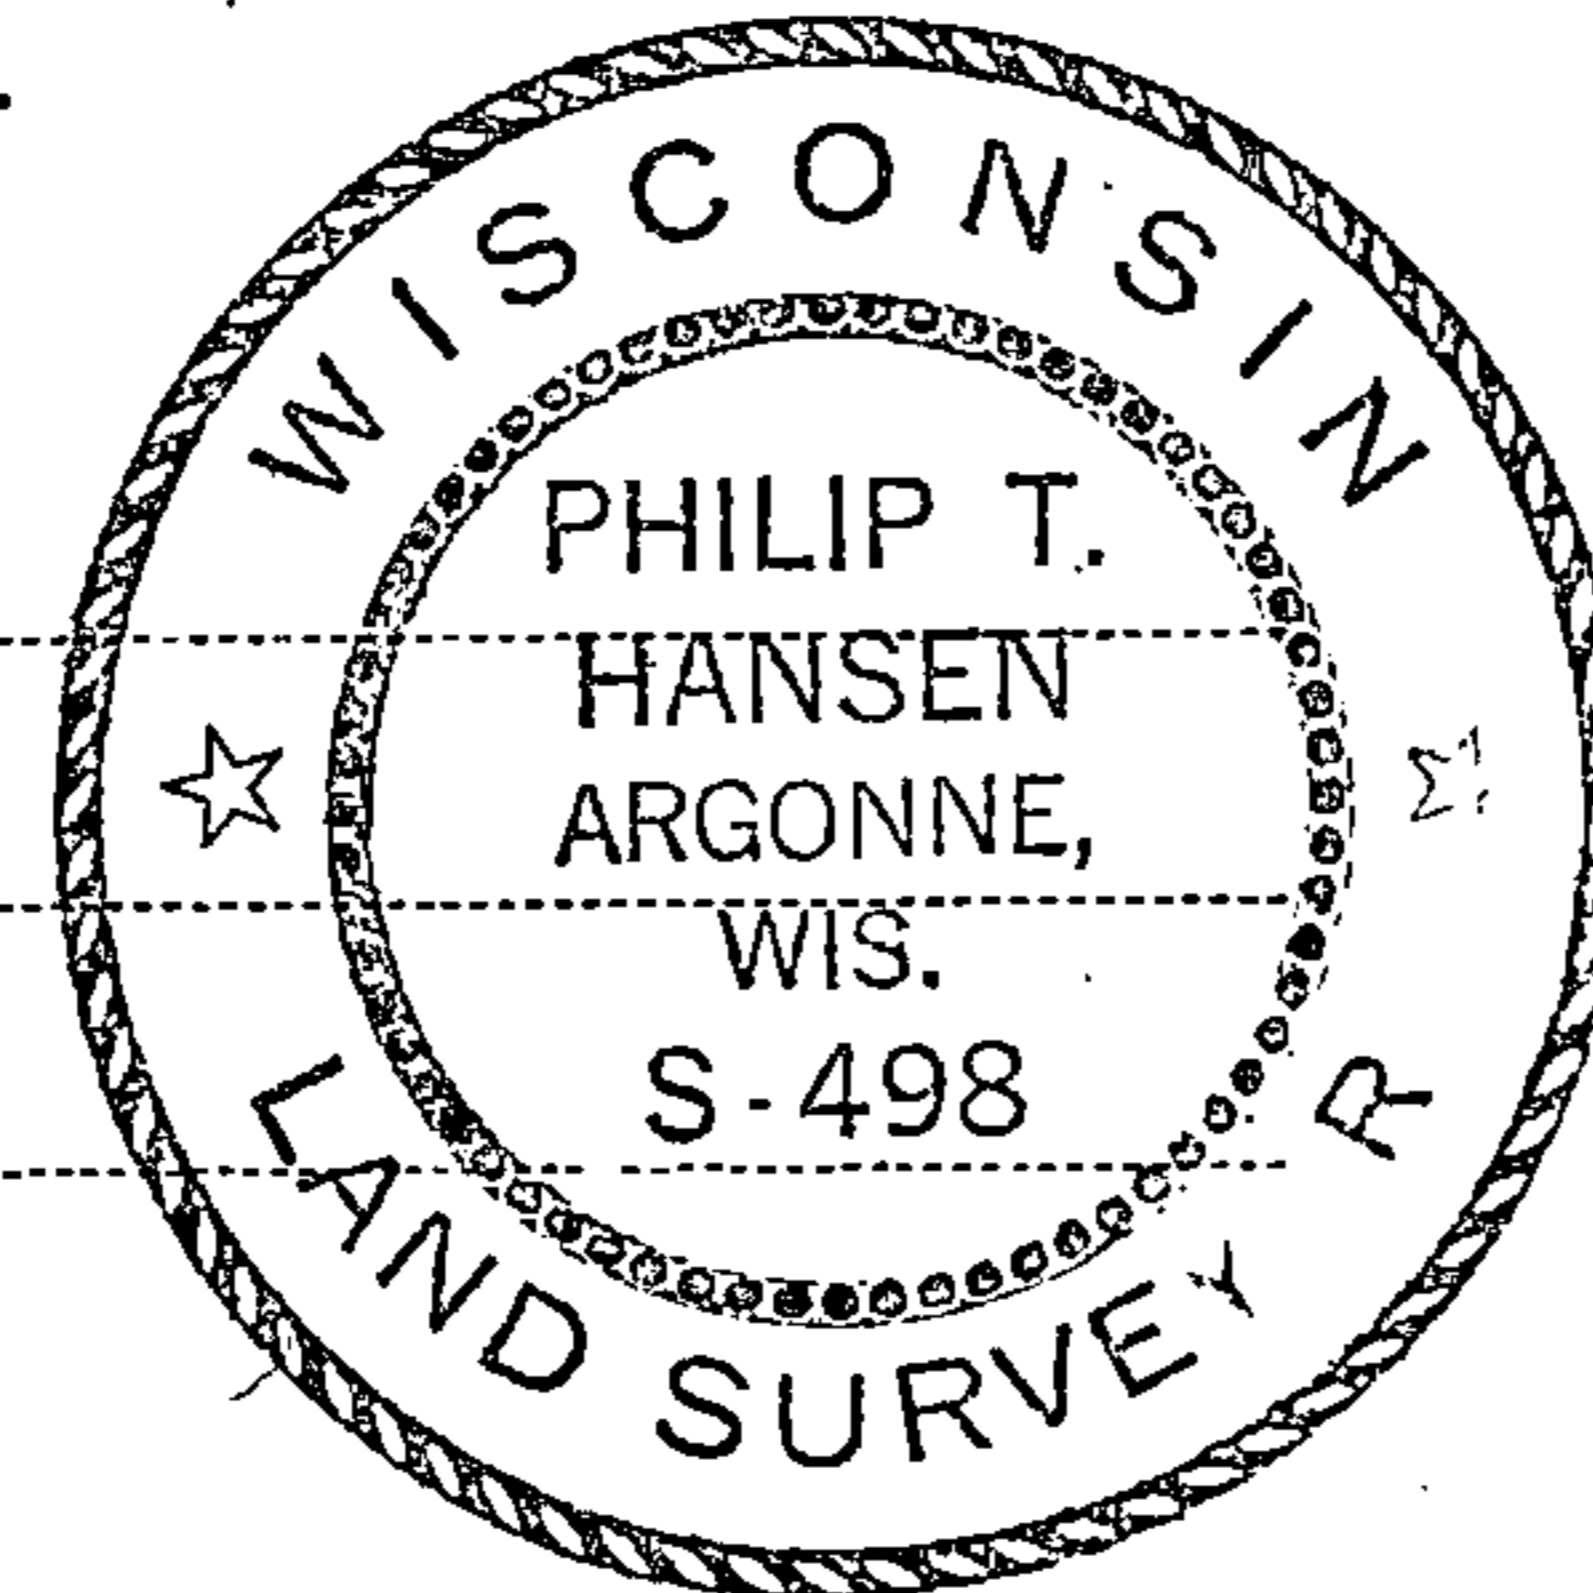

FORM 985 H. C. MILLER CO., MILWAUKEE

T37N R14E

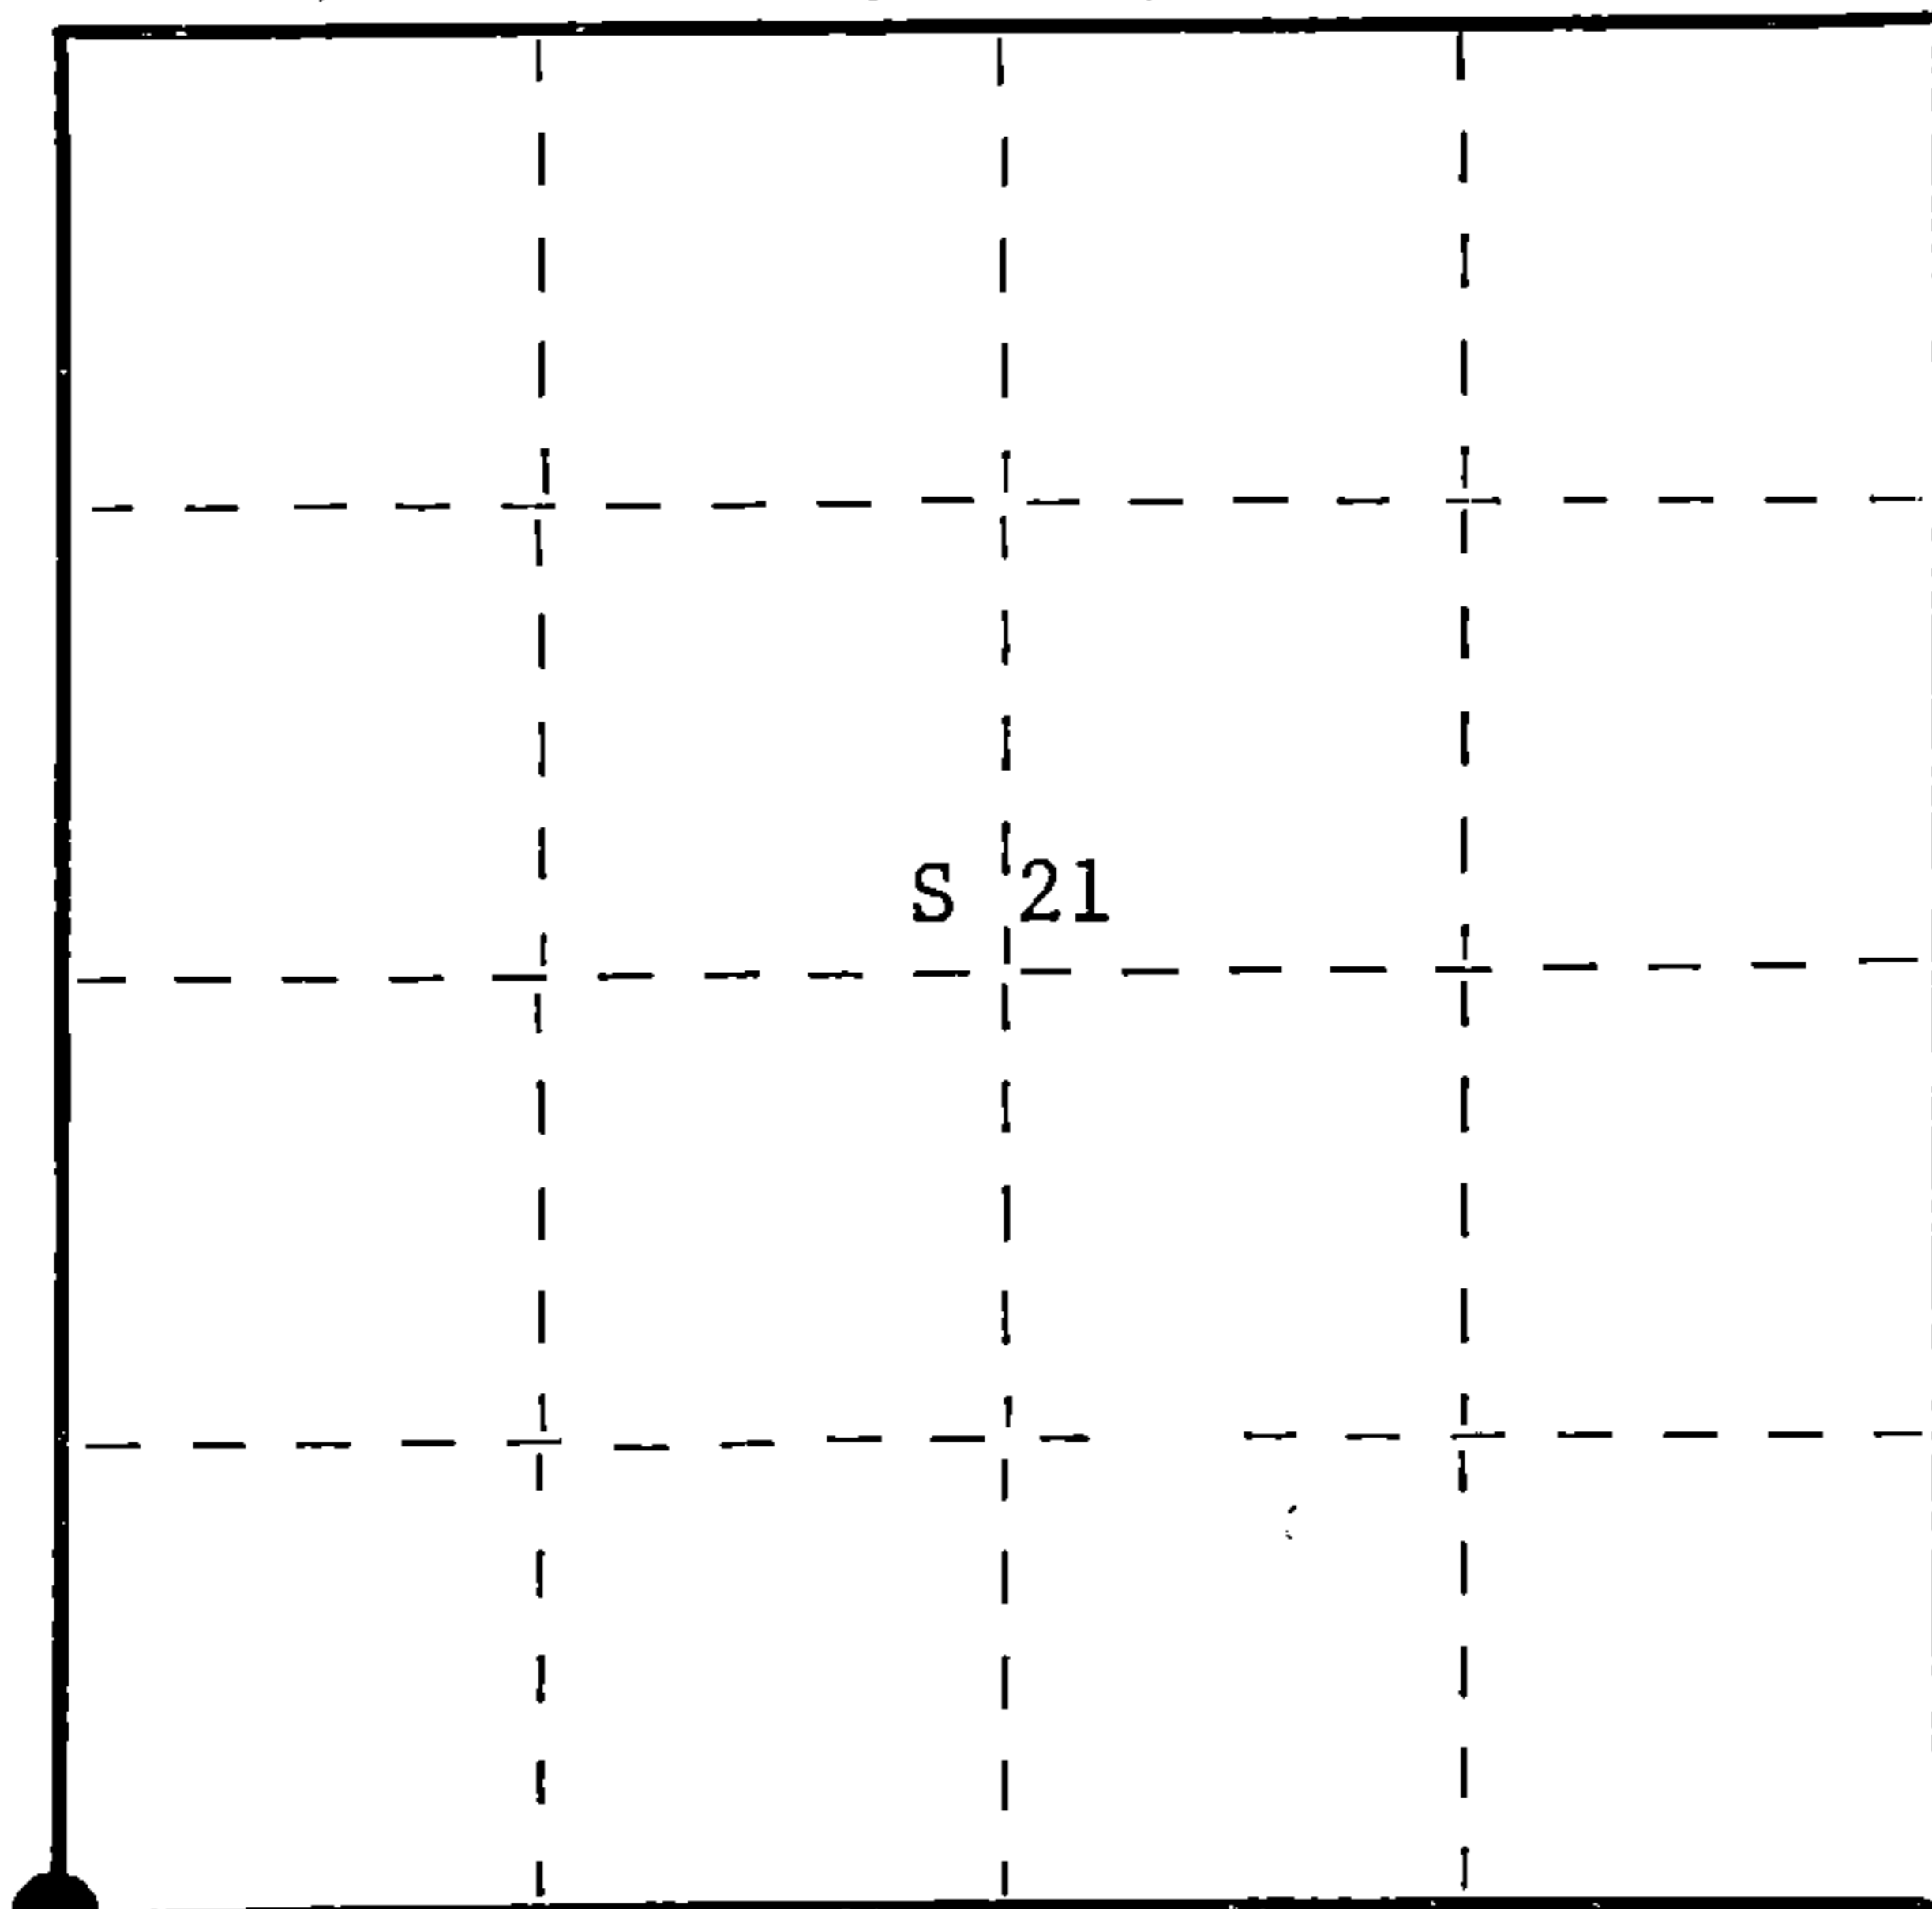

○ = Corner monument restored.

History of original corner establishment: Original Corner established by James L. Nowlin, Government Deputy Surveyor, in 1865, from which aspen 10" N34°E 8 links and aspen 12" S27°W 15 links. This corner had been recovered in 1930 by Consolidated Papers, Inc. foresters and has been perpetuated by Company foresters and P.T. Hansen, Registered Land Surveyor. This corner was marked with old wooden stake in 1930 when lines were run for acquisition and mapping.

Description of corner evidence found:

Recovered 3" squared hardwood stake, painted blue, which had rotted off and fallen down. Extracted point of stake from the ground. Trees around corner had been painted blue.

Description of monument and accessories I established to perpetuate the original location of this corner.

Replaced point of old stake with 2-1/2" Berntsen A-1 Federal Monument, aluminum pipe with magnet installed in cap and base. This corner projects 6" above ground. Cap stamped -

NBT's - Sugar maple 7" N23°W 61.3 links scribed SC BT. S498
White birch 9" S61°W 20.7 links scribed SC BT. T37N R14E
Elm. 12" N37°E 102.7 links scribed SC BT.

All accessories painted blue.

S20 | S21
S29 | S28
1975

Dated at Argonne, Wis., this 24th day of September, 1975

Signature Philip T. Hansen Title Registered Land Surveyor Registration No. S-498
(County Surveyor, Registered Land Surveyor, or other duly authorized official)

Office of Register of Deeds, County of Forest, I hereby certify that the within instrument was filed in this office for record on the 30th day of September, 1975 at 3:15 o'clock P.M.

Eugene Staszny (Register of Deeds) Deputy

DOCUMENT NUMBER 107874

4271420000