

CERTIFIED LAND CORNER RESTORATION


Index No. R-23

R23


State of Wisconsin }  
County of Forest } ss.

I Daniel K. Pleoger, do hereby certify that on the 14th day of April, 19 81, I ~~found~~ established the Quarter corner of Sections 24 & 25 Township 37, North, Range 14 East, Fourth Principal Meridian, as described hereon; and that from this evidence I established a new monument and accessories as described hereon to perpetuate the original location of this corner.

Resident witnesses:

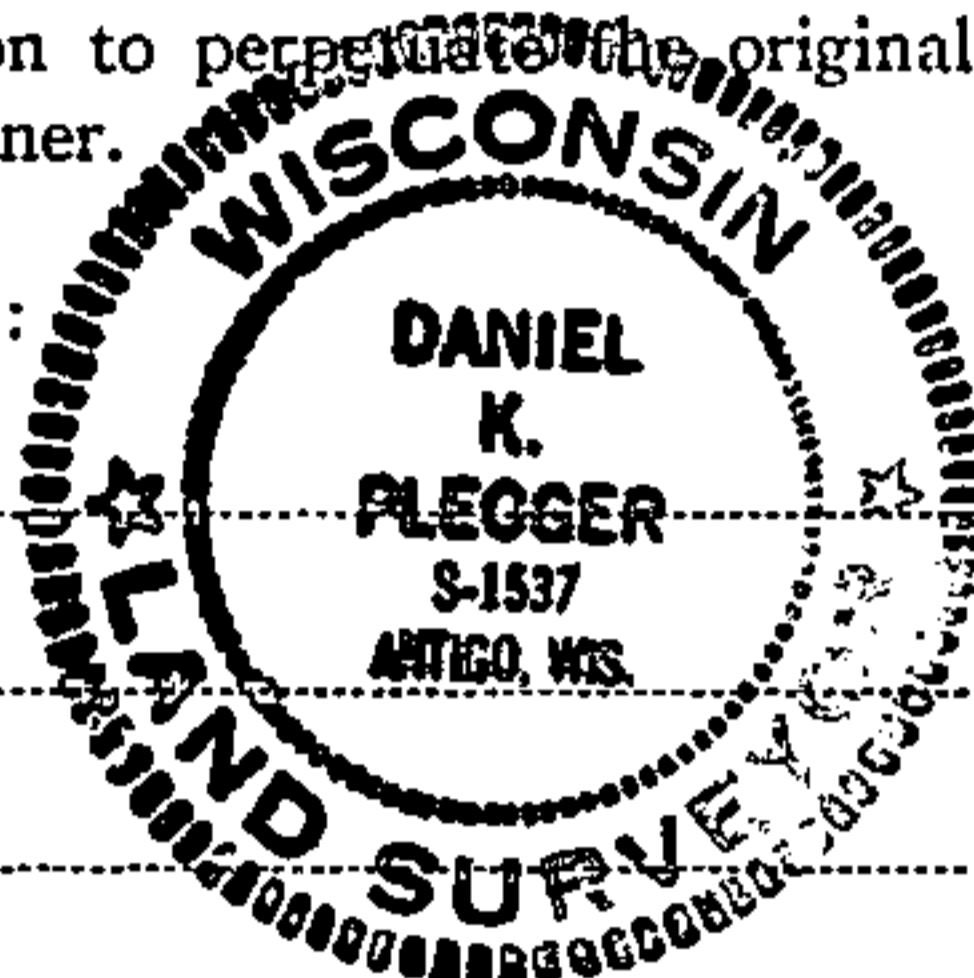

FORM 985 W. C. MILLER CO., MILWAUKEE

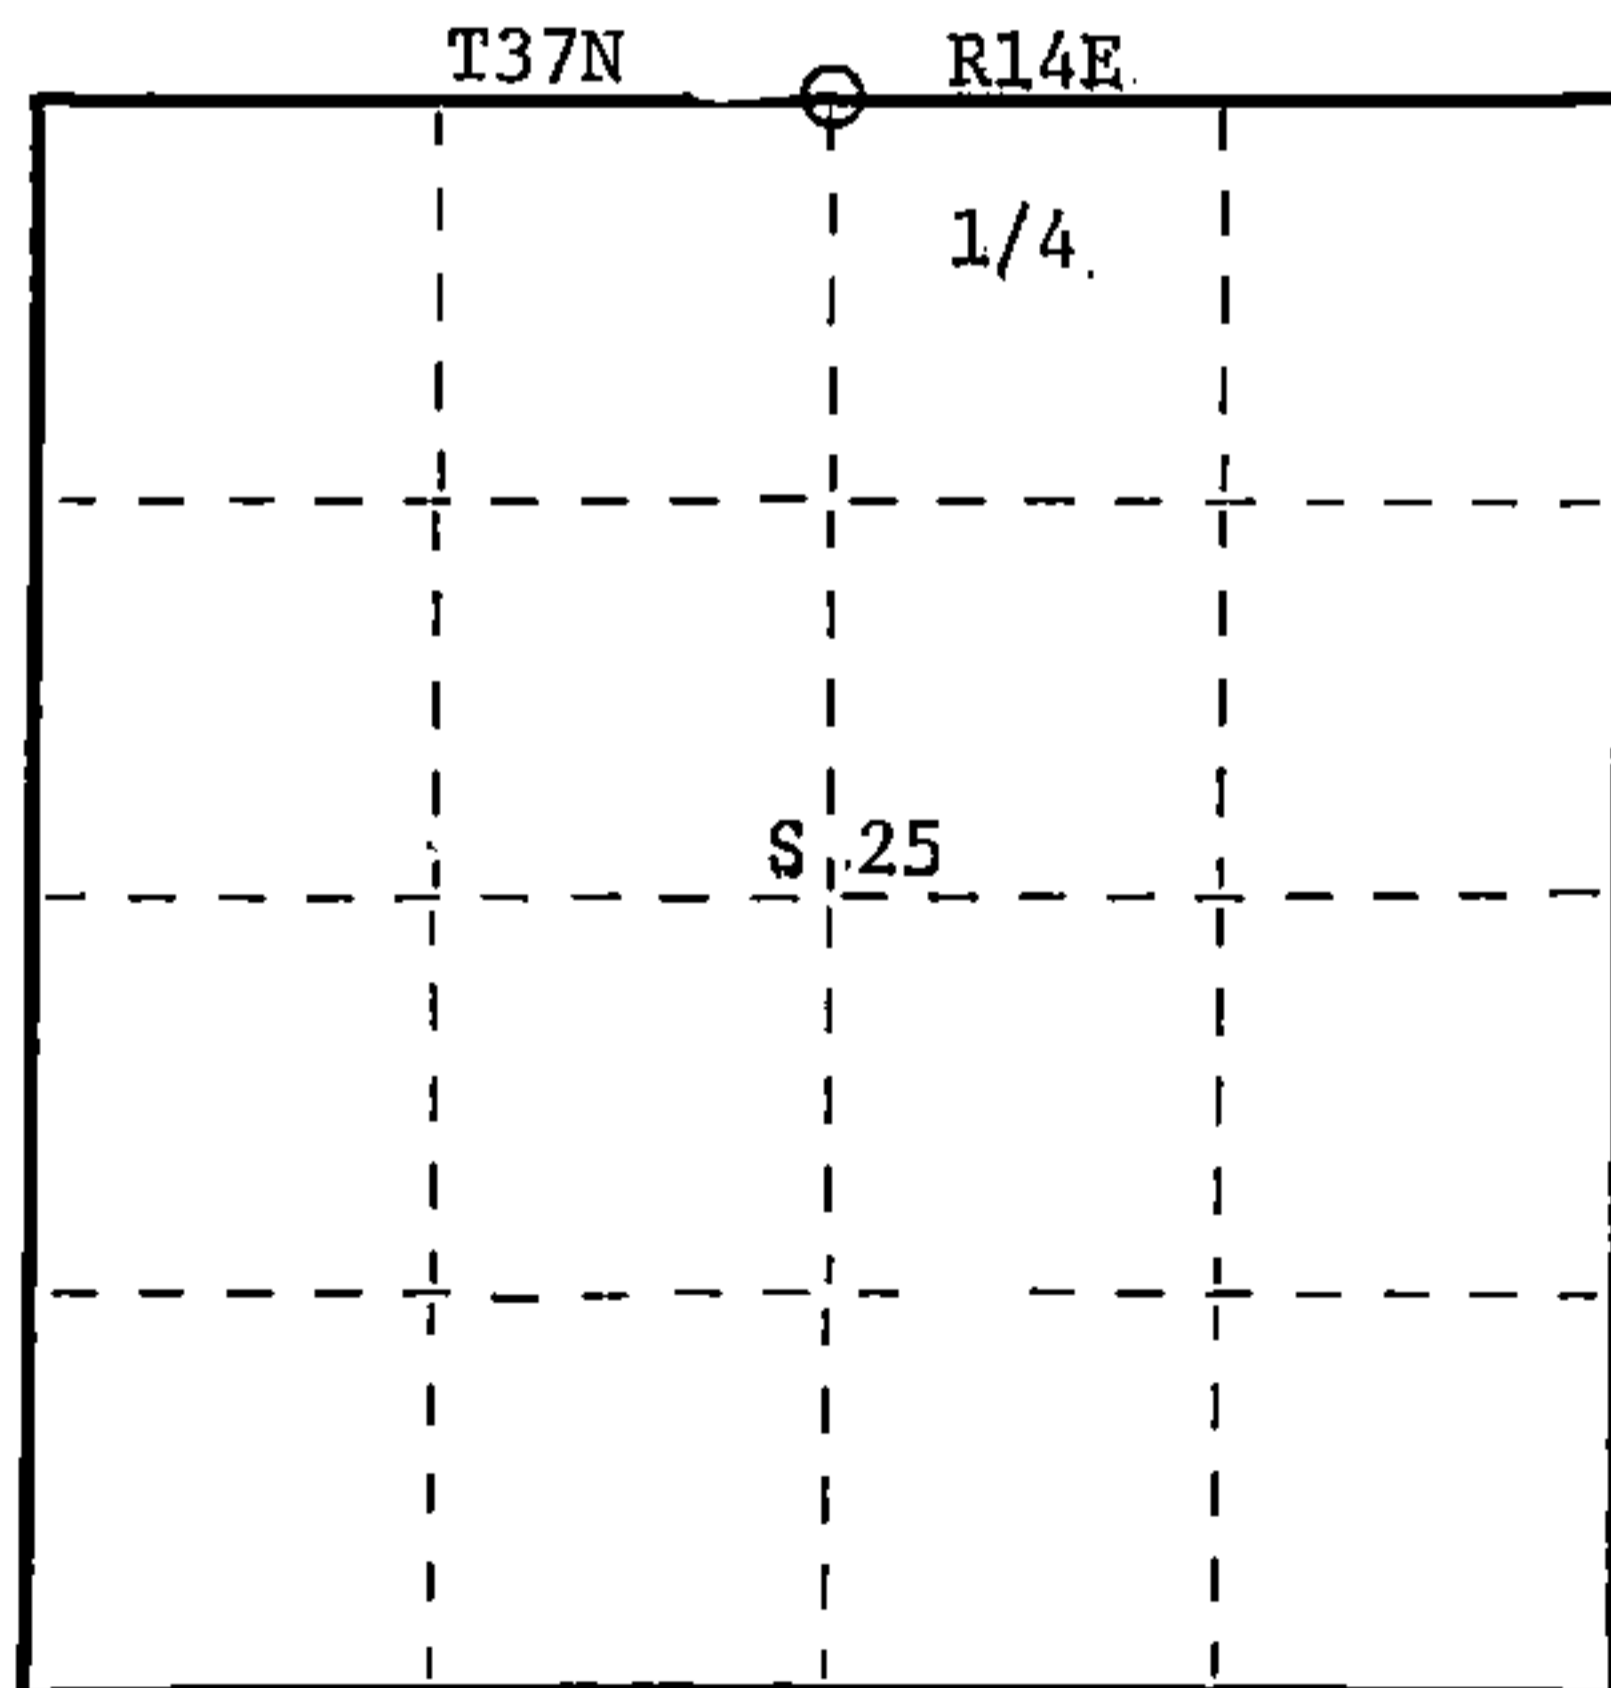

○ = Corner monument restored.

History of original corner establishment:

Original corner established by J. Nowlin, government deputy surveyor, in 1865 from which Aspen 4" bears N12°W 30 links and White Pine 8" bears S46°E 50 links.

Description of corner evidence found:

Total distance from section corner 24-25-19-30 T37N-R14 & 15E to section corner 23-24-25-26 is 5419.16 feet at bearing N86-31-45W. Set 1/4 corner 2709.58 feet intermediate.

Description of monument and accessories I established to perpetuate the original location of this corner.

Set a 2-1/2" aluminum Federal A-1 monument with alloy cap - stamped: Monument projects 6" above ground.

Marked NBT's:

Sugar 6" N14°W 57.53 feet  
Sugar 6" N62°W 42.46 feet  
Sugar 6" S48°E 31.21 feet  
scribed 1/4 B.T.

T37N R14E  
1/4 S+24  
S 25  
S1537-1981

Dated at Rhinelander, Wis., this 22nd day of June, 19 81.

Signature Daniel K. Pleoger Title Registered Land Surveyor - Registration No. 1537  
(County Surveyor, Registered Land Surveyor, or other duly authorized official)

Office of Register of Deeds, County of Forest, I hereby certify that the within instrument was filed in this office for record on the 1st day of July, 19 81 at 8:30 o'clock A. M.

Eugene Staszny  
(Register of Deeds)  
By \_\_\_\_\_ Deputy

DOCUMENT NO.  
120035

4371424 0020