

CERTIFIED LAND CORNER RESTORATION


Index No. V-25

V25

State of Wisconsin }
County of Forest } ss.


I Daniel K. Plegger, do hereby certify that on the 7th day of May, 1981, I found ~~existing~~ established corner of Sections 25-36-30-31 Township 37, North, Range 14 and 15, Fourth Principal Meridian, as described hereon; and that from this evidence I established a new monument and accessories as described hereon to perpetuate the original location of this corner.

Resident witnesses:

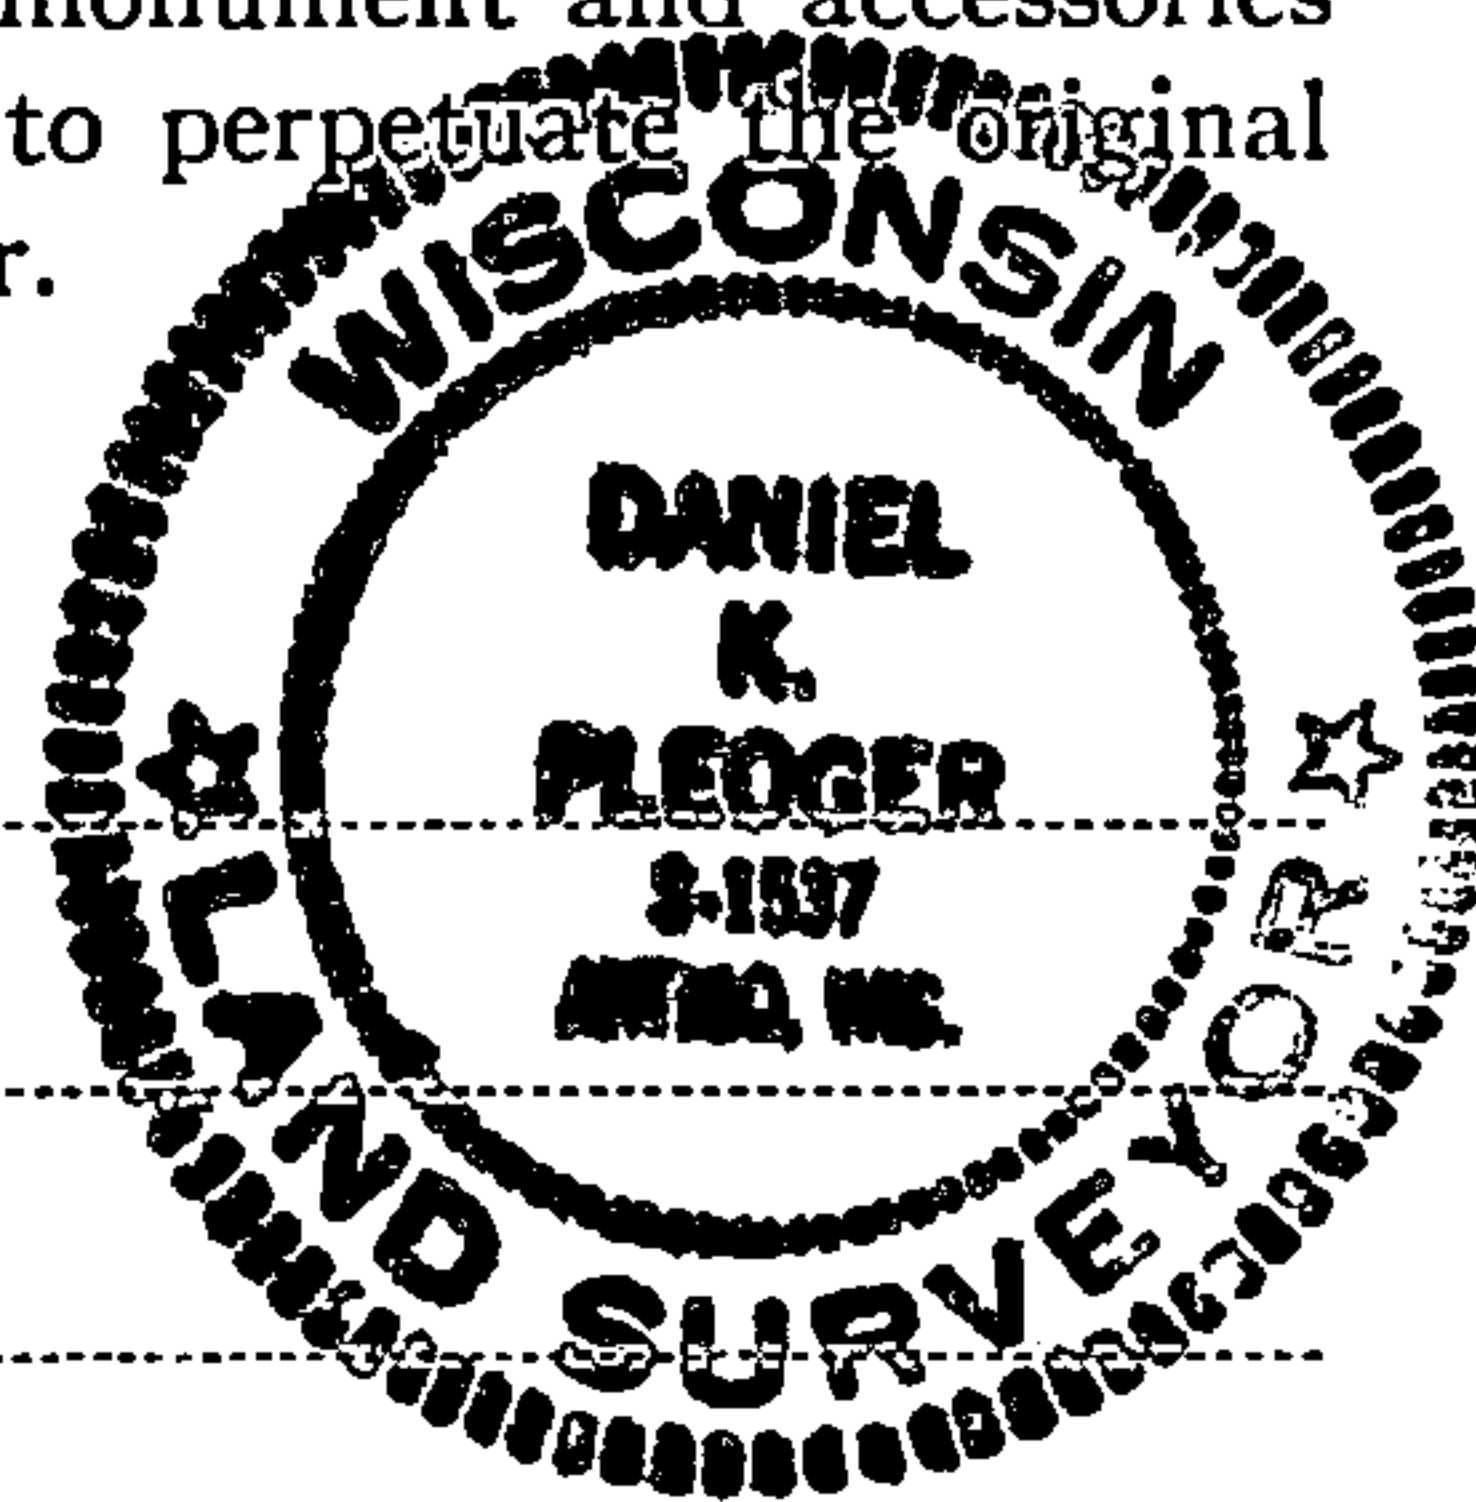

FORM 985 K. C. MILLER CO., MILWAUKEE

T37N R14E

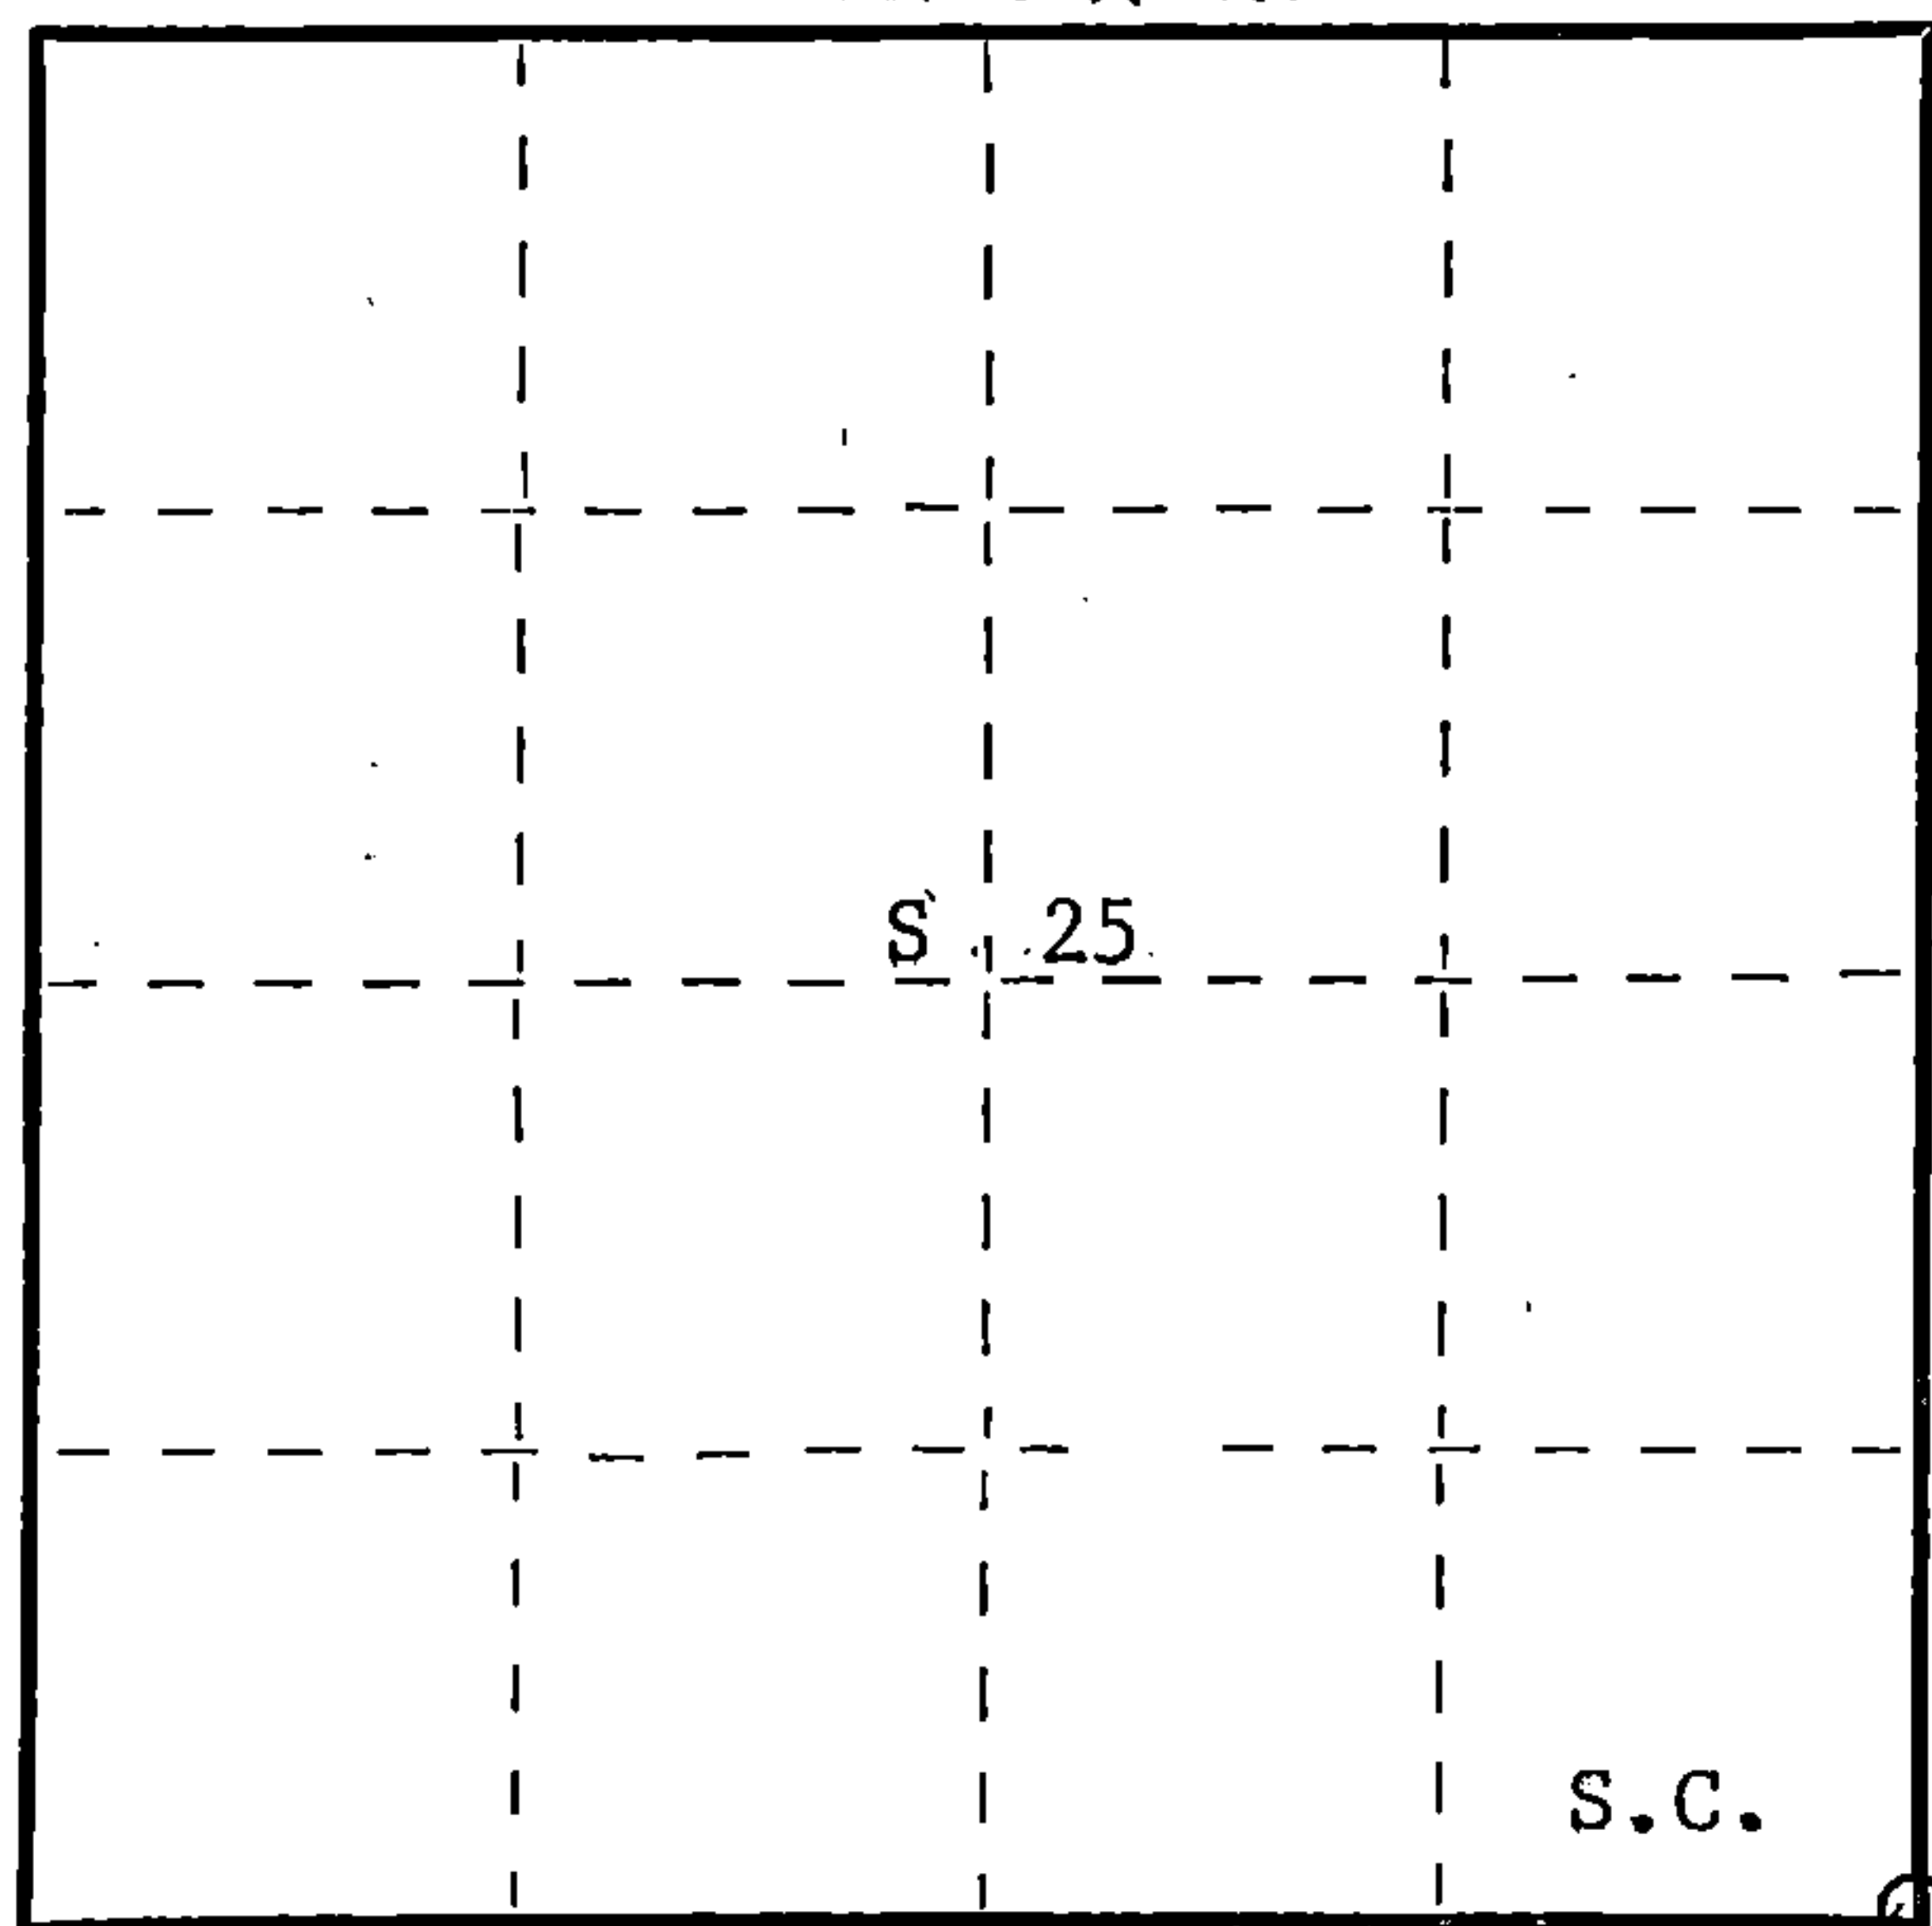

○ = Corner monument restored.

History of original corner establishment:

Original corner established by Alfred Millard, government deputy surveyor, in 1857 from which Aspen 8" bears N87°W 25 links and Aspen 10" bears N28°E 23 links - Aspen 8" S50°E 41 links.

Description of corner evidence found:

Ran survey from township corner 1-6-31-36 T36N&37N-R 14&15 E to 1/4 corner between sections 25 and 30 T37N-R 14&15 E for a total distance of 7905.762 feet at bearing N0-09-59W, original distance was 7920 feet. Set section corner 25-36-30-31 N0-09-59W 5270.509 feet of township corner and S0-09-59E 2635.254 feet of 1/4 corner between sections 25 and 30.

Description of monument and accessories I established to perpetuate the original location of this corner.

Set a railroad spike 4.0 feet south of centerline in C.T.H. "C" for true corner.
Set a 2-1/2" aluminum federal A-1 monument for witness corner - stamped:
Monument projects 12" above ground.
Marked NBT to true corner.
Maple 12" S26°E 86.47 feet
Maple 8" S33°W 96.38 feet
scribed S.C. B.T.
B.O. - R.O.W. post N12W 45.70 feet.

R14E T37N R15E
S.C. 25+30
36+31
N. 70 ft. to Cor.
S1537 - 1981

Dated at Rhinelander, Wis., this 23rd day of June, 1981.

Signature *Daniel K. Plegger* Title Registered Land Surveyor Registration No. 1537
(County Surveyor, Registered Land Surveyor, or other duly authorized official)

Office of Register of Deeds, County of Forest, I hereby certify that the within instrument was filed in this office for record on the 1st day of July, 1981 at 8:30 o'clock A.M.

Eugene Stutzman
(Register of Deeds)
By _____ Deputy

DOCUMENT NO.
120039

43714750000