

CERTIFIED LAND CORNER RESTORATION

Index No. **V23**


State of Wisconsin }  
County of Forest } ss.

I, Philip T. Hansen, do hereby certify that on the 26th day of September, 19 75, I found evidence of the Quarter corner of Sections 25 & 36 Township 37, North, Range 14 East, Fourth Principal Meridian, as described hereon; and that from this evidence I established a new monument and accessories as described hereon to perpetuate the original location of this corner.


Resident witnesses:

Glen Barker

Jim Clafin

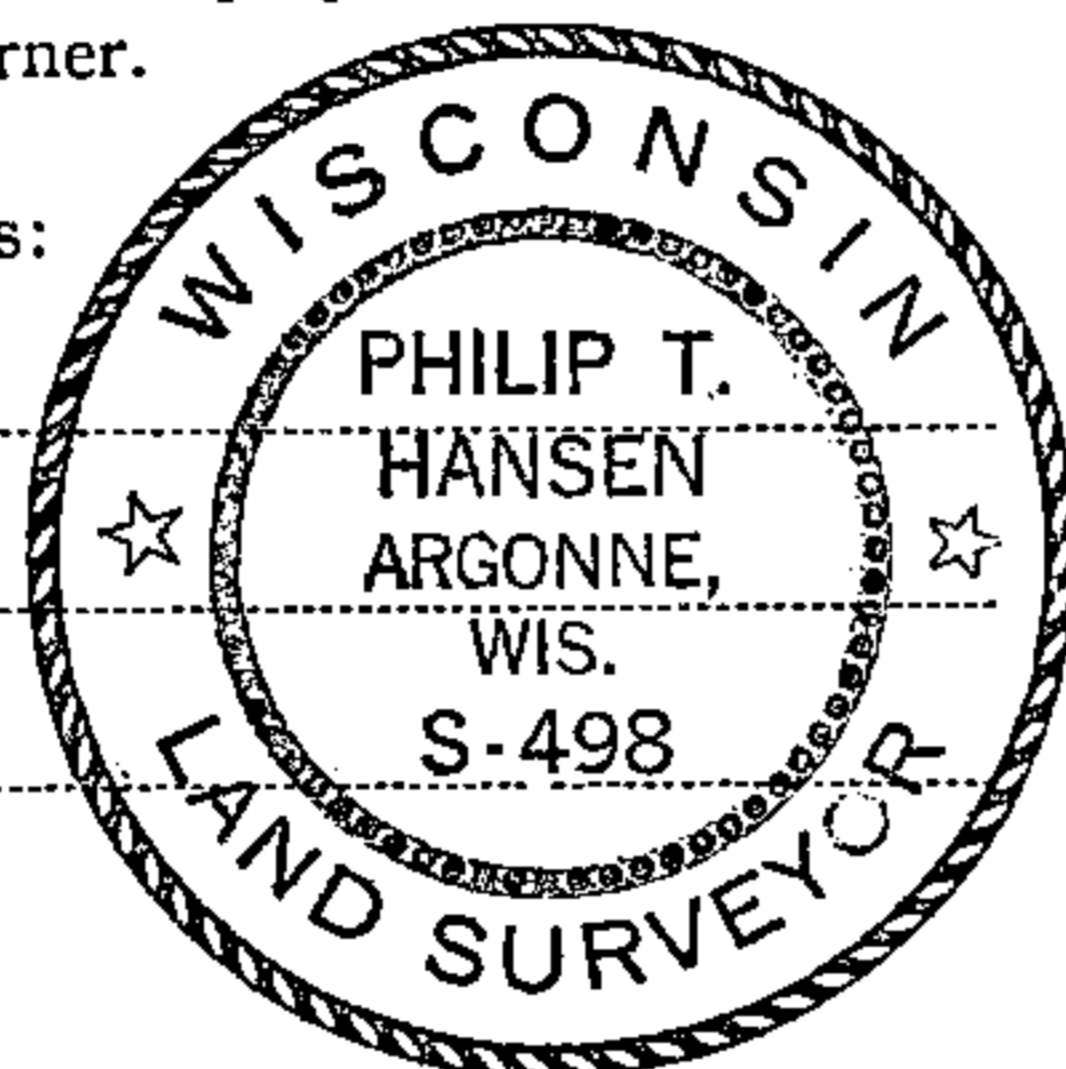

T37N R14E

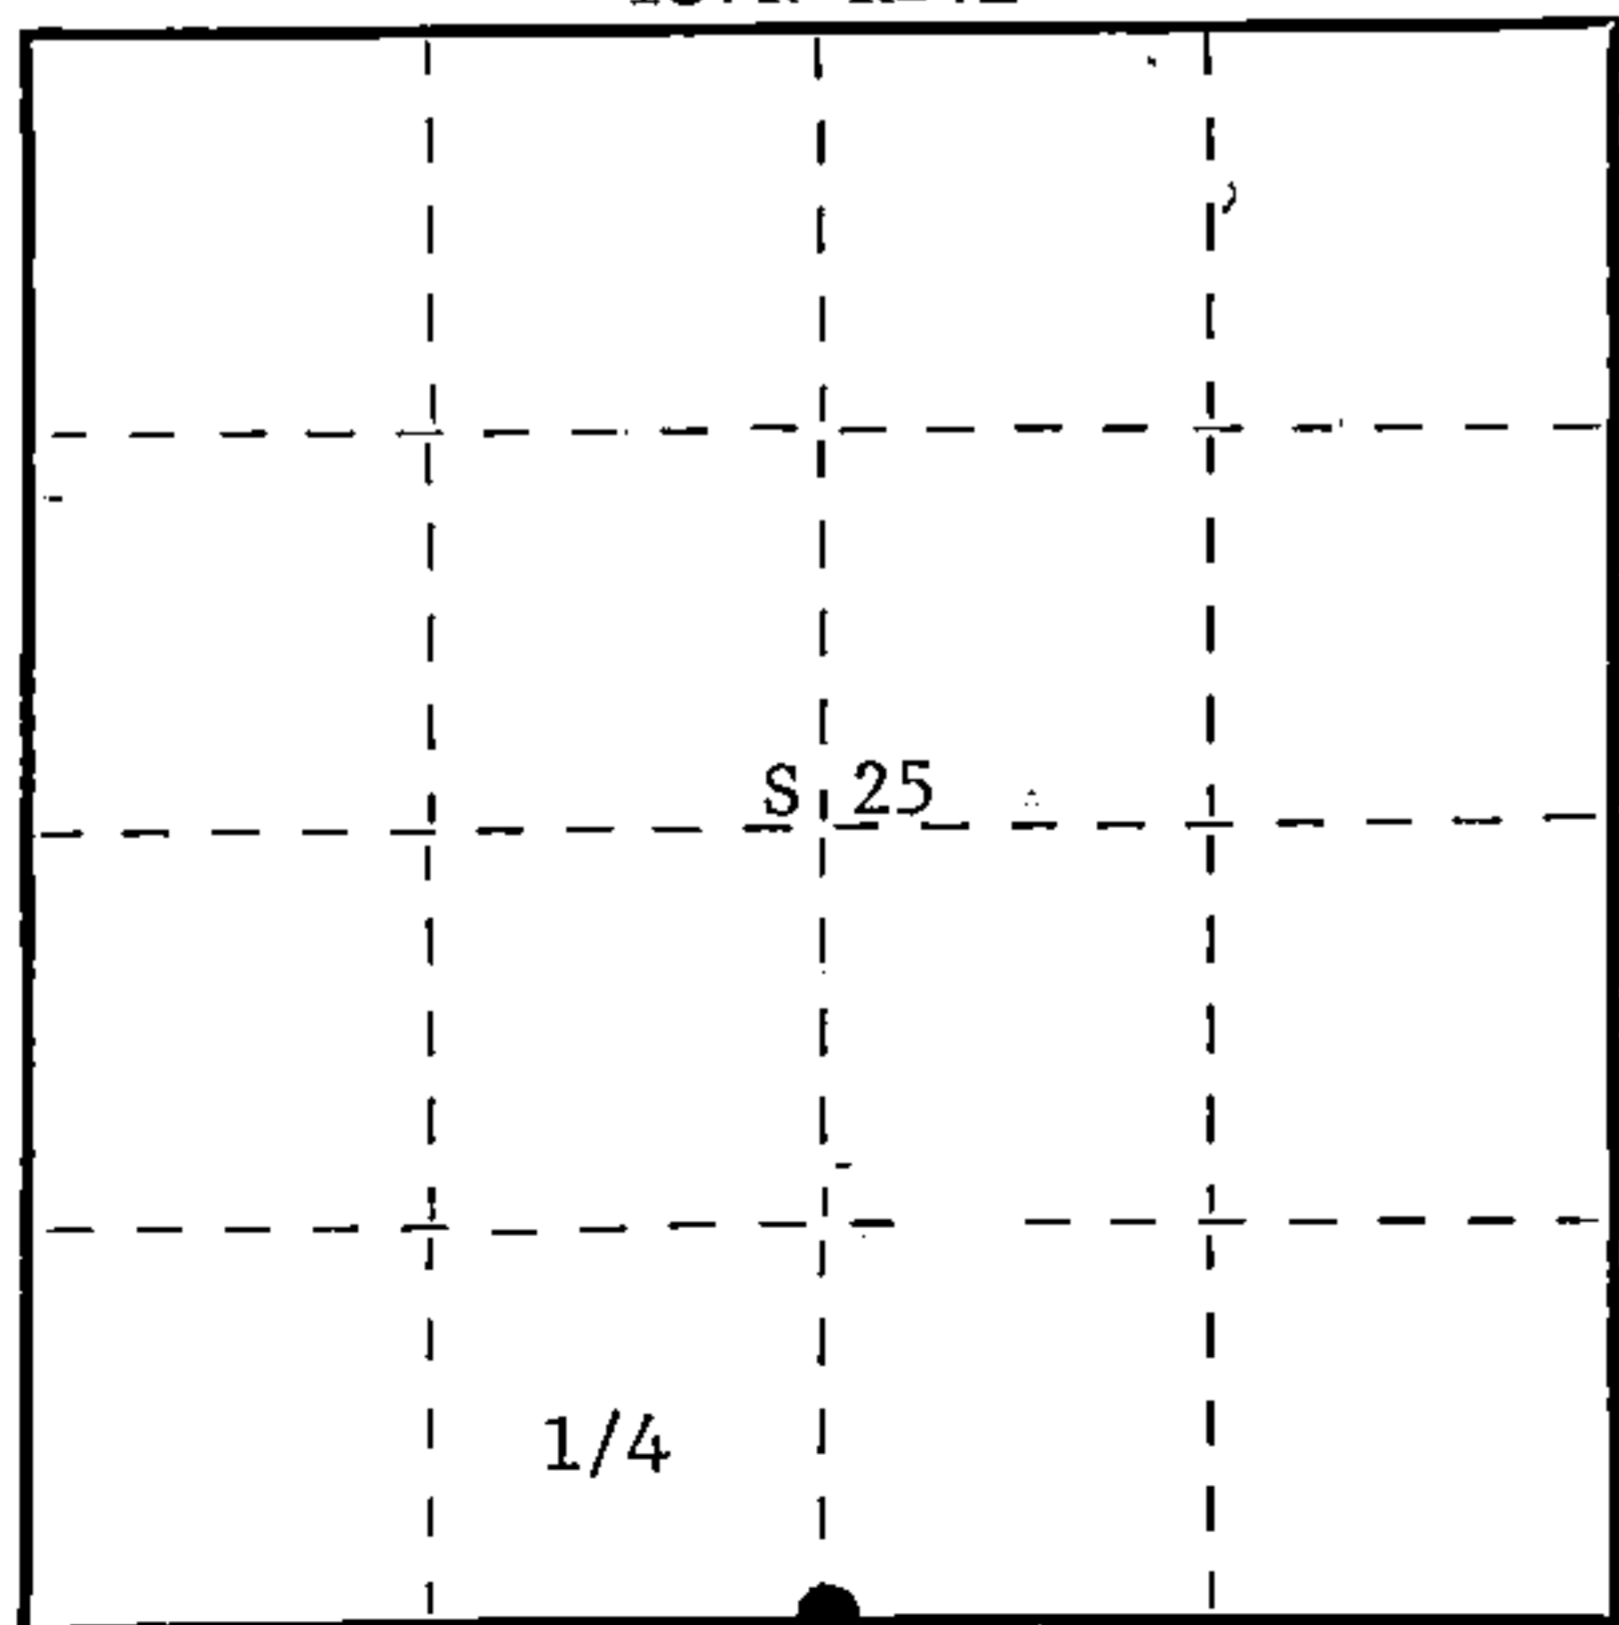

○ = Corner monument restored.

History of original corner establishment: Original corner established by James L. Nowlin, Gov. Deputy Surveyor, in 1865, from which Aspen 12" bears S61°E 50 links, and White Birch 10" bears N3°W 47 links. Corner recovered by Ray Leigh, Consolidated Forester, in about 1945. Perpetuated by Phil Hansen, Registered Surveyor, in 1948. Set new cedar post.

Description of corner evidence found:

Recovered 4" cedar post, squared and scribed, 1/4 S S25, 1/4 S S36, in poor condition. A mound of rock had been placed around base of post. No OBT's were recovered.

Description of monument and accessories I established to perpetuate the original location of this corner.

Replaced wood post with 2 1/2" x 30" Berntsen A-1 Federal Monument, aluminum post with magnet installed in cap and base. Post projects 6" above surface of ground. Cap stamped -

NBT's - Sugar 6" N70°W 40 links, scribed 1/4 BT.  
R. Maple 11" S10°E 85.8 links, scribed 1/4 BT.

S498  
T37N R14E  
1/4 S|25  
S|36  
1975

Dated at Argonne, Wis., this 2nd day of October, 19 75.

Signature Philip T. Hansen Title Registered Land Surveyor Registration No. S-498  
(County Surveyor, Registered Land Surveyor, or other duly authorized official)

Office of Register of Deeds, County of Forest, I hereby certify that the within instrument was filed in this office for record on the 13th day of October, 19 75 at 4:00 o'clock P. M.

Eugene Stategny  
(Register of Deeds)  
By \_\_\_\_\_ Deputy

DOCUMENT NUMBER -- **107971**

FORM 985 R. C. MILLER CO., MILWAUKEE

43714250020