

CERTIFIED LAND CORNER RESTORATION

Index No. V-11


State of Wisconsin }
 County of Forest } ss.

I Philip T. Hansen, do hereby certify that on the 22nd day of September, 1975, I found evidence of the Quarter corner of Sections 28 and 33 Township 37, North, Range 14 East, Fourth Principal Meridian, as described hereon; and that from this evidence I established a new monument and accessories as described hereon to perpetuate the original location of this corner.


Resident witnesses:

Glen Barker

Jim Claflin

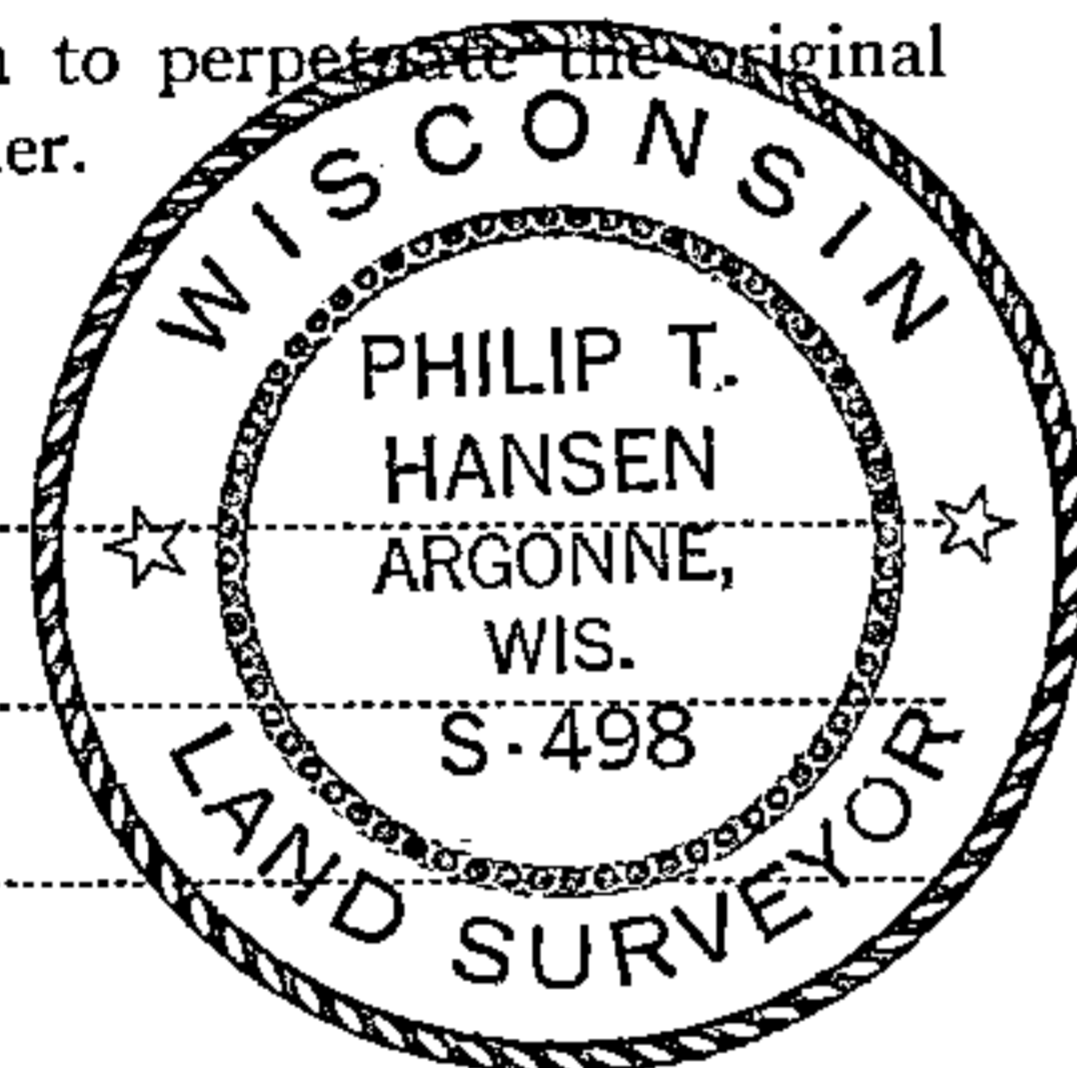

FORM 985 R. C. MILLER CO., MILWAUKEE

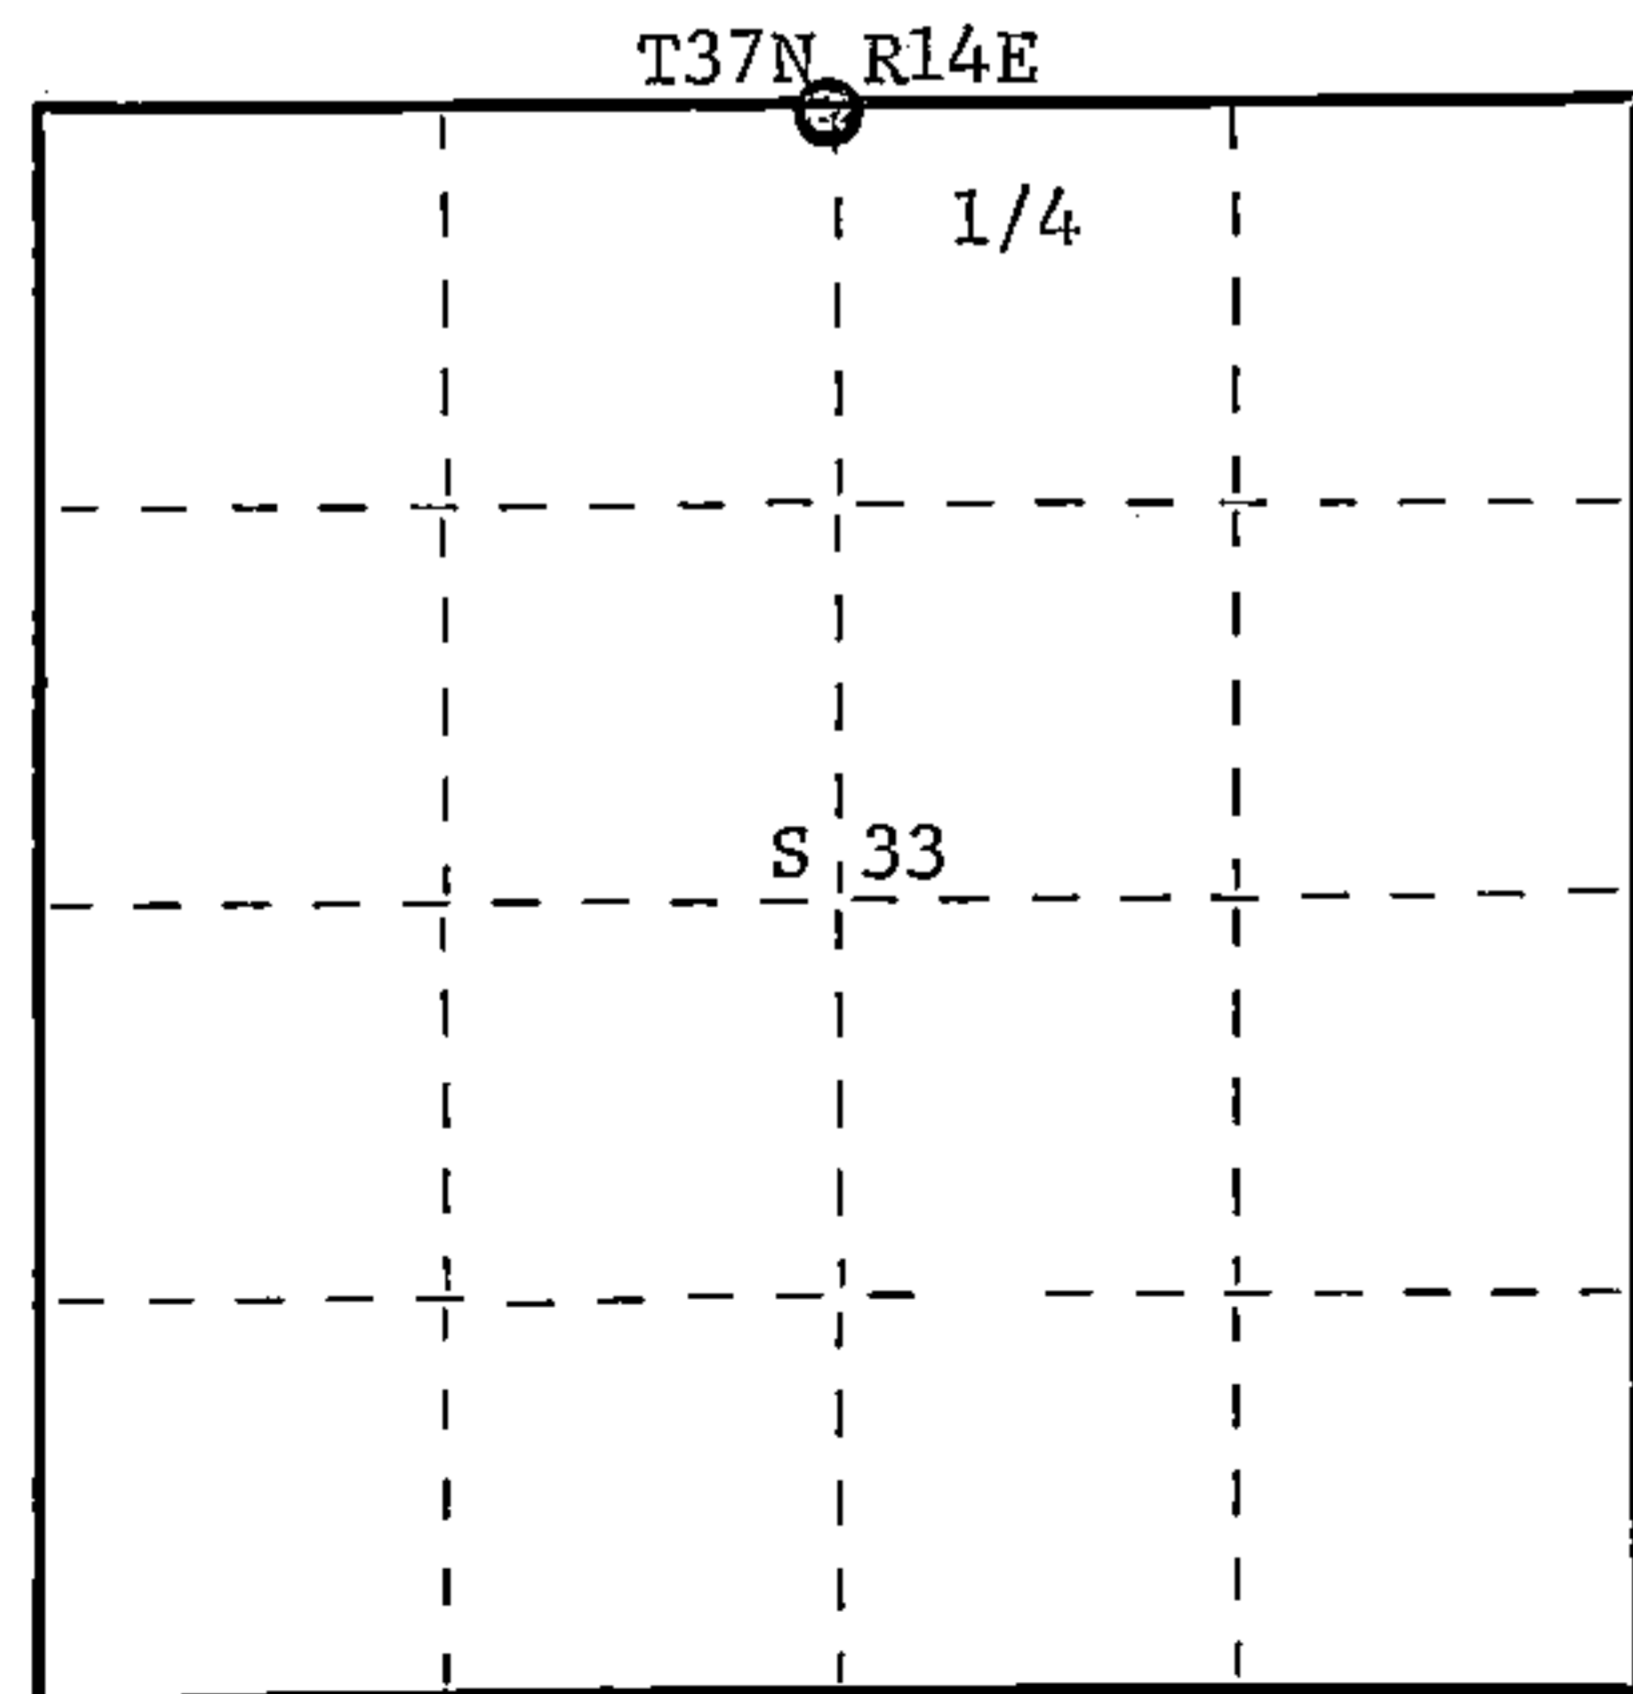

○ = Corner monument restored.

History of original corner establishment:

Original corner established by James L. Nowlin, Deputy Surveyor, in 1865 from which birch 8" bears N15°W, 20 links and cedar 6" bears S23°E, 30 links. Corner re-established by I.R. Ritter, County Surveyor, in 1921. Set new cedar post and marked NBT's:

Spruce 5" N55°W 52 links,
 Fir 5" N5°E 48 links.

Corner perpetuated in 1948 by P.T. Hansen, Registered Land Surveyor. Set 1-1/2" iron pipe beside wooden stake.

Description of corner evidence found:

Recovered 4" squared cedar post in poor condition, also a 1-1/2" iron pipe driven in beside it.

No evidence of Ritter's BT's visible.

Description of monument and accessories I established to perpetuate the original location of this corner.

Replaced 4" cedar post with 1-1/2" OD iron pipe with 2" brass cap stamped - S498
 Pipe projects 18" above ground. T37N R14E

NBT's: R. pine 6" S56°W 124.5 links - scribed 1/4 BT.
 R. pine 7" S28°W - scribed 1/4 BT.

1/4 $\frac{S}{33}$ | $\frac{28}{33}$

Post and BT's painted blue.

1975

Dated at Argonne, Wis., this 21st day of October, 1975.

Signature Philip T. Hansen Title Registered Land Surveyor Registration No. S-498
 (County Surveyor, Registered Land Surveyor, or other duly authorized official)

Office of Register of Deeds, County of Forest, I hereby certify that the within instrument was filed in this office for record on the 23rd day of December, 1975 at 2:30 o'clock P. M.

Eugene Staszynski
 (Register of Deeds)

DOCUMENT NUMBER **108440**

By.....Deputy

43714280020