


CERTIFIED LAND CORNER RESTORATION

Index No. **722**


State of Wisconsin }
County of Forest } ss.

I Daniel K. Pleoger, do hereby certify that on the 11 day of September, 19 81, I found evidence of the W 1/16 corner of Sections 1 & 36 Township 36 & 37, North, Range 14 East, Fourth Principal Meridian, as described hereon; and that from this evidence I established a new monument and accessories as described hereon to perpetuate the original location of this corner.

Resident witnesses:

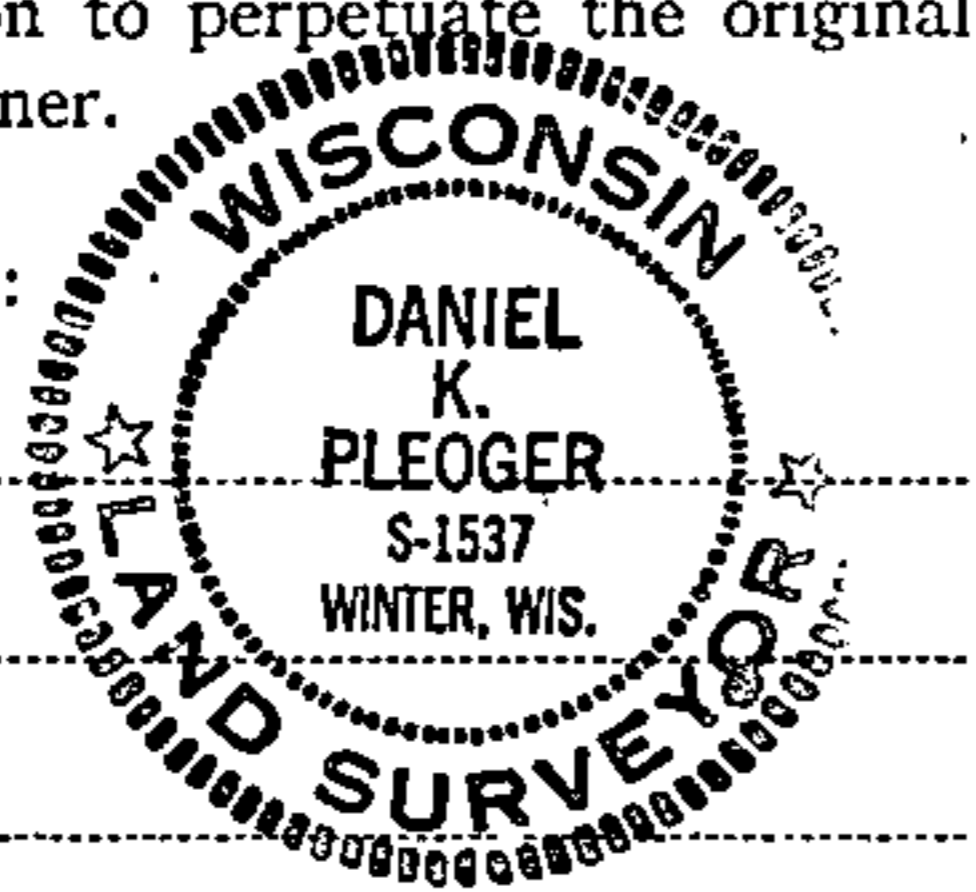

FORM 985 H. C. MILLER CO., MILWAUKEE

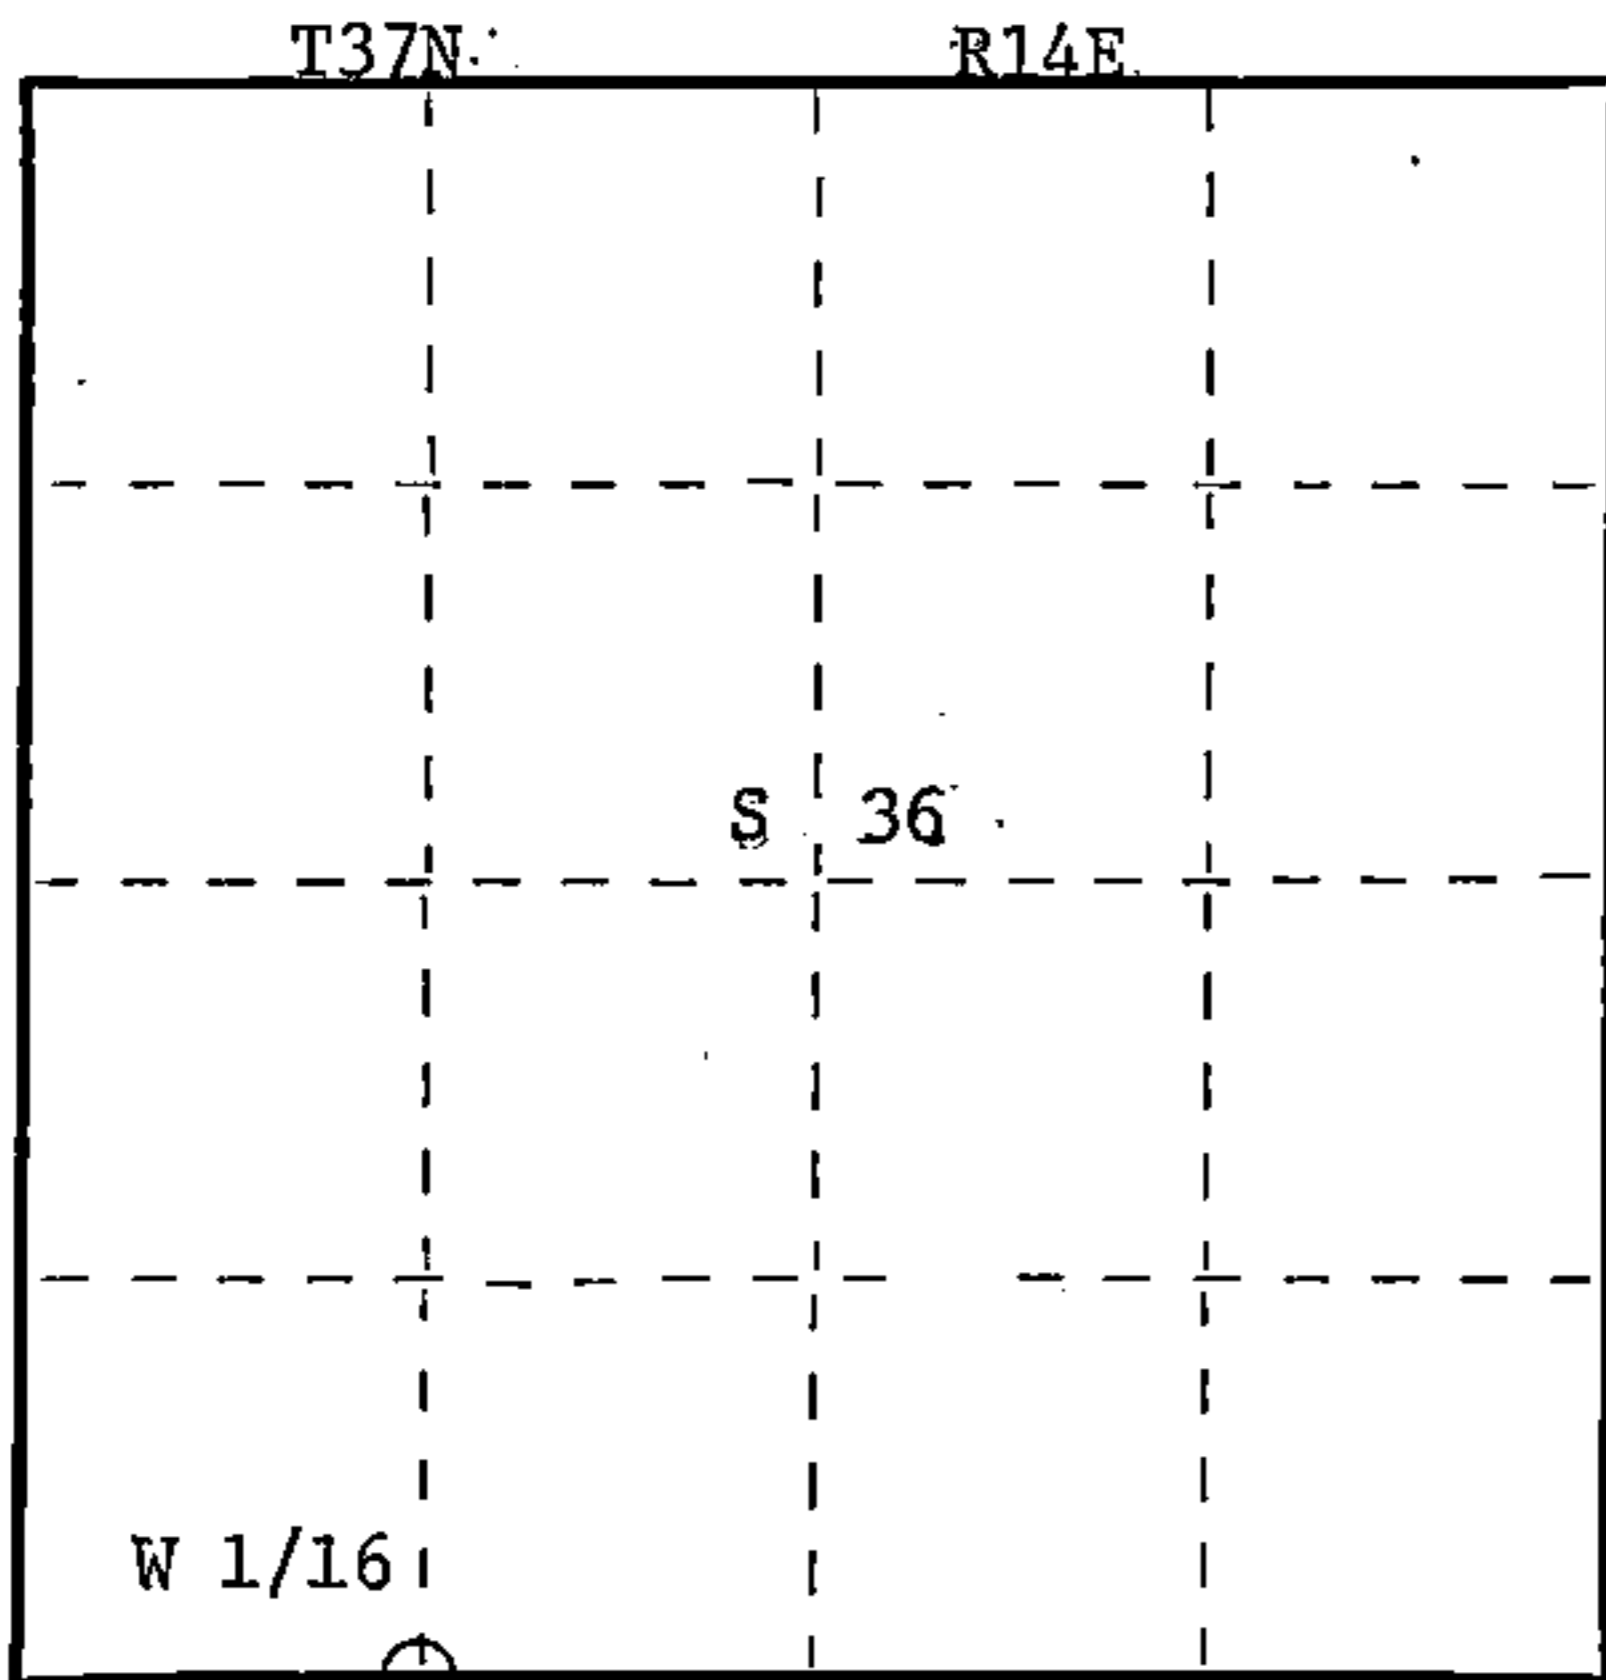

○ = Corner monument restored.

History of original corner establishment:
No evidence of any previous corner

Description of corner evidence found:

Total distance from section corner 2, 1, 35, 36 T36 & 37N R14E to 1/4 corner between sections 1 & 36 T36 & 37N R14E is 2646.029 ft. at bearing N89-56-17E.
Set W 1/16 1323.014 ft. intermediate

Description of monument and accessories I established to perpetuate the original location of this corner.
Set a 1 1/2" iron pipe with 2" diameter brass cap stamped:

Monument projects 18" above ground.

Corner sets in tag alder and willow swamp.
No suitable BTs near.

S1537
T37N R14E
W 1/16 $\frac{S}{S} \frac{36}{1}$
T36N R14E
CPI - 1981

Dated at Rhineland, Wis., this 4th day of November, 19 81

Signature Daniel K. Pleoger Title Registered Land Surveyor Registration No. 1537
(County Surveyor, Registered Land Surveyor, or other duly authorized official)

Office of Register of Deeds, County of Forest, I hereby certify that the within instrument was filed in this office for record on the 19th day of January, 19 82 at 3:00 o'clock P. M.

Eugene Staszny
(Register of Deeds)
By _____ Deputy

DOCUMENT NO. **121101**

43714 36 0030