

CERTIFIED LAND CORNER RESTORATION

State of Wisconsin }  
County of Forest } ss.

I Jean F. Resvick, do hereby certify that on the 9th day of July, 1970, I found evidence of the West Quarter corner of Section 4 Township 37 North, Range 15 East, Fourth Principal Meridian, as described hereon; and that from this evidence I established a new monument and accessories as described hereon to perpetuate the original location of this corner:

Description of original monument and accessories and subsequent restorations:


Surveyed in 1865 by J. L. Nowlin  
40.30 chains South corrected between Section 4 and 5  
Set post (Note: post set at midpoint of 80.6 chains)  
Hemlock 7, N27E, 37 lks.  
Hemlock 14, N60W, 10 lks.

Description of corner evidence found:



2 inch diameter iron pipe on south edge of road. Old post lying along side of pipe, Forest Service location poster on Hemlock reads North 24 lks. to corner. Dated 2/13/35.

Description of monument and accessories I established to perpetuate the original location of this corner:

Replace 2 inch iron pipe with a 6 inch diameter concrete monument, 3.5 feet long with brass cap stamped.

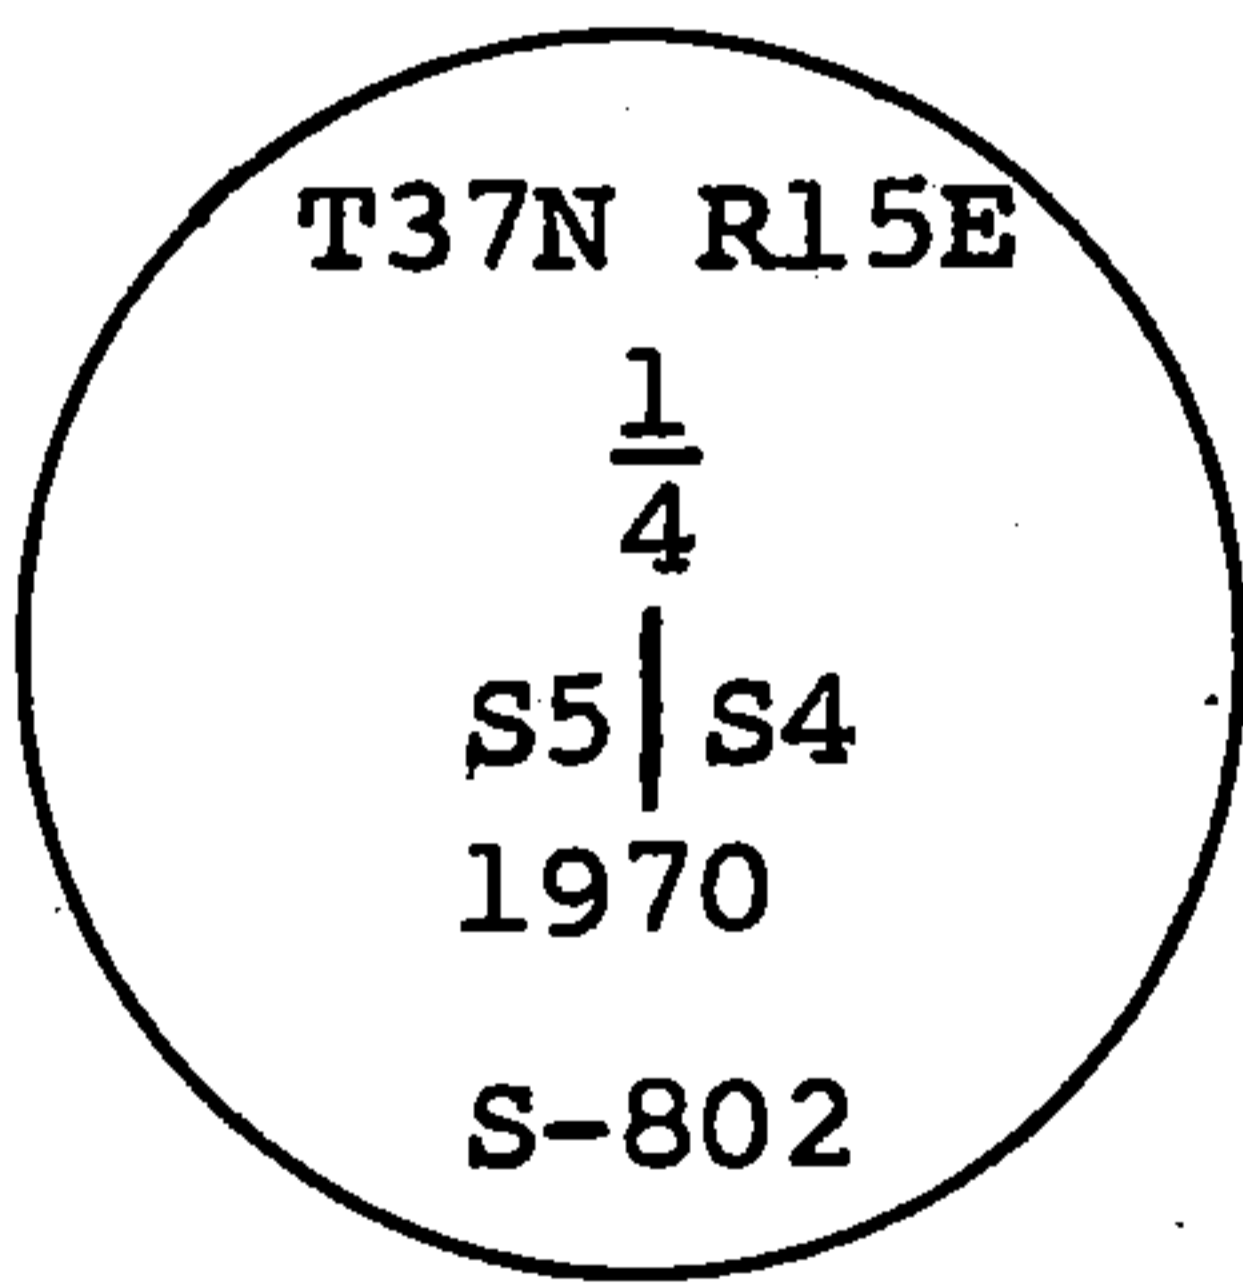

From which the following blazed and scribed New bearing trees bear.  
Sugar 12, S69E, 29.27 feet  
Sugar 12, N85W, 35.85 feet  
Iron fence post 1.0 feet east of monument.

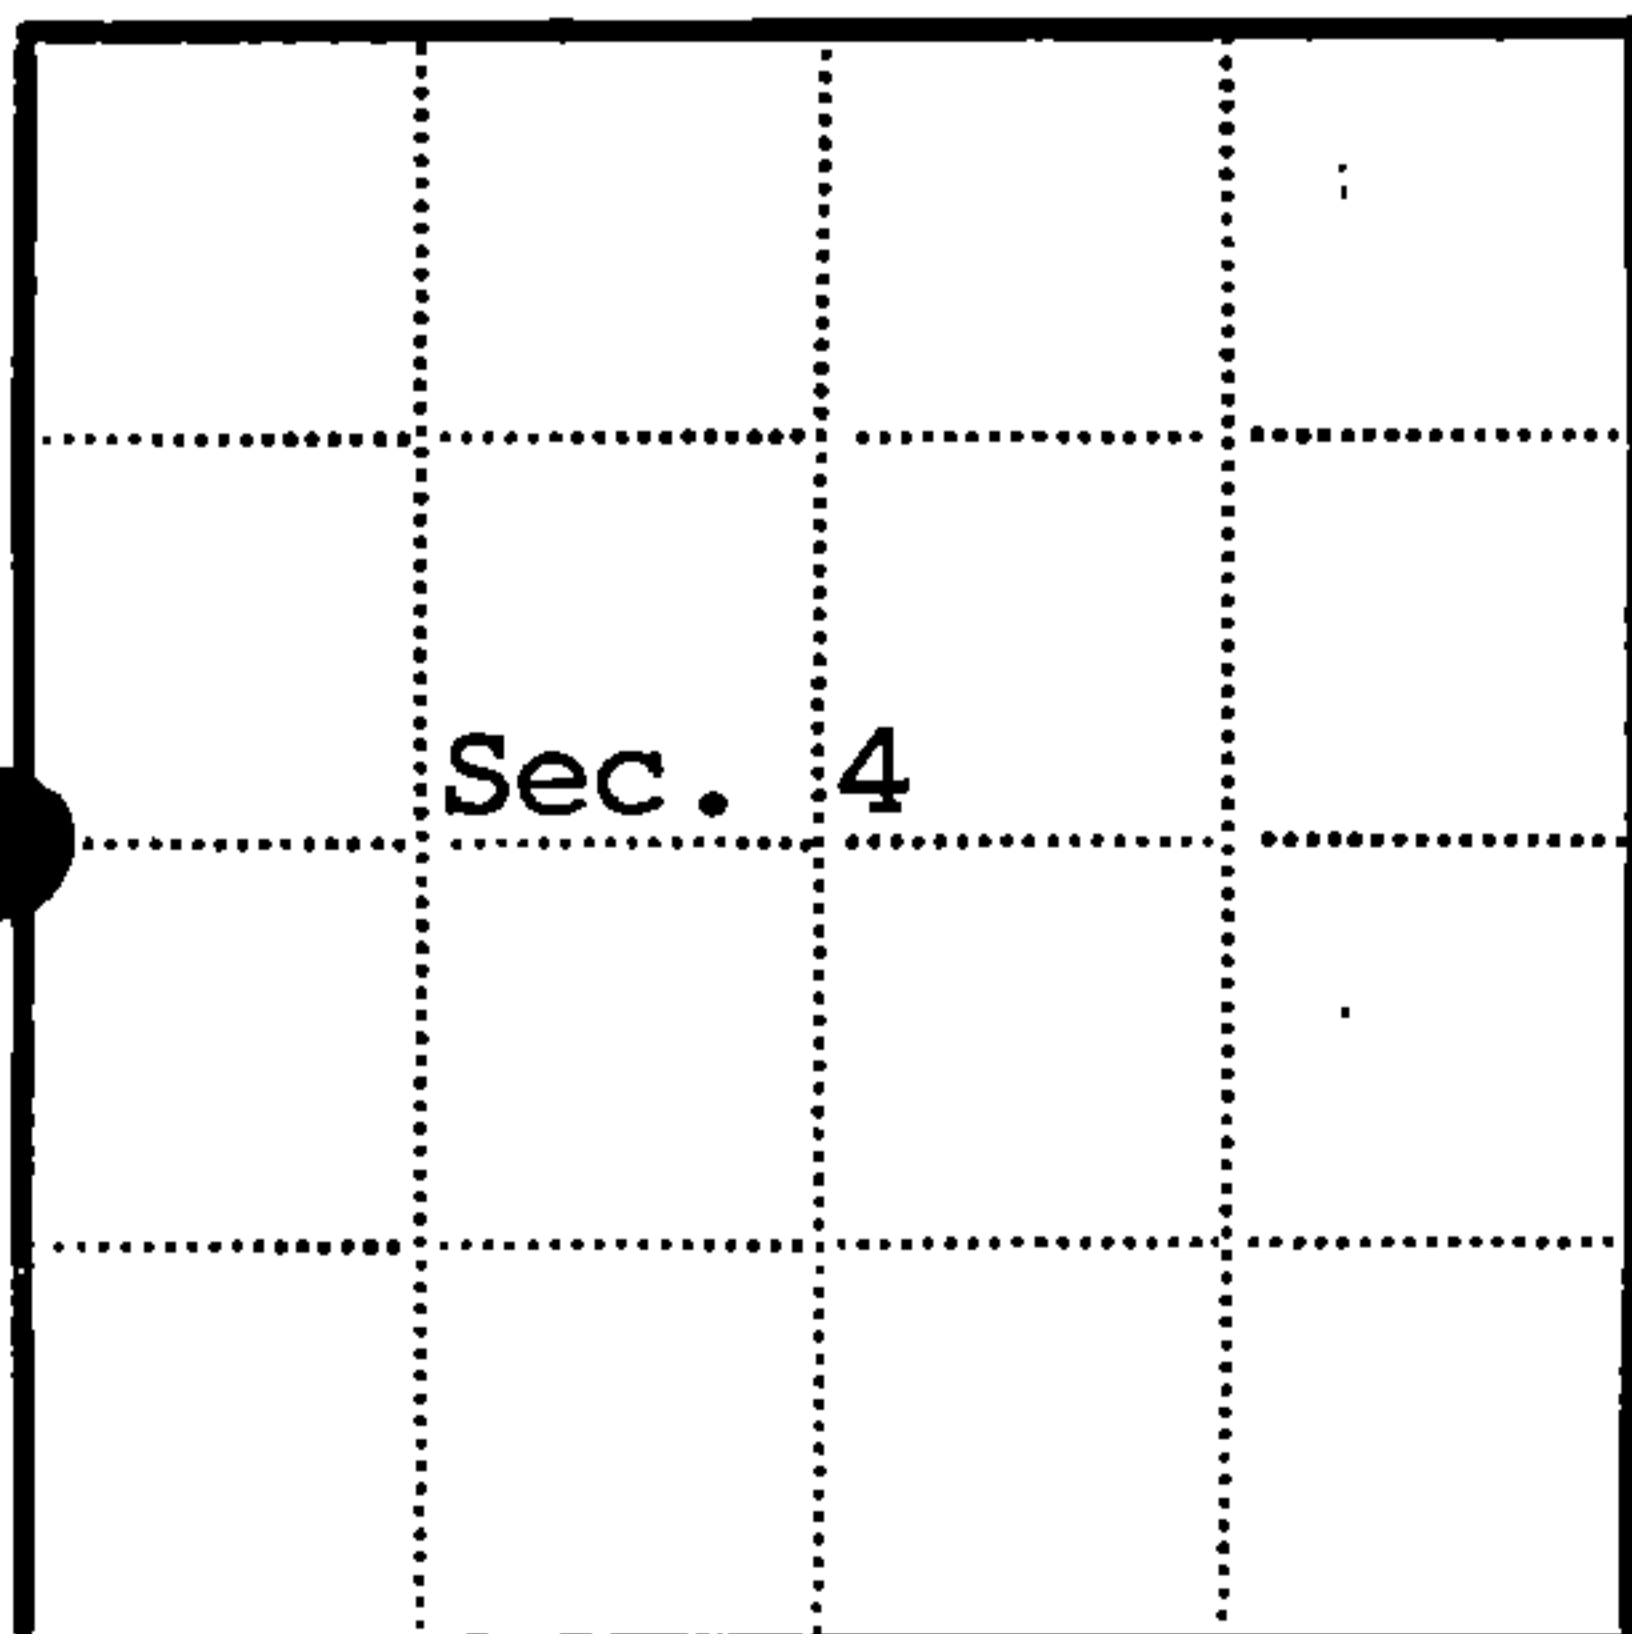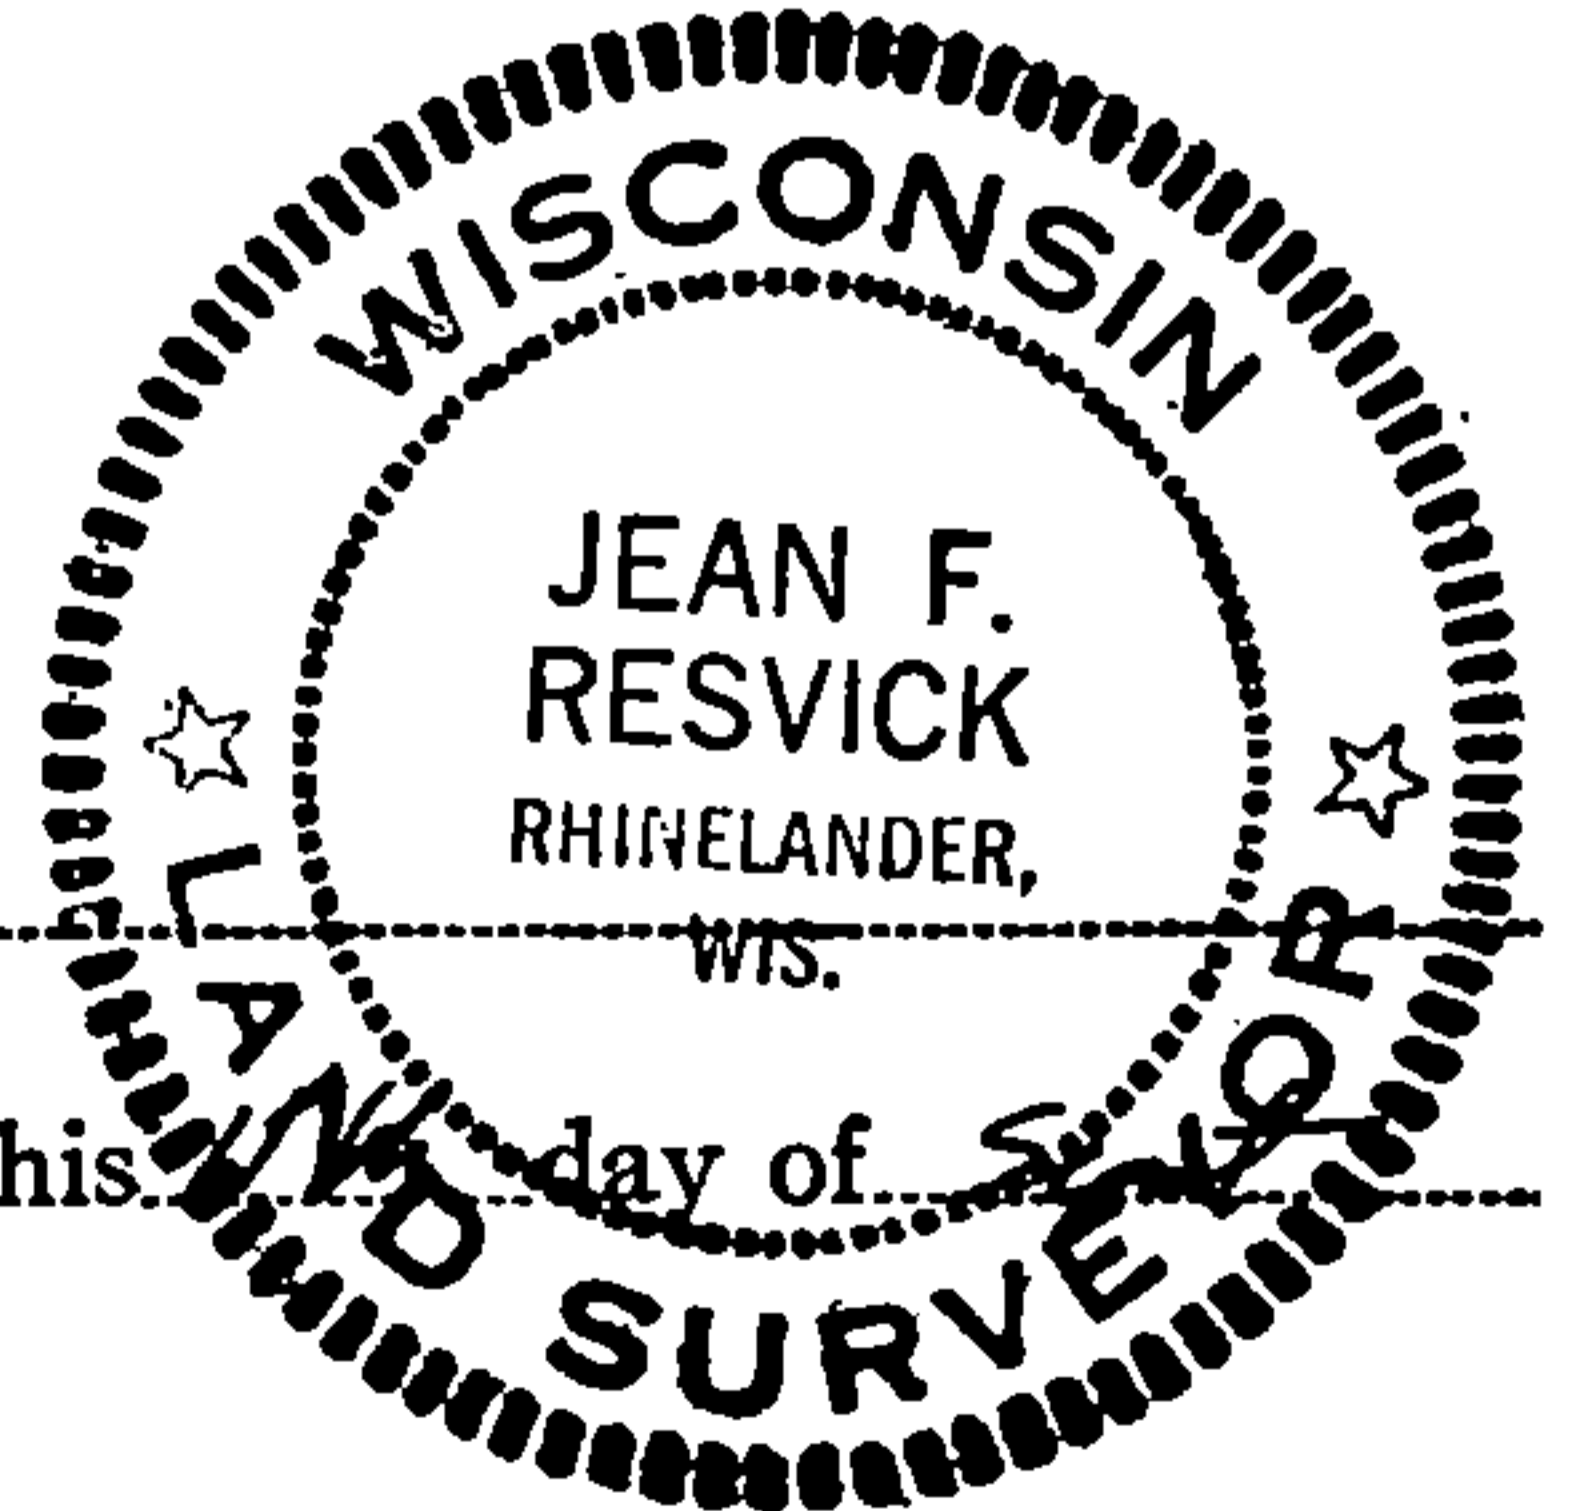

● = Corner monument restored  
□ =

Resident witnesses \_\_\_\_\_  
Dated at Rhinelander Wisconsin, this \_\_\_\_\_ day of \_\_\_\_\_ 1970.  
Signature *Jean F. Resvick* Title Cadastral Surveyor  
(County Surveyor, Registered Land Surveyor, or other duly authorized official)

Surveyors Registration No. S-802 DOCUMENT NUMBER 98912

Office of Register of Deeds County of Forest  
I hereby certify that the within instrument was filed in this office for record on the 23rd day of October 1970, and was filed in Book No. CORNER Page No. 6-9 of County Records.  
RESTORATIONS  
Signature *Eugene Stutzman* Title Register of Deeds

Township 37 North, Range 15 East, Section 4, Index No. C-9, Page No. \_\_\_\_\_

C  
9