

CERTIFIED LAND CORNER RESTORATION

State of Wisconsin }
County of Forest } ss.

I, Jean F. Resvick, do hereby certify that on the 10th day of June, 1968, I found evidence of the Northwest Section corner of Section 25 Township 37 North, Range 15 East, Fourth Principal Meridian, as described hereon; and that from this evidence I established a new monument and accessories as described hereon to perpetuate the original location of this corner:

Description of original monument and accessories and subsequent restorations:

Surveyed by J. L. Nowlin in 1865.
North between Sections 25 and 26, 80.00 chains
Set wooden post
Tamarack, 12 ins., N. 19° E., 18 Lks.
Tamarack, 9 ins., N. 83° W., 32 Lks.

Description of corner evidence found:


Scribed cedar post.
Tamarack stump, bears N. 19° E., 11.9 ft., from post found.
Tamarack stump, bears West, 21.1 ft., from post found.
Remains of scribing found on the stump that bears West.

Description of monument and accessories I established to perpetuate the original location of this corner:

Replaced scribed cedar post with a 2-inch inside diameter galvanized wrought iron pipe, 5 feet long, filled with concrete, with brass cap marked:

T37N R15E
S23 | S24
S26 | S25
1968
S-802

from which the following blazed and scribed new bearing trees bear:
Black Spruce, 7 ins., N. 19° E., 17.66 ft. or 26.75 Lks.
Cedar, 5 ins., S. 71° E., 16.47 ft. or 24.95 Lks.
Tamarack, 5 ins., S. 62° W., 26.67 ft. or 40.41 Lks.
Tamarack, 5 ins., N. 48° W., 3.65 ft. or 5.53 Lks.
Set 4x4 cedar post 1.5 ft., S. 50° E. of monument

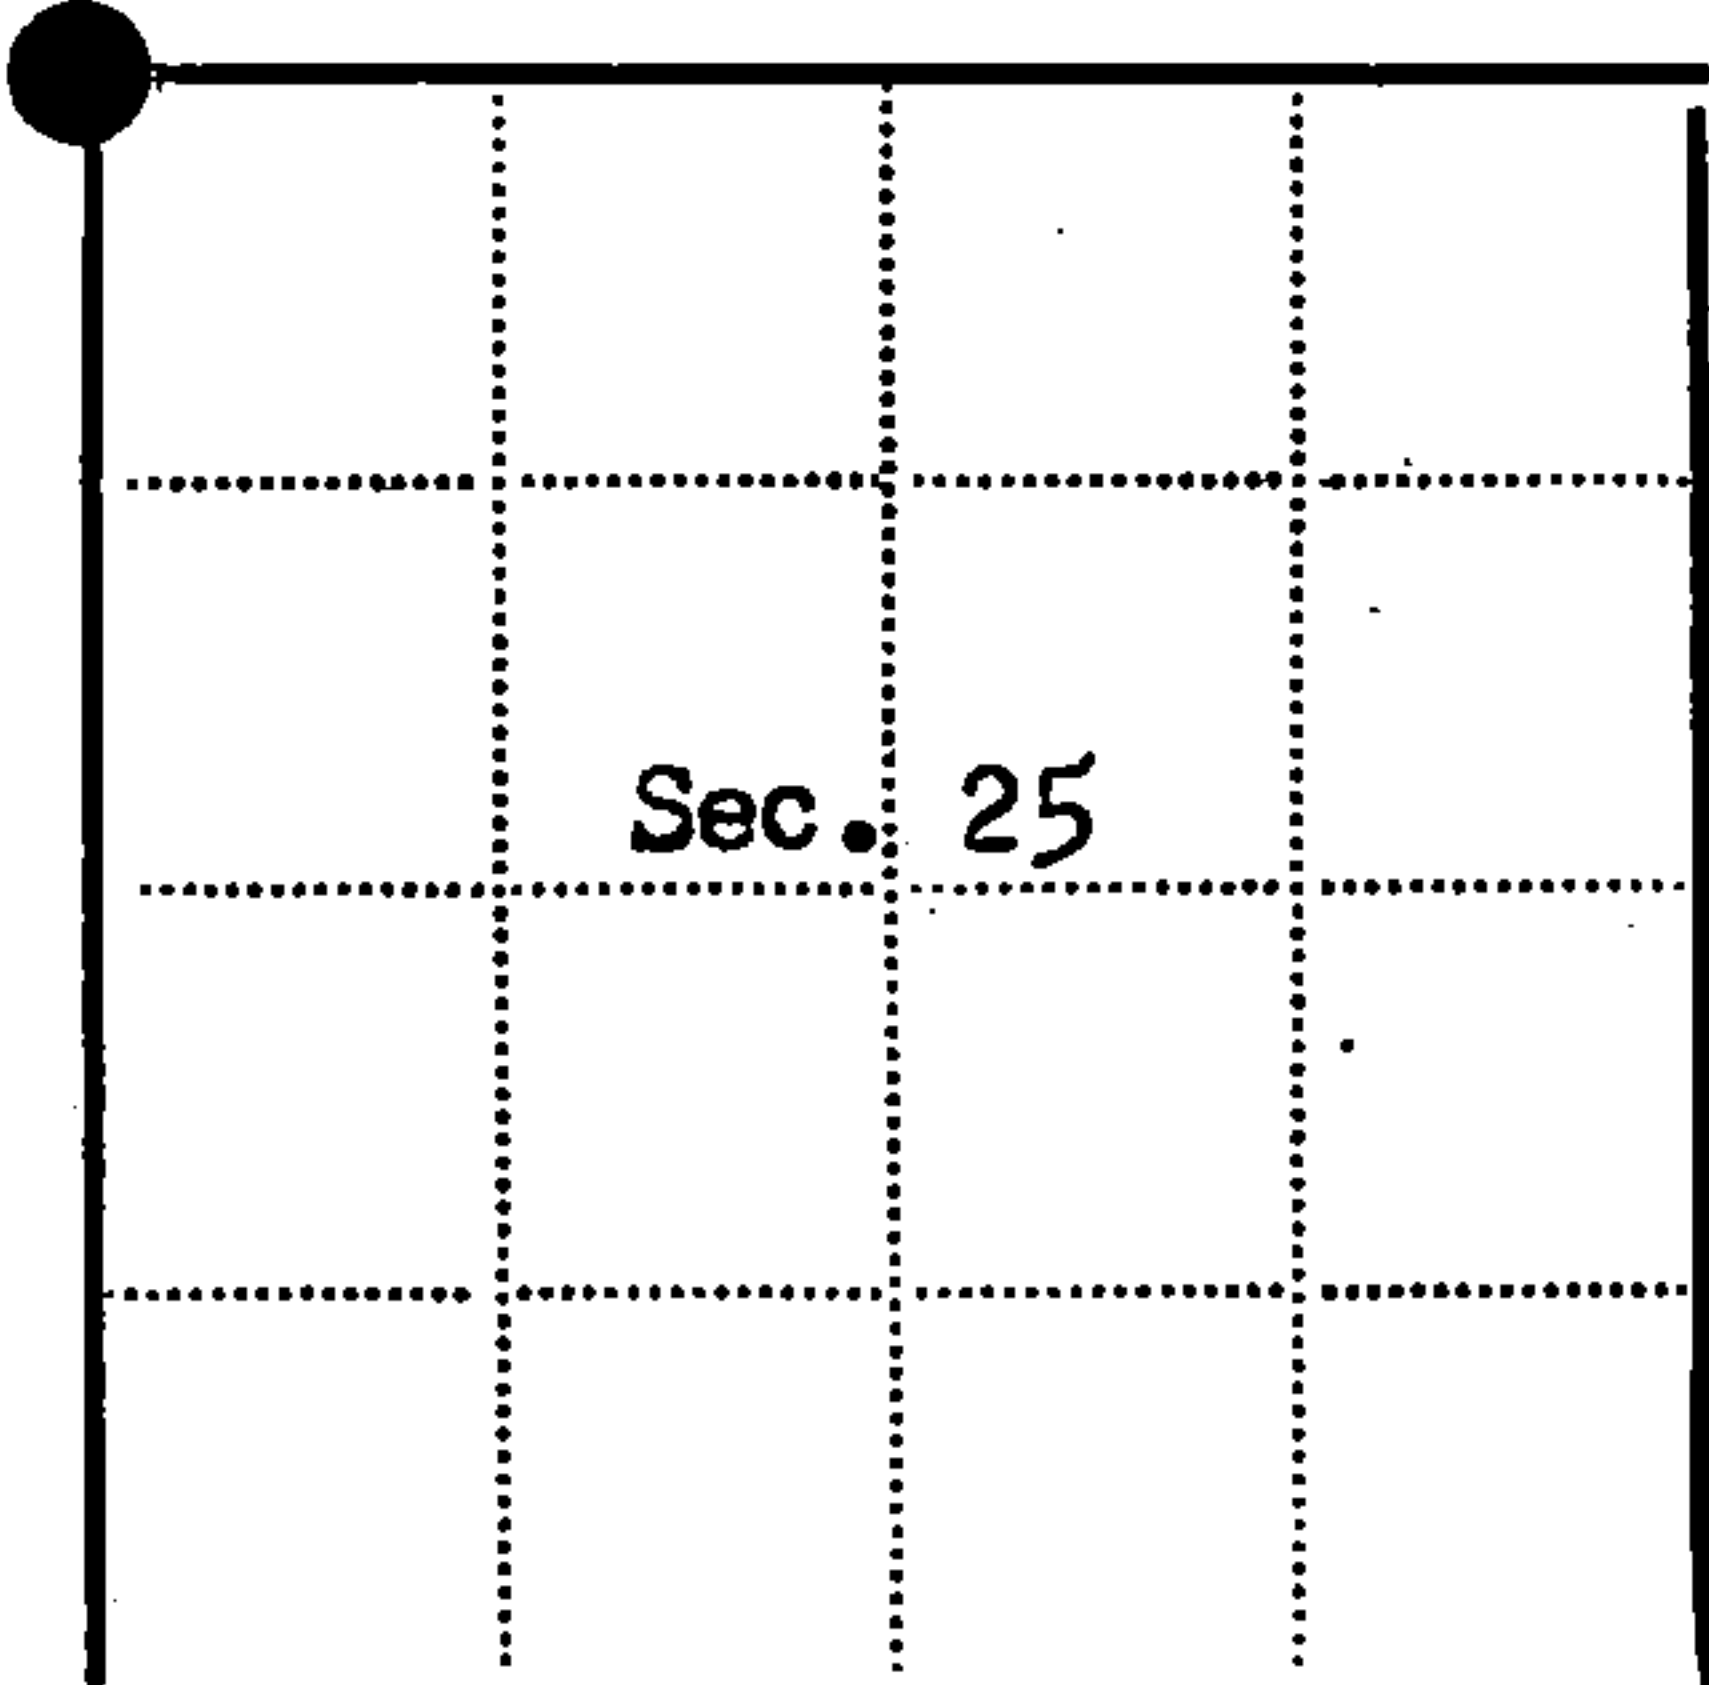

● = Corner monument restored
□ =

Resident witnesses.....

Dated at Rhinelander Wisconsin, this 25th day of June 1968

Signature Jean F. Resvick Title Cadastral Surveyor
(County Surveyor, Registered Land Surveyor, or other duly authorized official)

Surveyors Registration No. S-802 DOCUMENT NUMBER 95061

Office of Register of Deeds County of Forest

I hereby certify that the within instrument was filed in this office for record on the 8th day of August 1968, and was filed in Book No. I Page No. R-21 of County Records at 9:45 A.M.

Signature Eugene Stegany Title Register of Deeds

Township 37 North, Range 15 East, Section 25, Index No. R-21, Page No.