

CERTIFIED LAND CORNER RESTORATION

Index No. **V11**
✓-11


State of Wisconsin }
County of Forest } ss.

I Philip T. Hansen, do hereby certify that on the 11th day of December, 1975, I found evidence of the Quarter corner of Sec. 28 and 33 Township 37, North, Range 15 East, Fourth Principal Meridian, as described hereon; and that from this evidence I established a new monument and accessories as described hereon to perpetuate the original location of this corner.


Resident witnesses:

Glen Barker

Jim Claflin

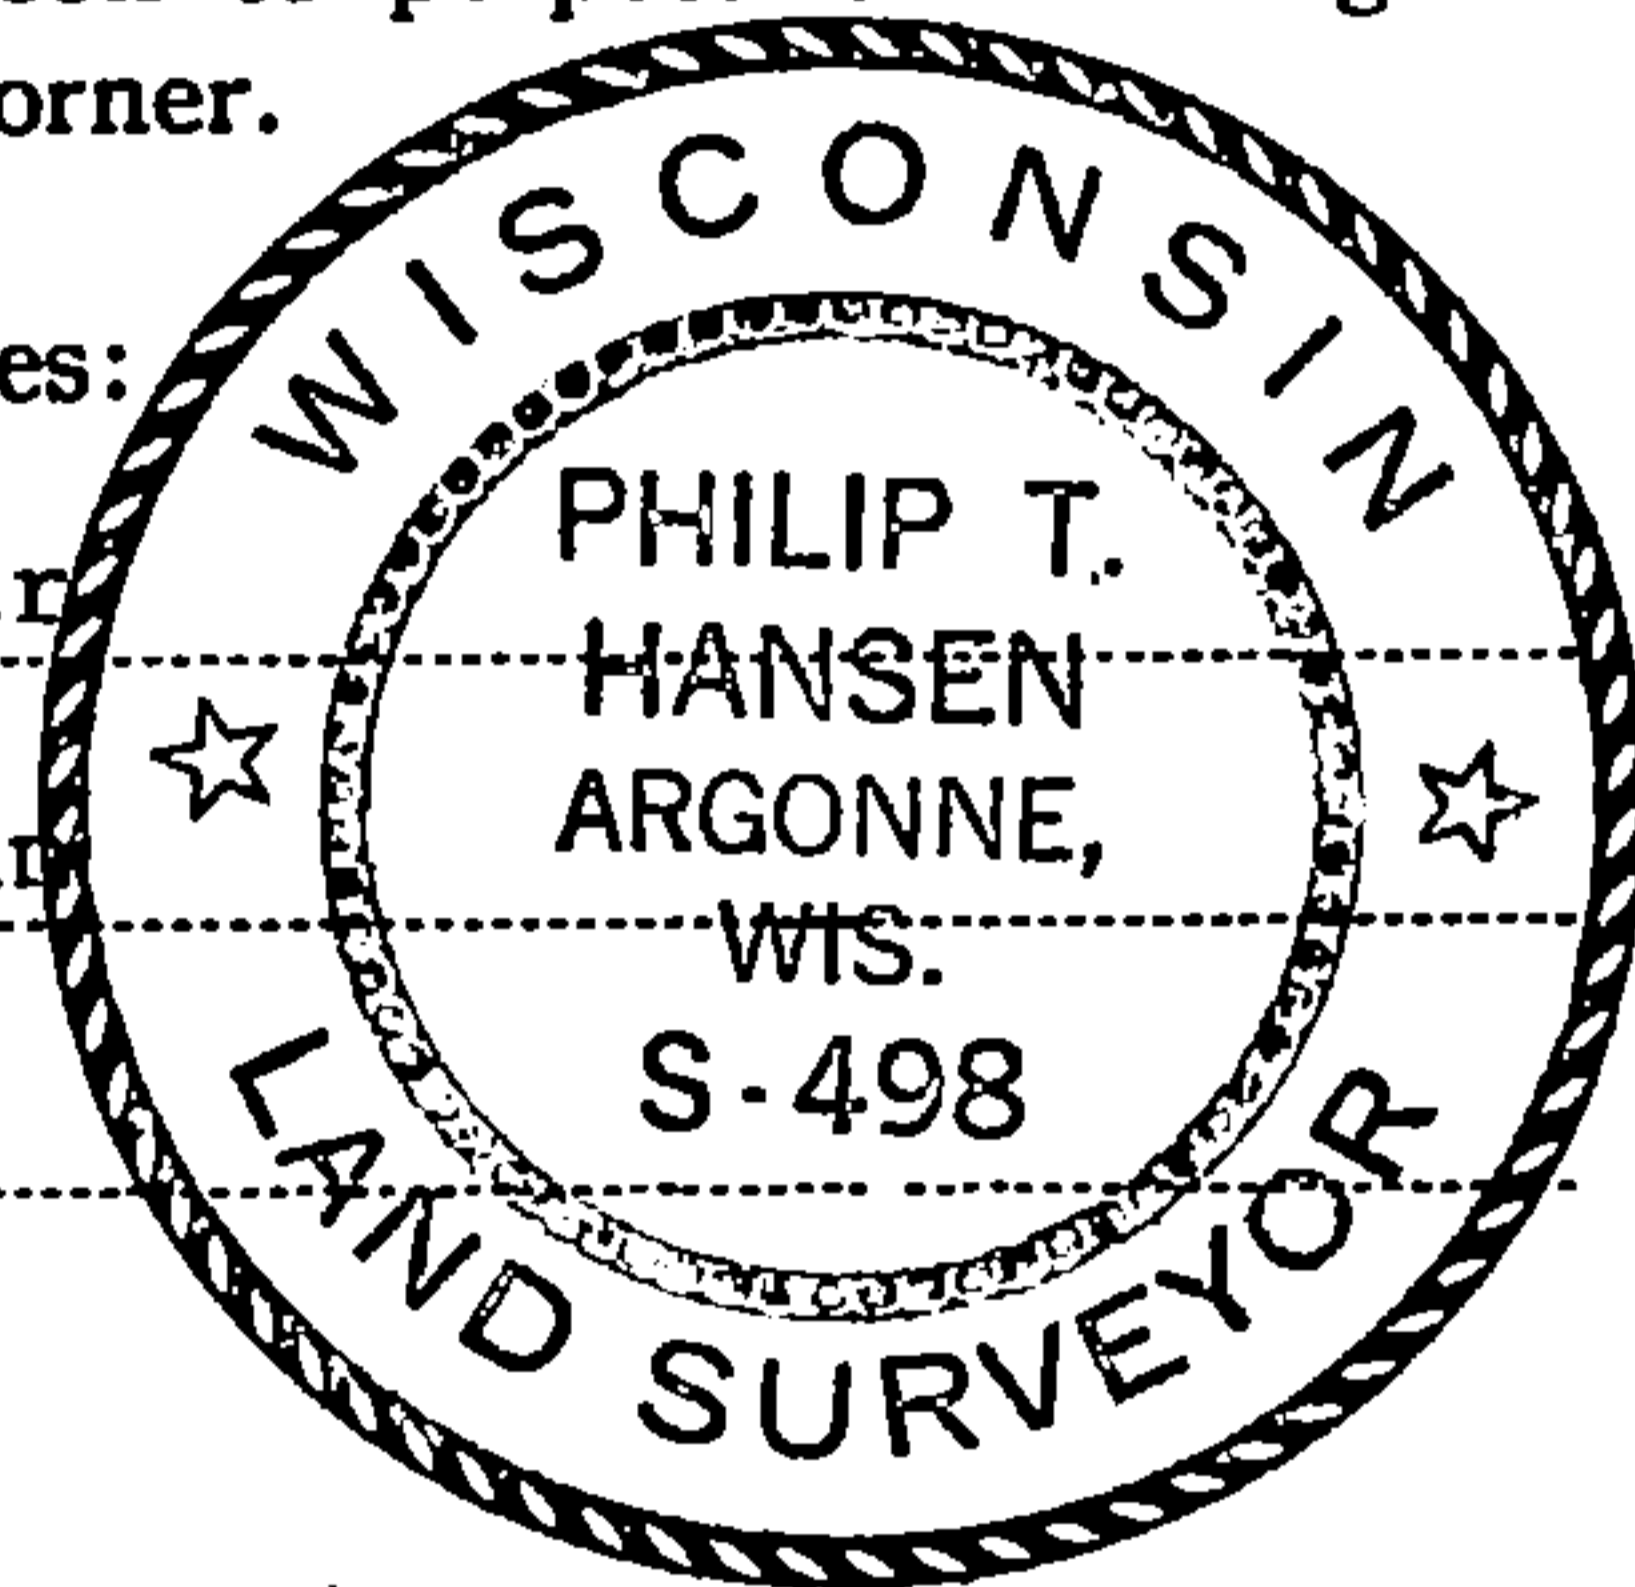

FORM 985 H. C. MILLER CO., MILWAUKEE

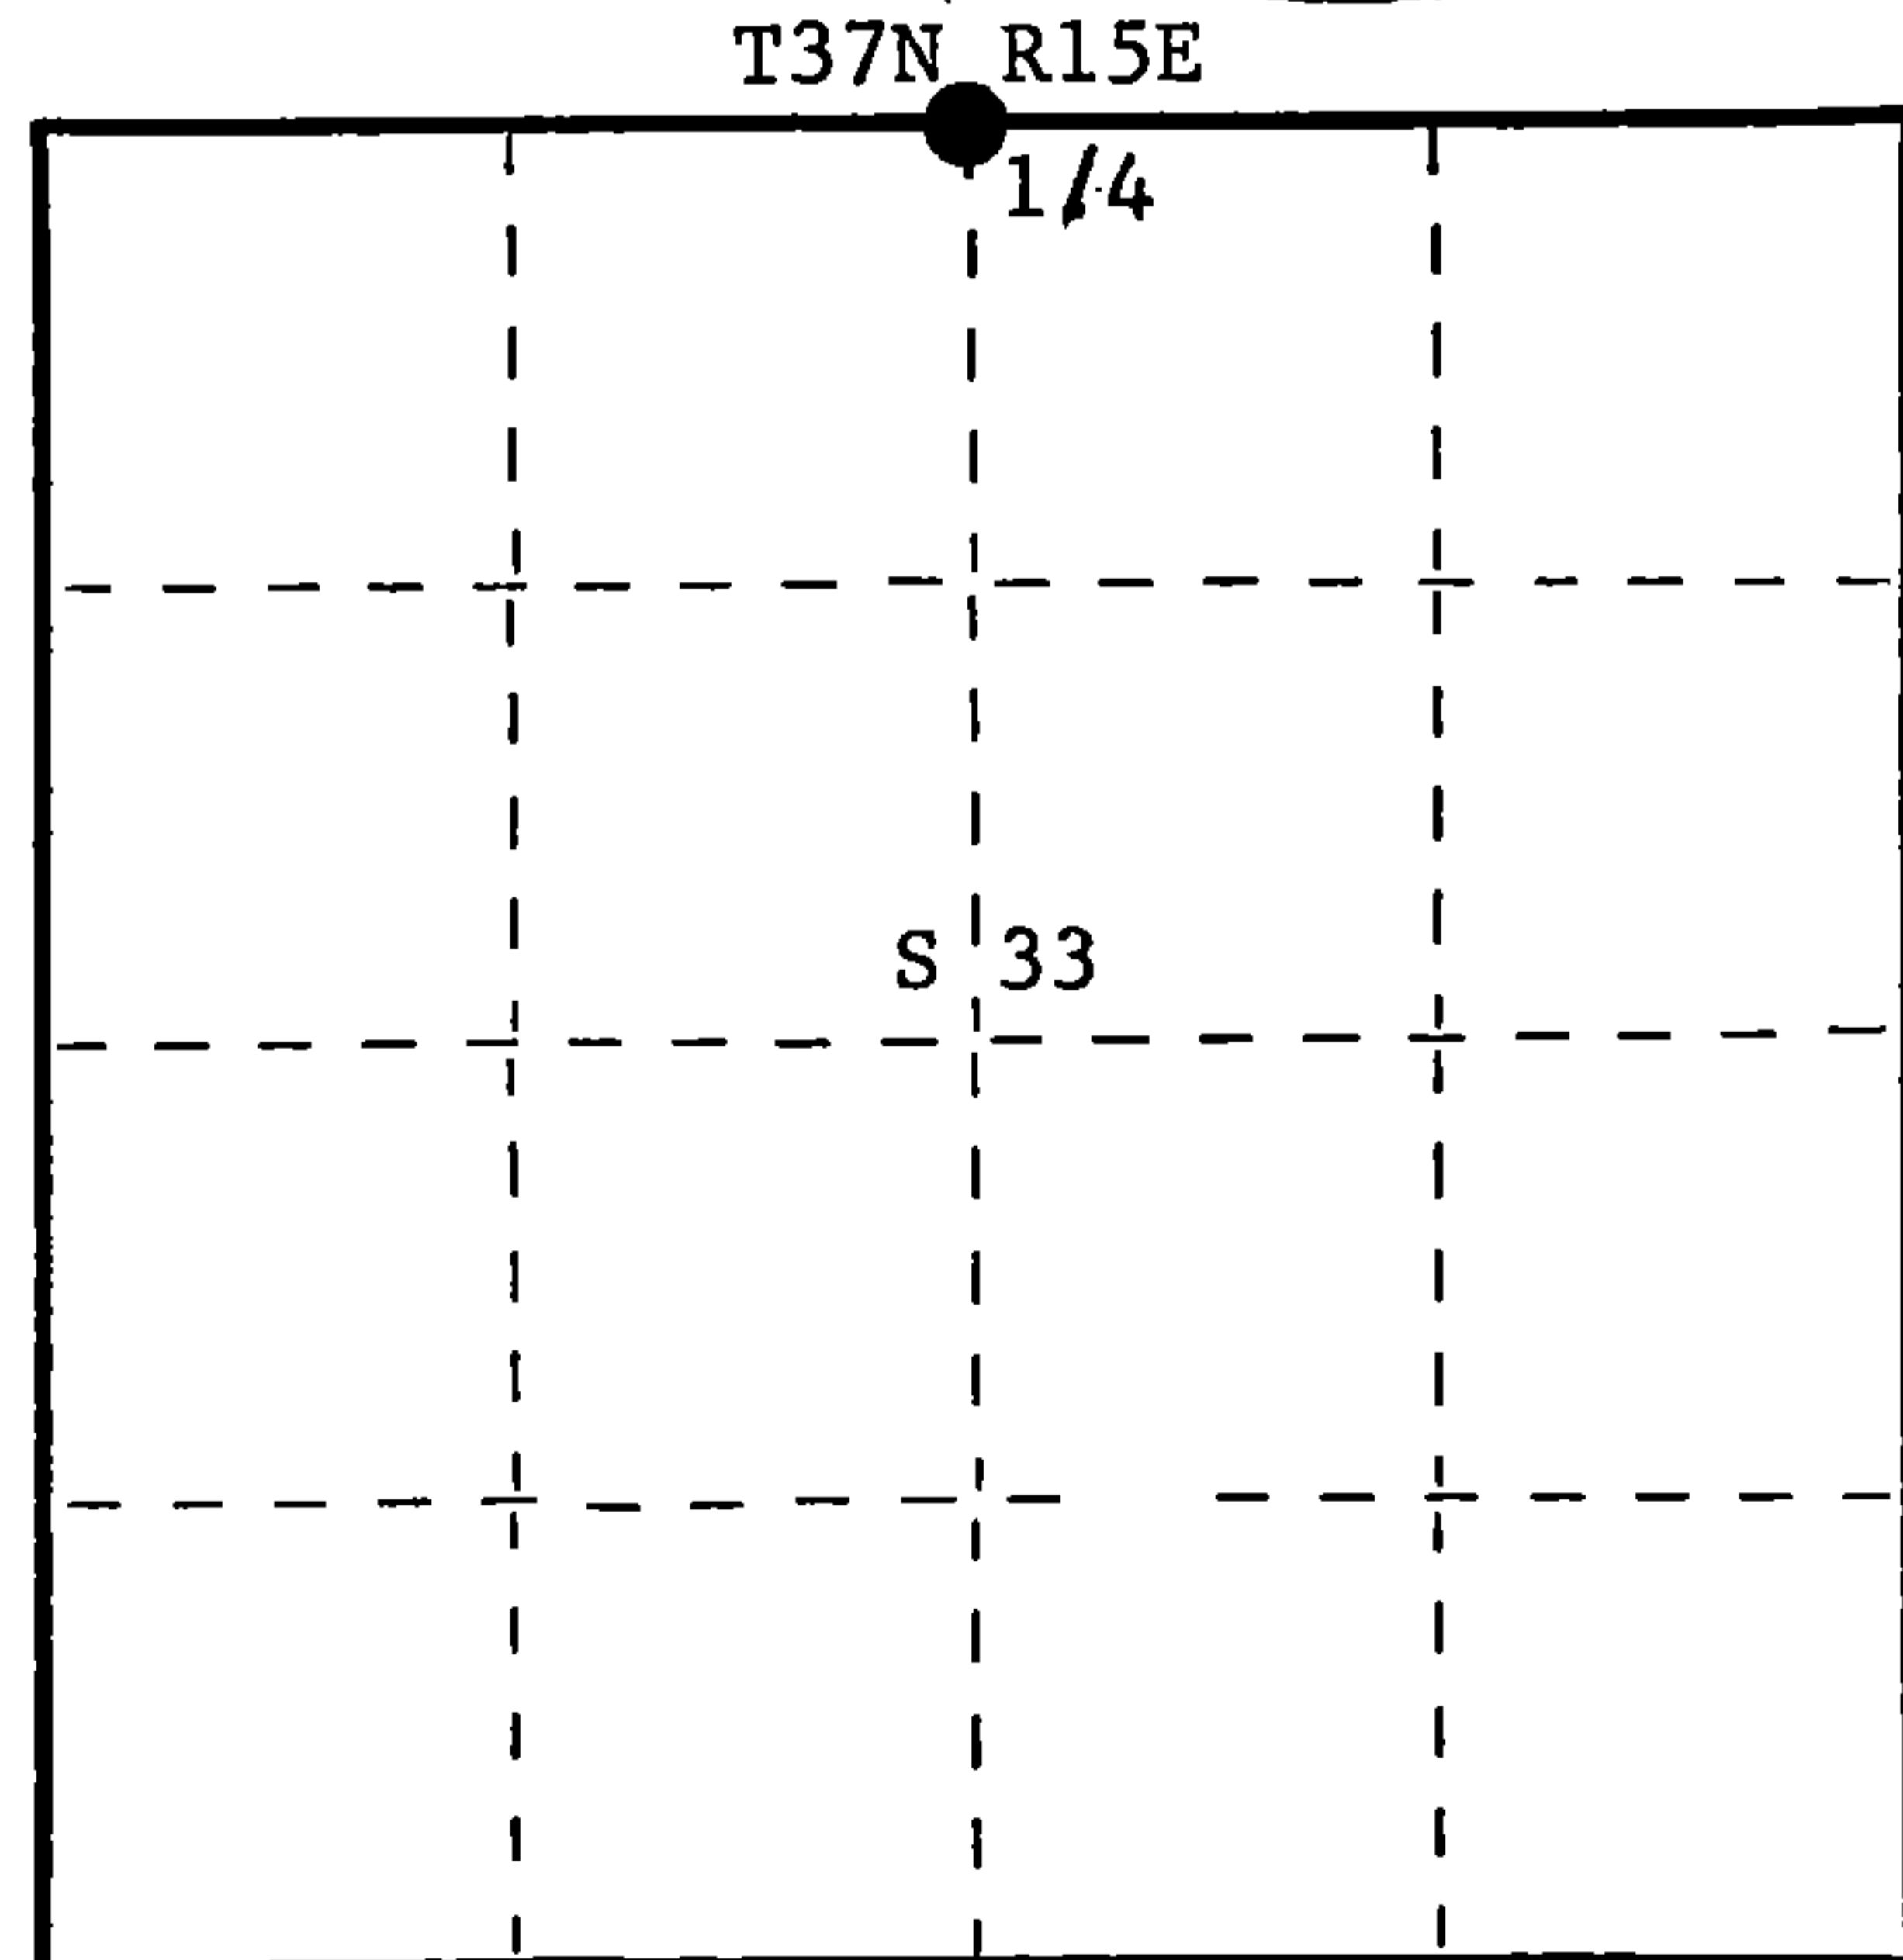

○ = Corner monument restored.

History of original corner establishment: Original corner established by James McBride, Deputy Surveyor.

No record of any subsequent surveys.

Description of corner evidence found: Recovered 2" iron pipe projecting 18" above ground, believed to have been set by Ray Leigh, Consolidated Forester. Also found a 2" x 2" pine stake setting beside iron pipe.

No old BT's were visible in this area.

Description of monument and accessories I established to perpetuate the original location of this corner. Replaced 2" iron pipe with 2-1/2" Berntsen, A-1 Federal Monument, aluminum with magnet installed in cap and base. Pipe projects 18" above ground. Drove old pipe and pine stake in beside new pipe. Cap stamped -

NBT's - W. spruce 6" N34°W 26.8 lks scribed 1/4 BT.
W. spruce 10" S49°E 56 lks scribed 1/4 BT.

Pipe and NBT's painted blue.

S498
T37N R15E
1/4 S 28
S 33
1975

Dated at Argonne, Wis., this 15th day of December, 1975.

Signature Philip T. Hansen Title Reg. Land Surveyor Registration No. S-498
(County Surveyor, Registered Land Surveyor, or other duly authorized official)

Office of Register of Deeds, County of Forest, I hereby certify that the within instrument was filed in this office for record on the 23rd day of December, 1975 at 2:30 o'clock P. M.

Eugene Staszny
(Register of Deeds)

DOCUMENT NUMBER **108442**

By..... Deputy

48715280010