


CERTIFIED LAND CORNER RESTORATION

Index No. **U-33**


State of Wisconsin }  
County of Forest } ss.

I Daniel K. Pleoger, do hereby certify that on the 13 day of August, 19 81, I found evidence of the s/c 1/16 corner of Section 30 Township 37, North, Range 15 East, Fourth Principal Meridian, as described hereon; and that from this evidence I established a new monument and accessories as described hereon to perpetuate the original location of this corner.

Resident witnesses:

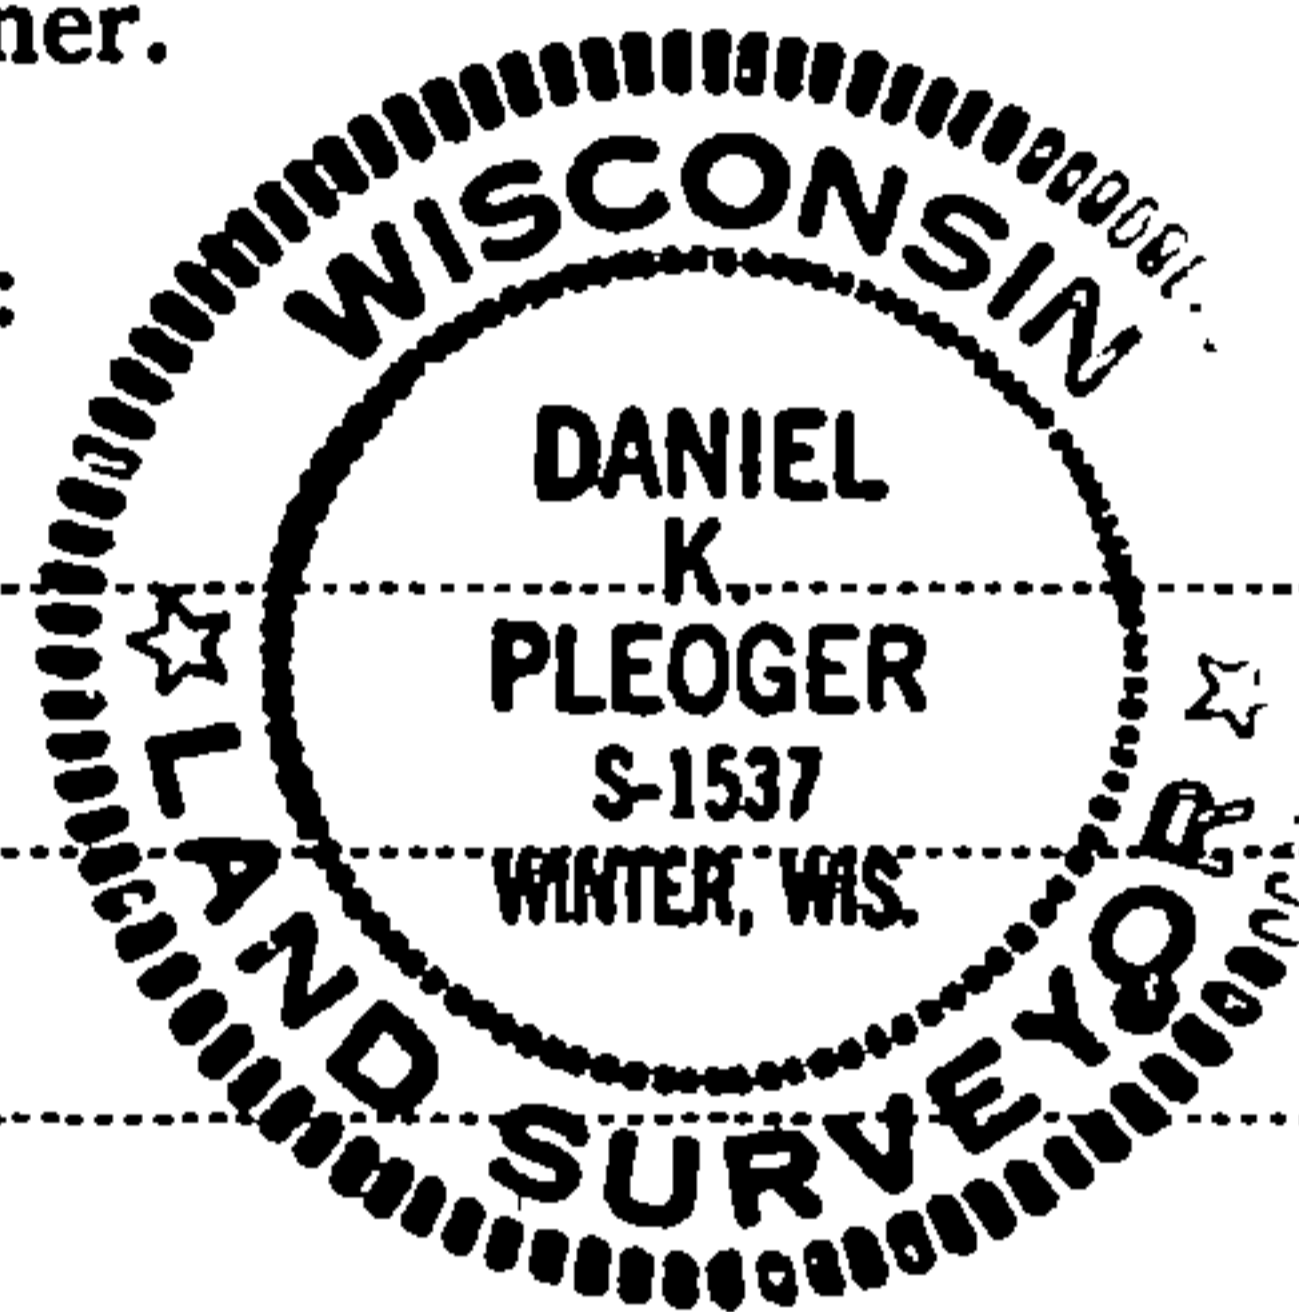

FORM 985 M. C. MILLER CO., MILWAUKEE

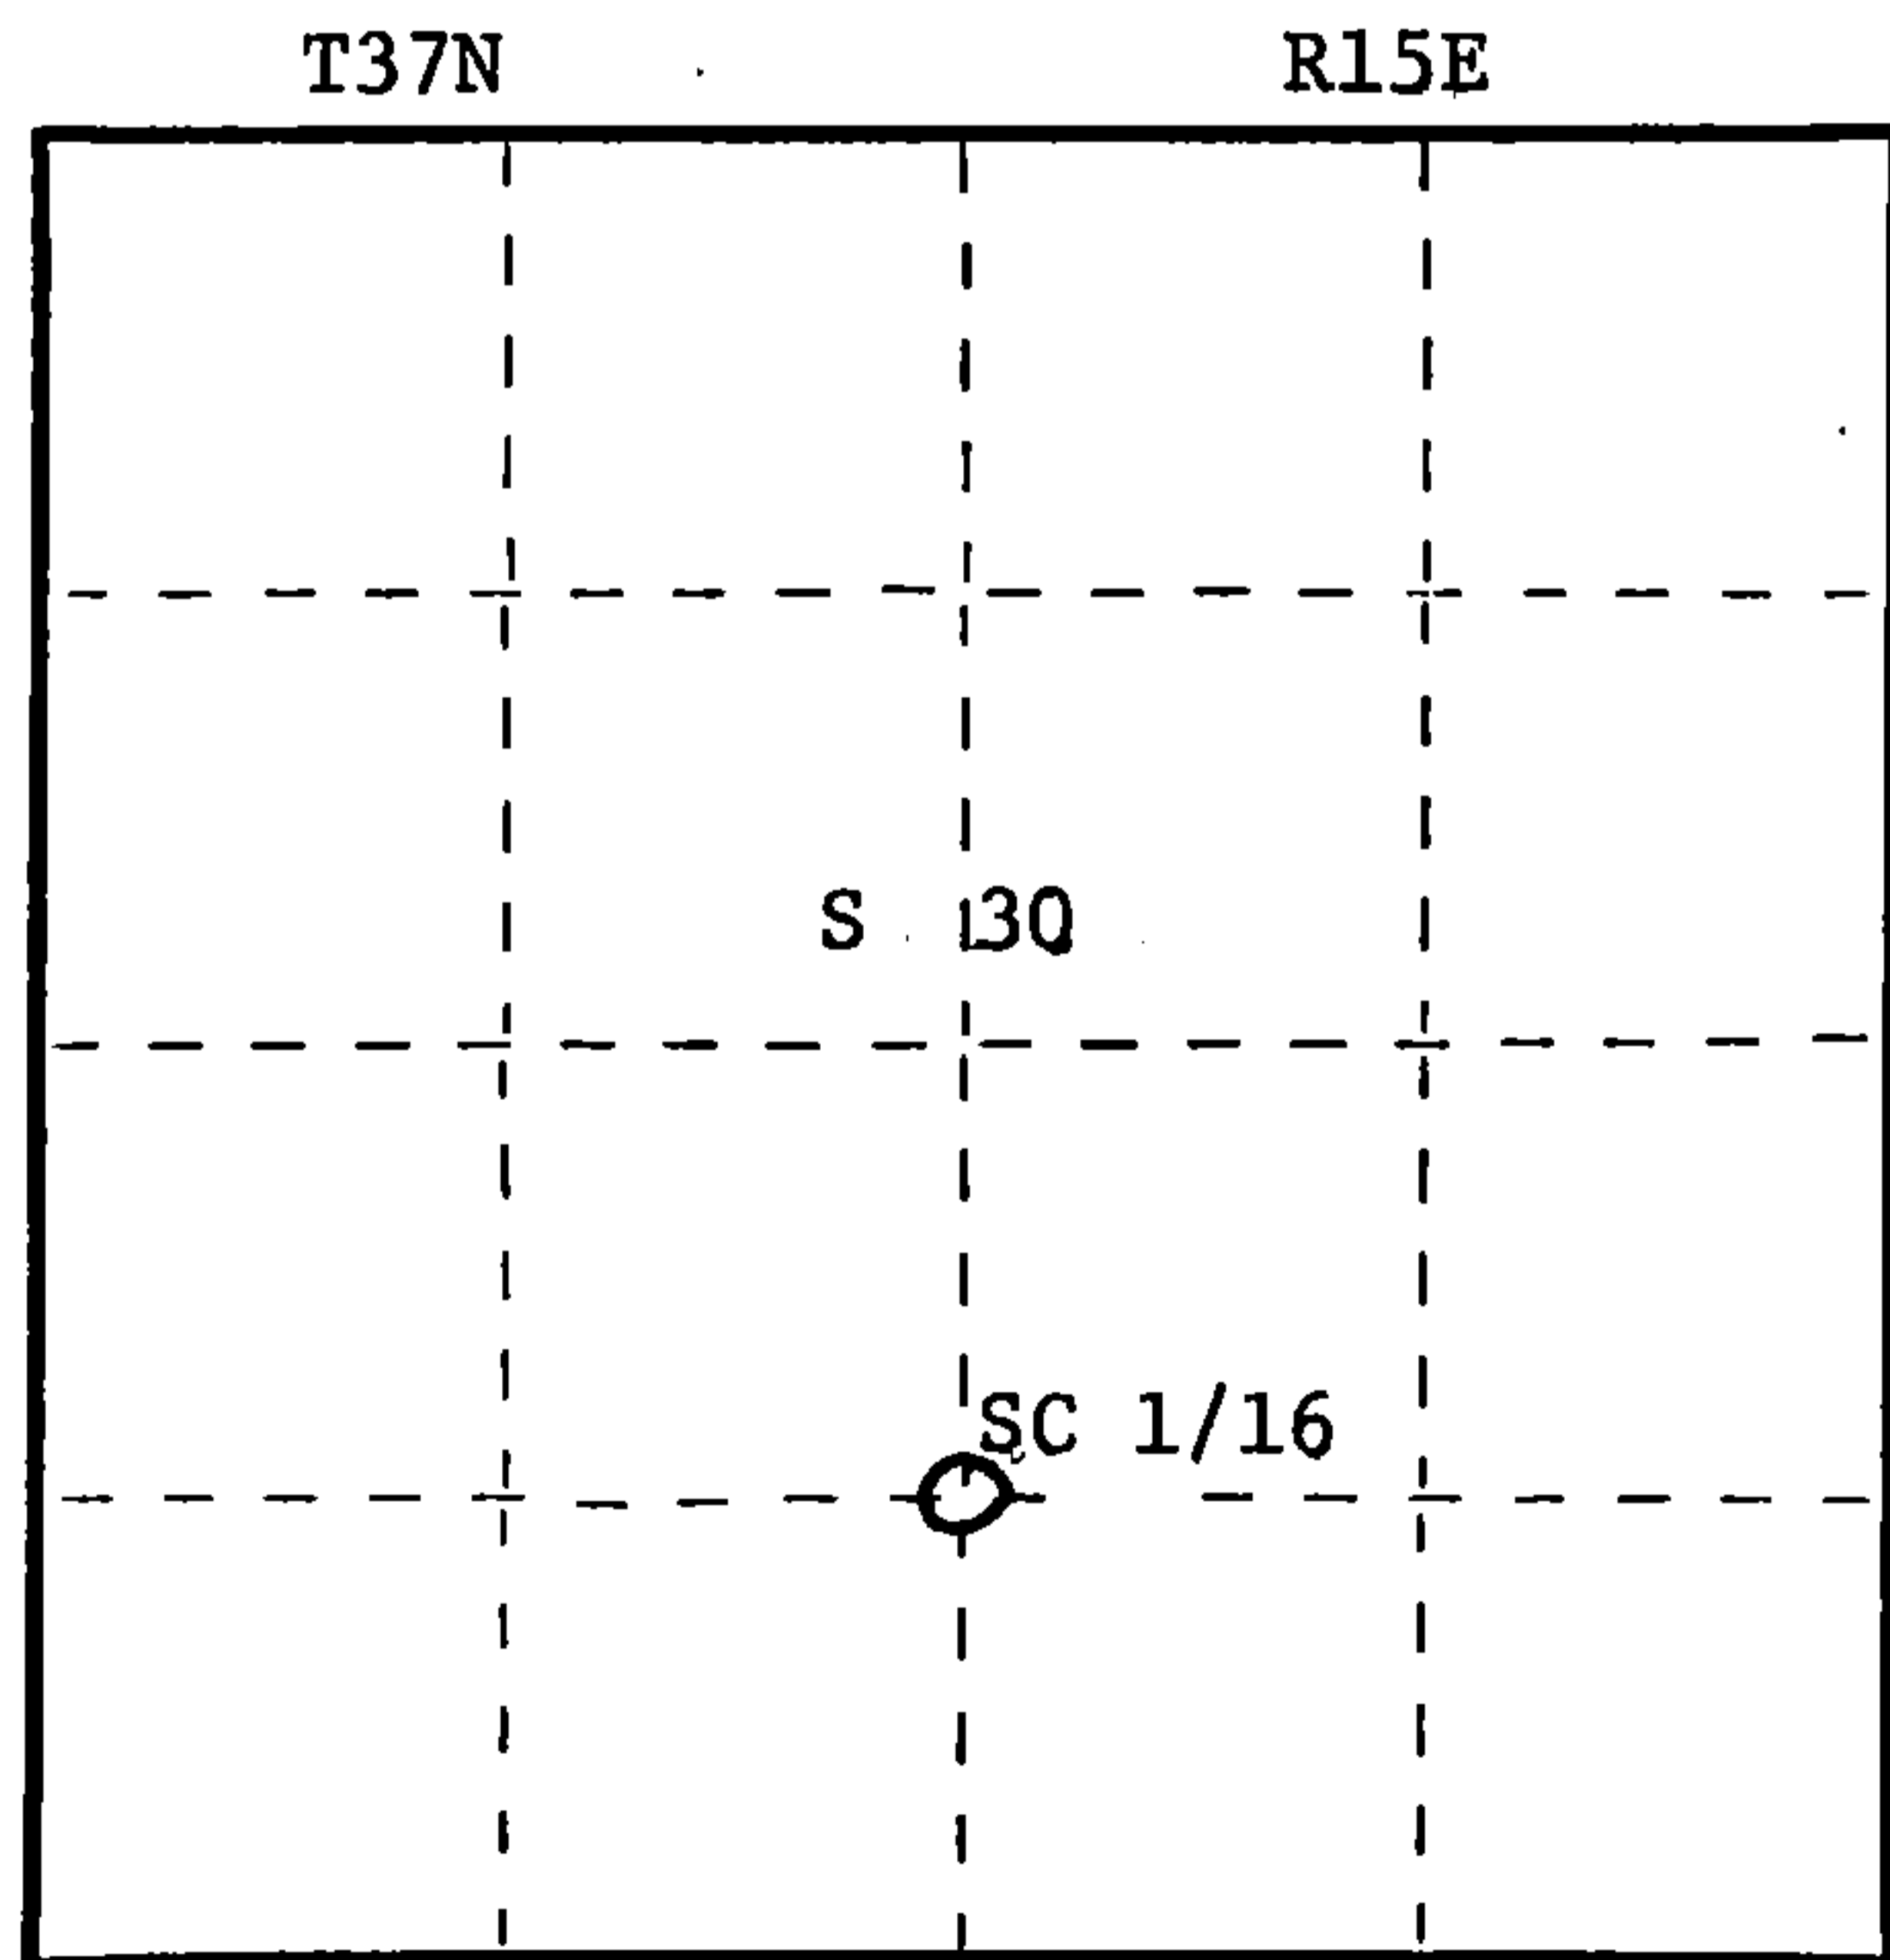

○ = Corner monument restored.

History of original corner establishment:  
No evidence of any previous corner.

Description of corner evidence found:  
Total distance from 1/4 corner between sections 30 & 31 to C 1/4 corner section 30 is 2621.881 ft. at bearing No-11-13W.  
Set SC 1/16 1310.95 ft. intermediate.

Description of monument and accessories I established to perpetuate the original location of this corner.  
Set a 1 1/2" iron pipe with 2" diameter aluminum cap stamped: S1537  
Corner sets in center of creek - placed large rock cairn T37N R15E  
around pipe. SC 1/16 S 30  
Monument projects 24" above water. C.P.I. - 1981  
Marked NBTs  
Black ash 14" S54E 18.85 ft.  
Black ash 5" S10E 16.24 ft.  
Scribed 1/16 BT

Dated at Rhinelander, Wis., this 16 day of September, 19 81

Signature Daniel K. Pleoger Title Registered Land Surveyor Registration No. 1537  
(County Surveyor, Registered Land Surveyor, or other duly authorized official)

Office of Register of Deeds, County of Forest, I hereby certify that the within instrument was filed in this office for record on the 25th day of September, 1981 at 2:00 o'clock P. M.

Eugene Stutzman (Register of Deeds)  
By Deputy

DOCUMENT NO. 120536

43715301020