


CERTIFIED LAND CORNER RESTORATION

Index No. **T-22**

State of Wisconsin }
County of Forest } ss.

I Daniel K. Pleoger, do hereby
certify that on the 14 day
of July, 19 81, I ~~restored~~
Established the WC 1/16
corner of Section 30
Township 37, North, Range
15 East, Fourth Principal Meridian,
as described hereon; and that from this evidence
I established a new monument and accessories
as described hereon to perpetuate the original
location of this corner.

Resident witnesses:

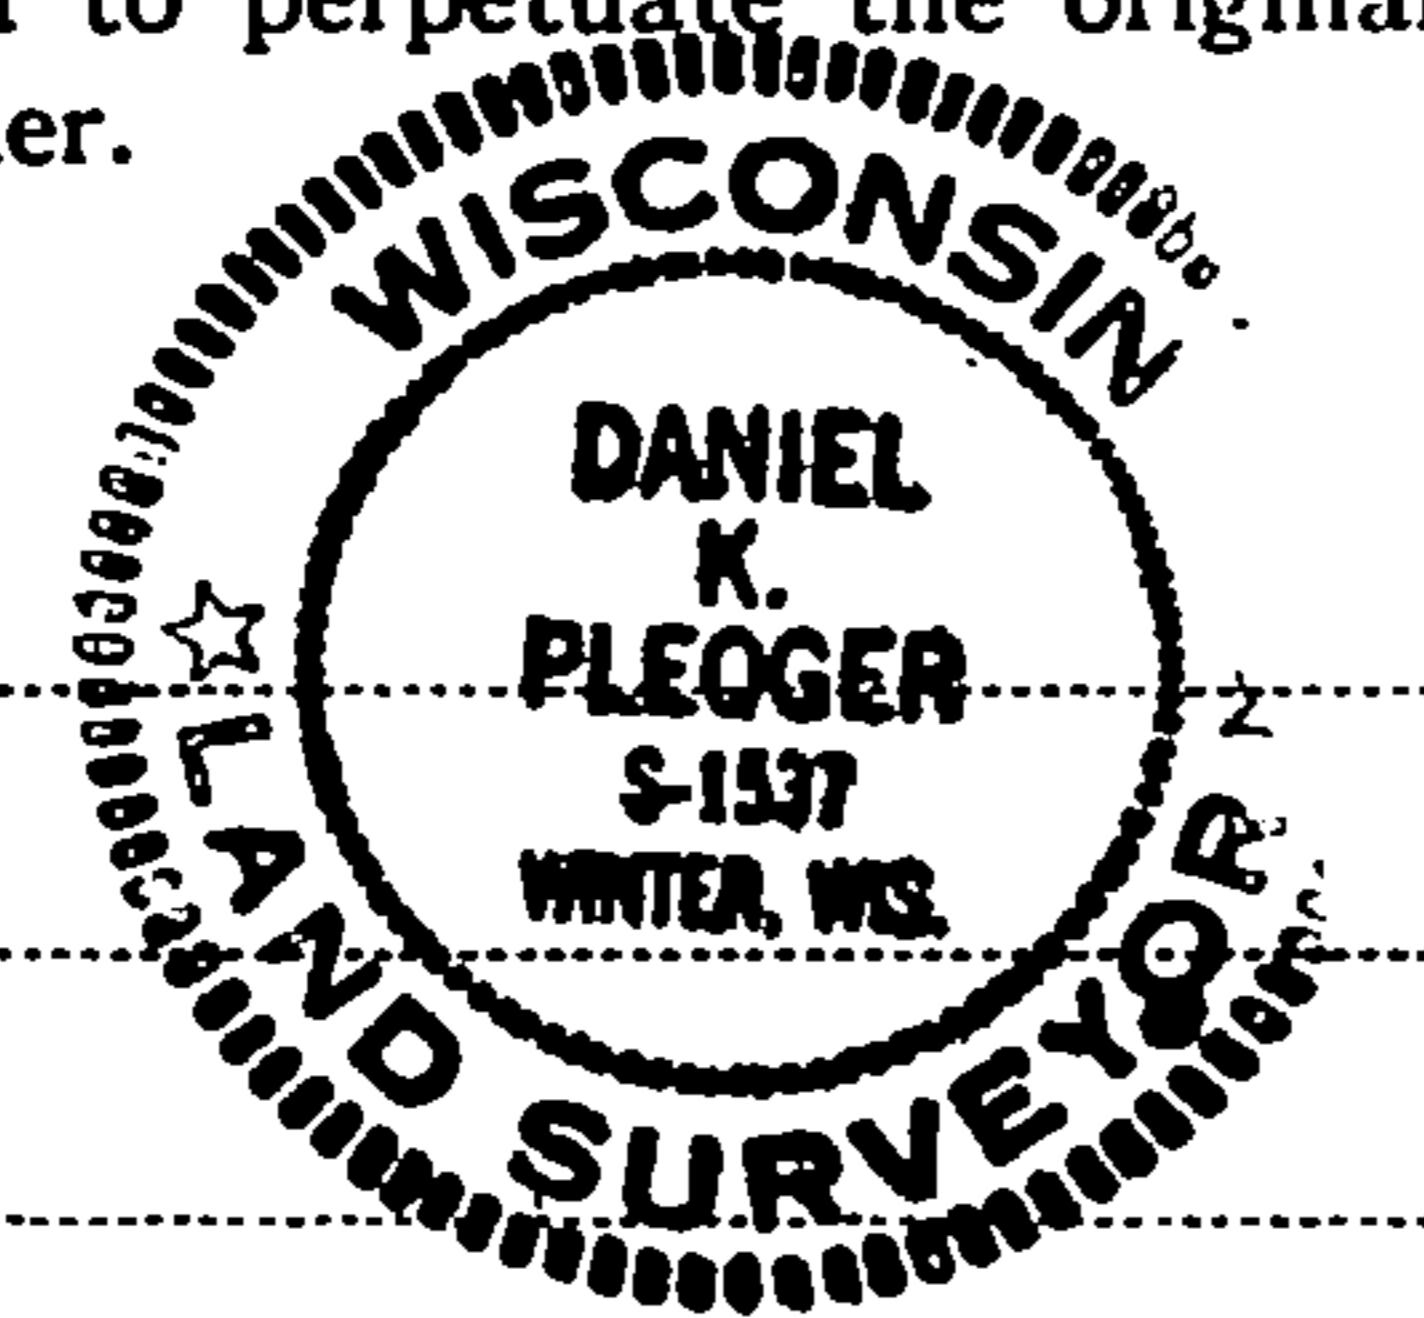

History of original corner establishment:
No evidence of any previous corner


Description of corner evidence found:
Total distance from 1/4 corner between sections 25 & 30 T37N R14 & 15E to C 1/4 corner section 30 is 2434.996 ft at bearing N85-23-52E. Set WC 1/16 1234.809 ft. of 1/4 corner and 1200.187 ft. of C1/4 corner.

Description of monument and accessories I established to perpetuate the original location of this corner.
Set a 1 1/2" iron pipe with 2" diameter brass cap stamped:

Monument projects 18" above ground
Marked NBTs
Black cherry 8" N69E 45.43 ft.
Black cherry 8" S47E 54.69 ft. Scribed 1/16 - B.T.
No other suitable B.T.s near

S1537
T37N R15E
WC 1/16 $\frac{S}{|} \frac{30}{|}$
C.P.I. - 1981

FORM 985 H. C. MILLER CO., MILWAUKEE

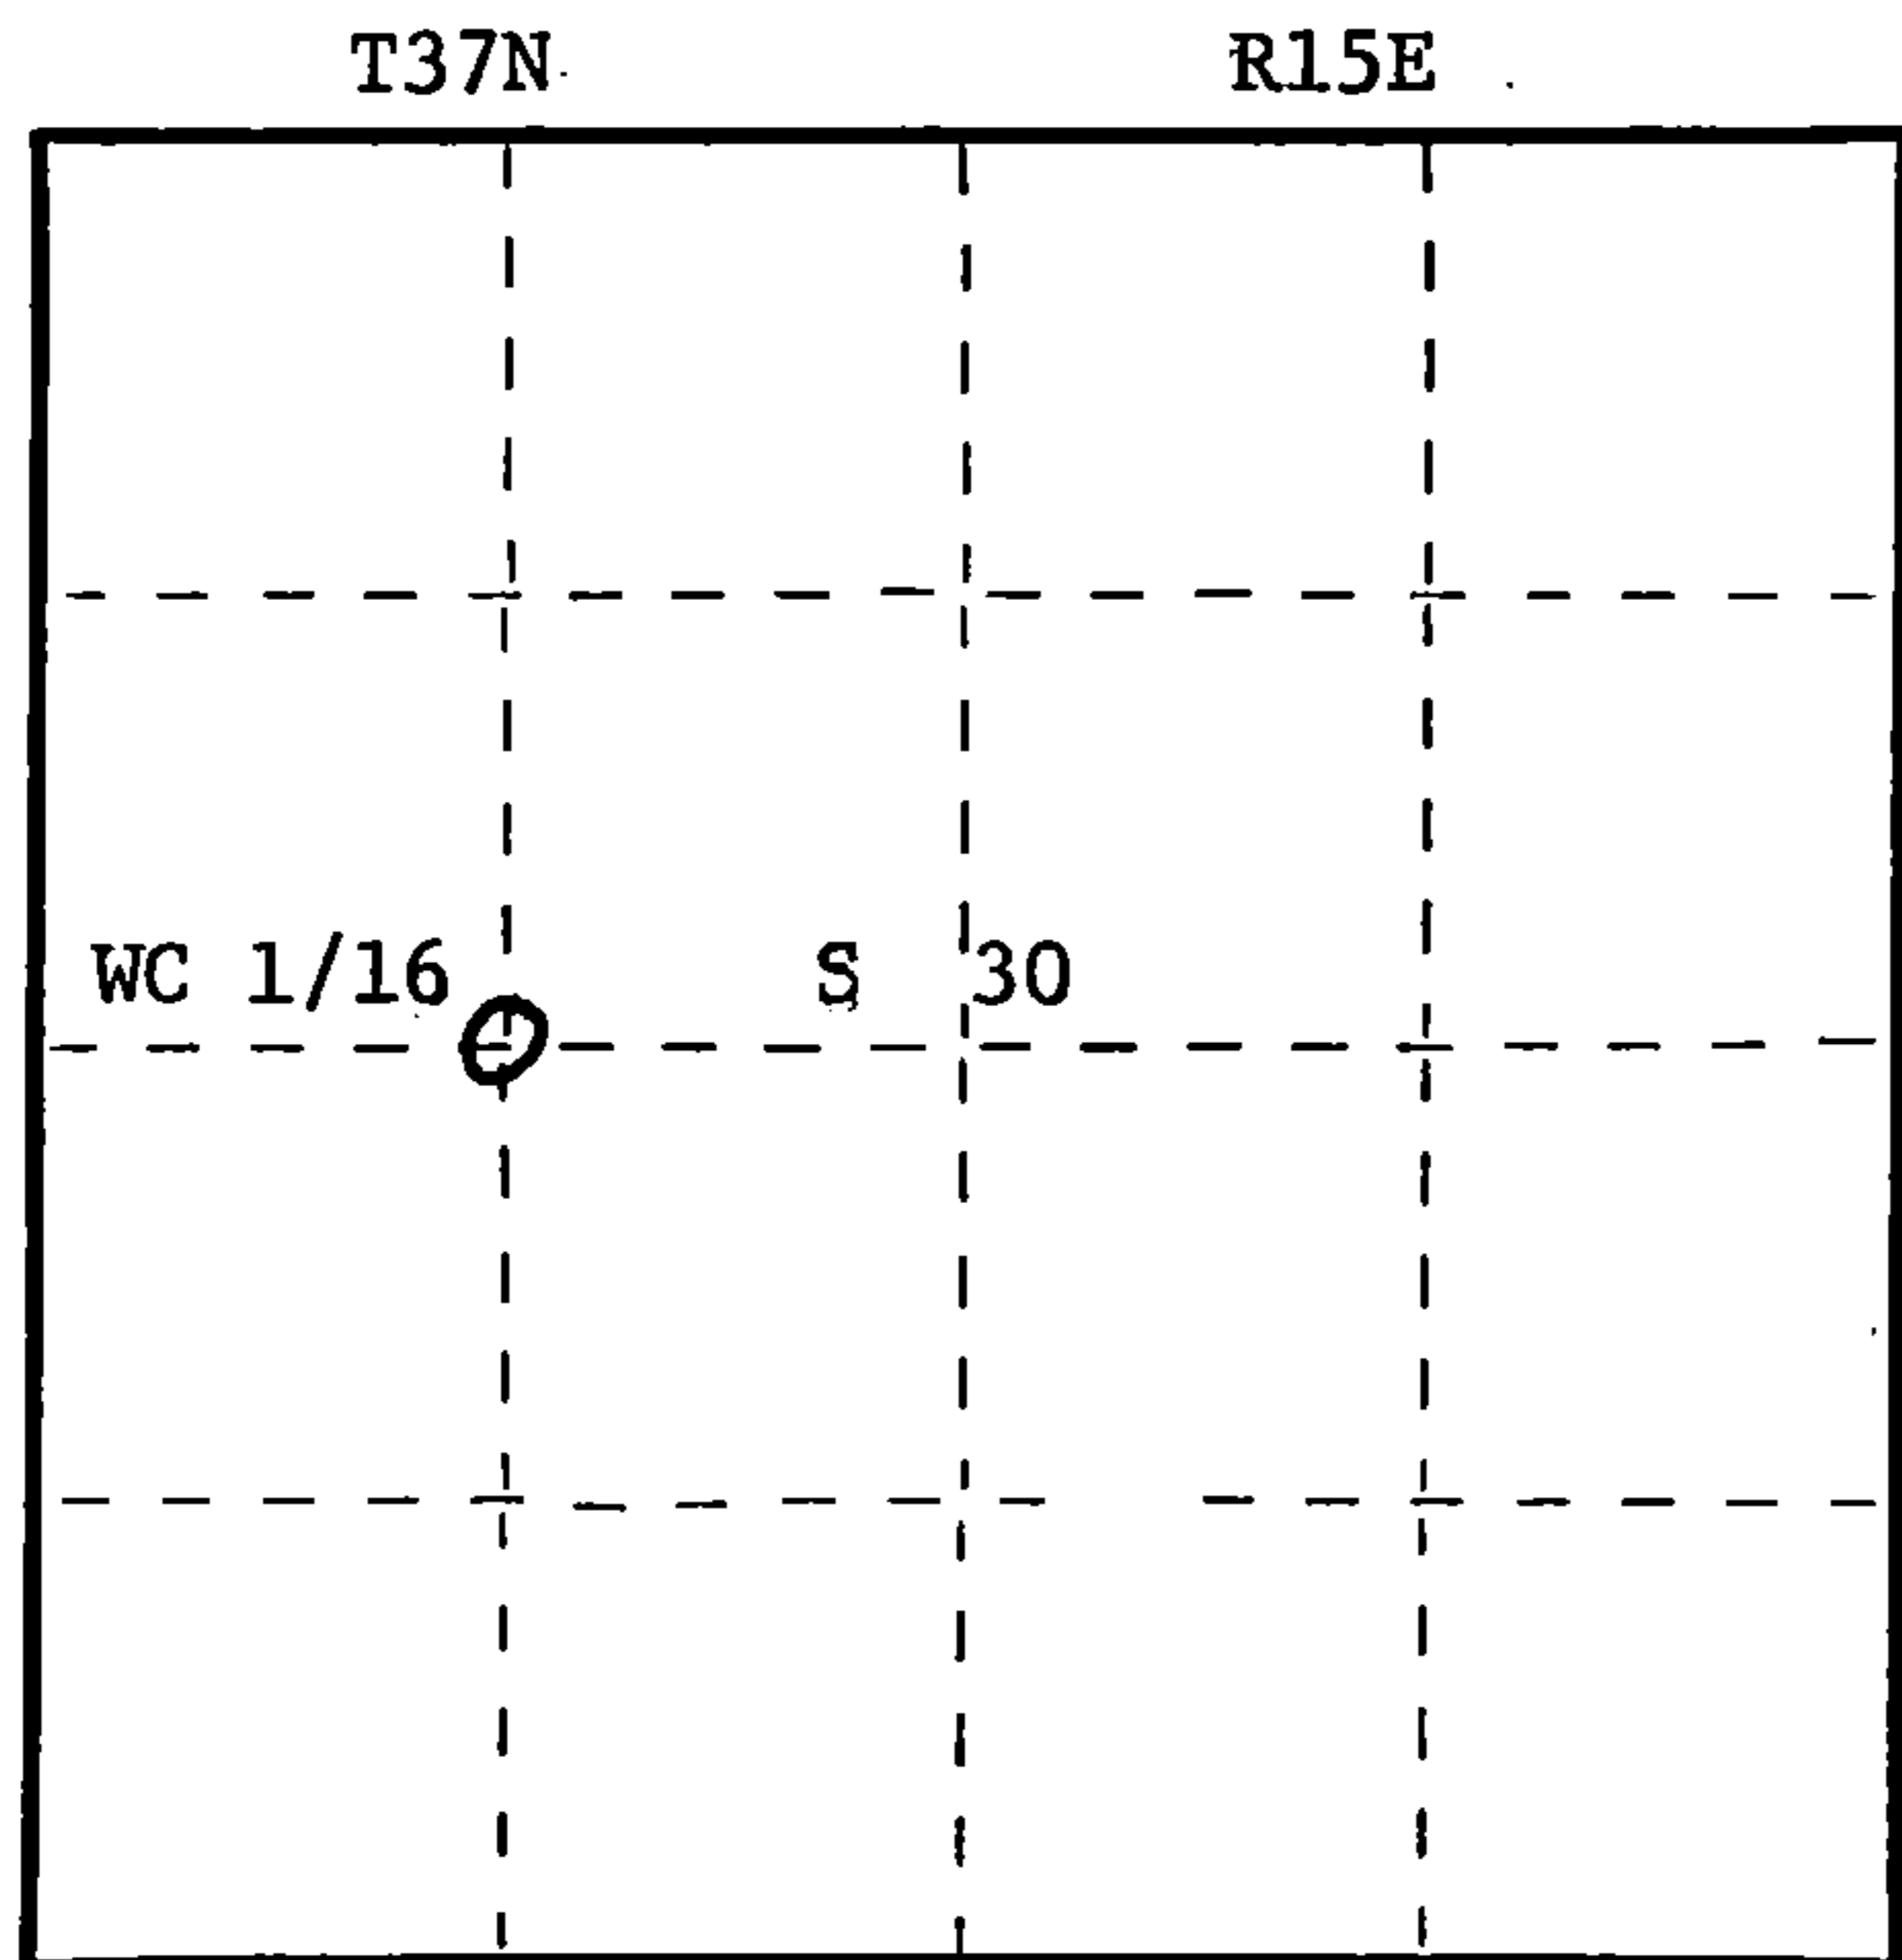

○ = Corner monument restored.

Dated at Rhineland, Wis., this 17 day of September, 1981

Signature Daniel K. Pleoger Title Registered Land Surveyor Registration No. 1537
(County Surveyor, Registered Land Surveyor, or other duly authorized official)

Office of Register of Deeds, County of Forest, I hereby certify that the within instrument was filed in this office for record on the 25th day of September, 1981 at 2:00 o'clock P. M.

Eugene Staszynski
(Register of Deeds)
By _____ Deputy

DOCUMENT NO. **120533**

43715302030