


CERTIFIED LAND CORNER RESTORATION

Index No. **S-33**


State of Wisconsin }
County of Forest } ss.

I Daniel K. Pleoger, do hereby certify that on the 30 day of June, 1981, I found evidence of the NC 1/16 corner of Section 30 Township 37 North, Range 15 East, Fourth Principal Meridian, as described hereon; and that from this evidence I established a new monument and accessories as described hereon to perpetuate the original location of this corner.

Resident witnesses:

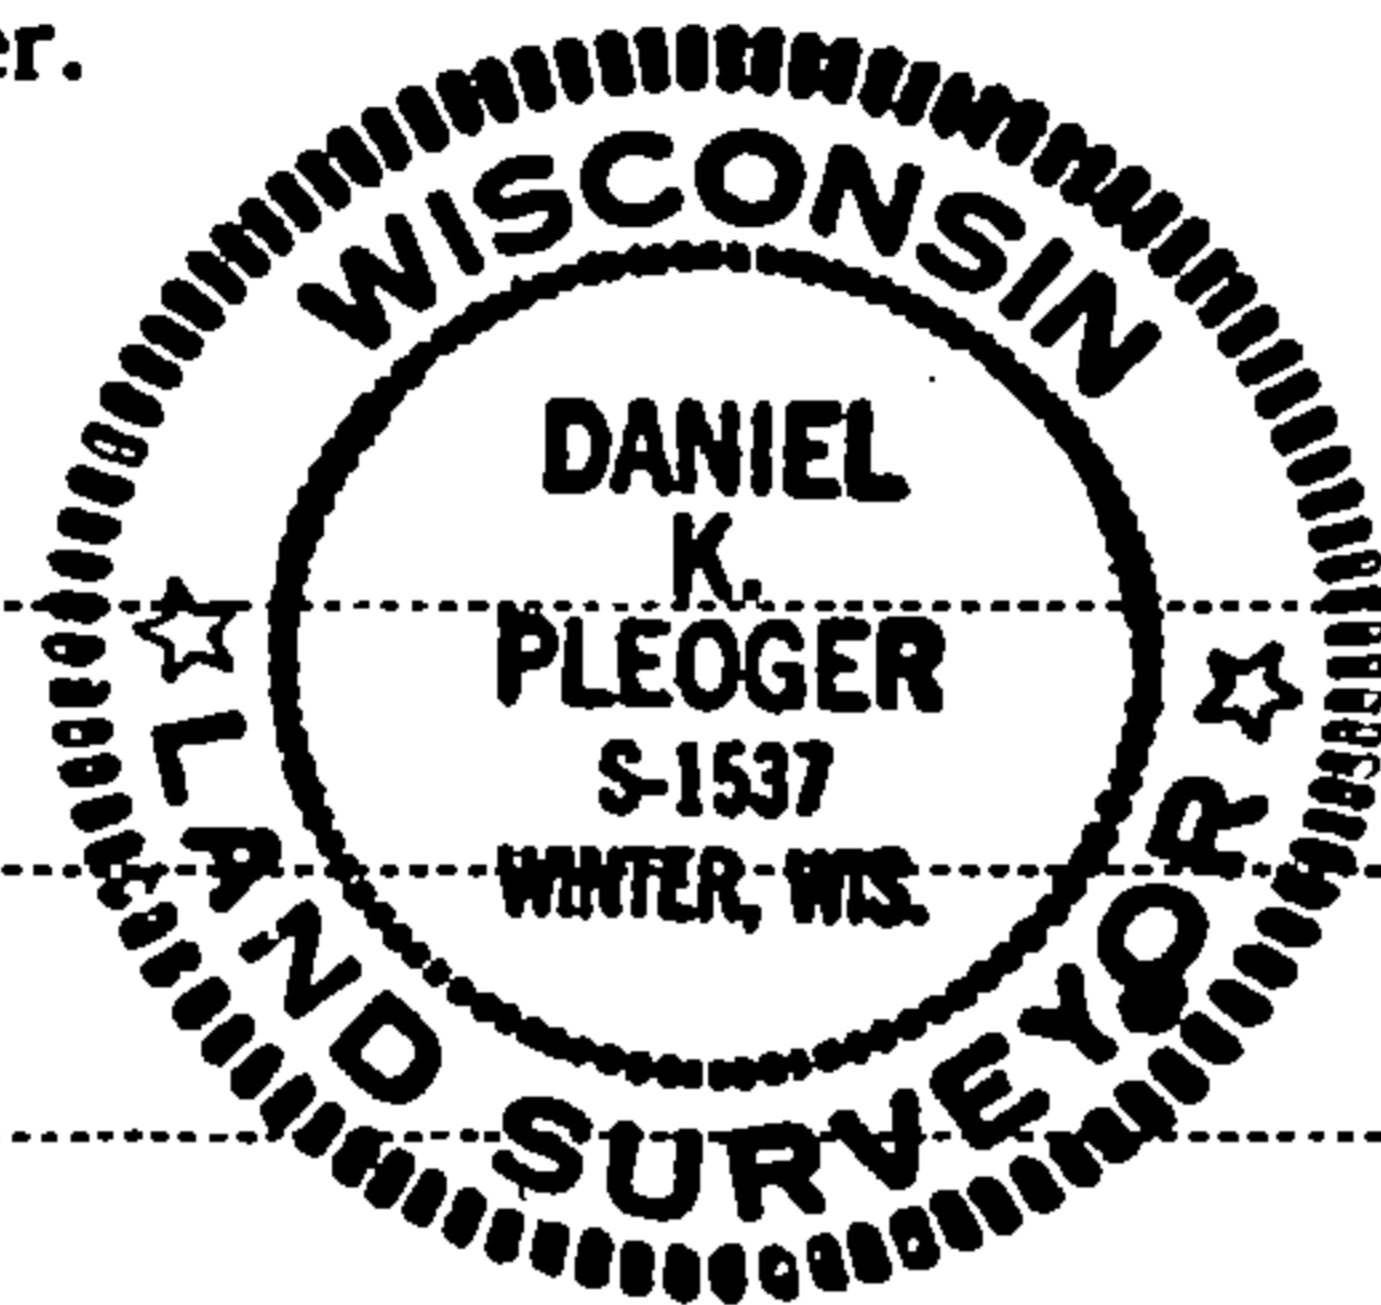

FORM 985 R. C. MILLER CO., MILWAUKEE

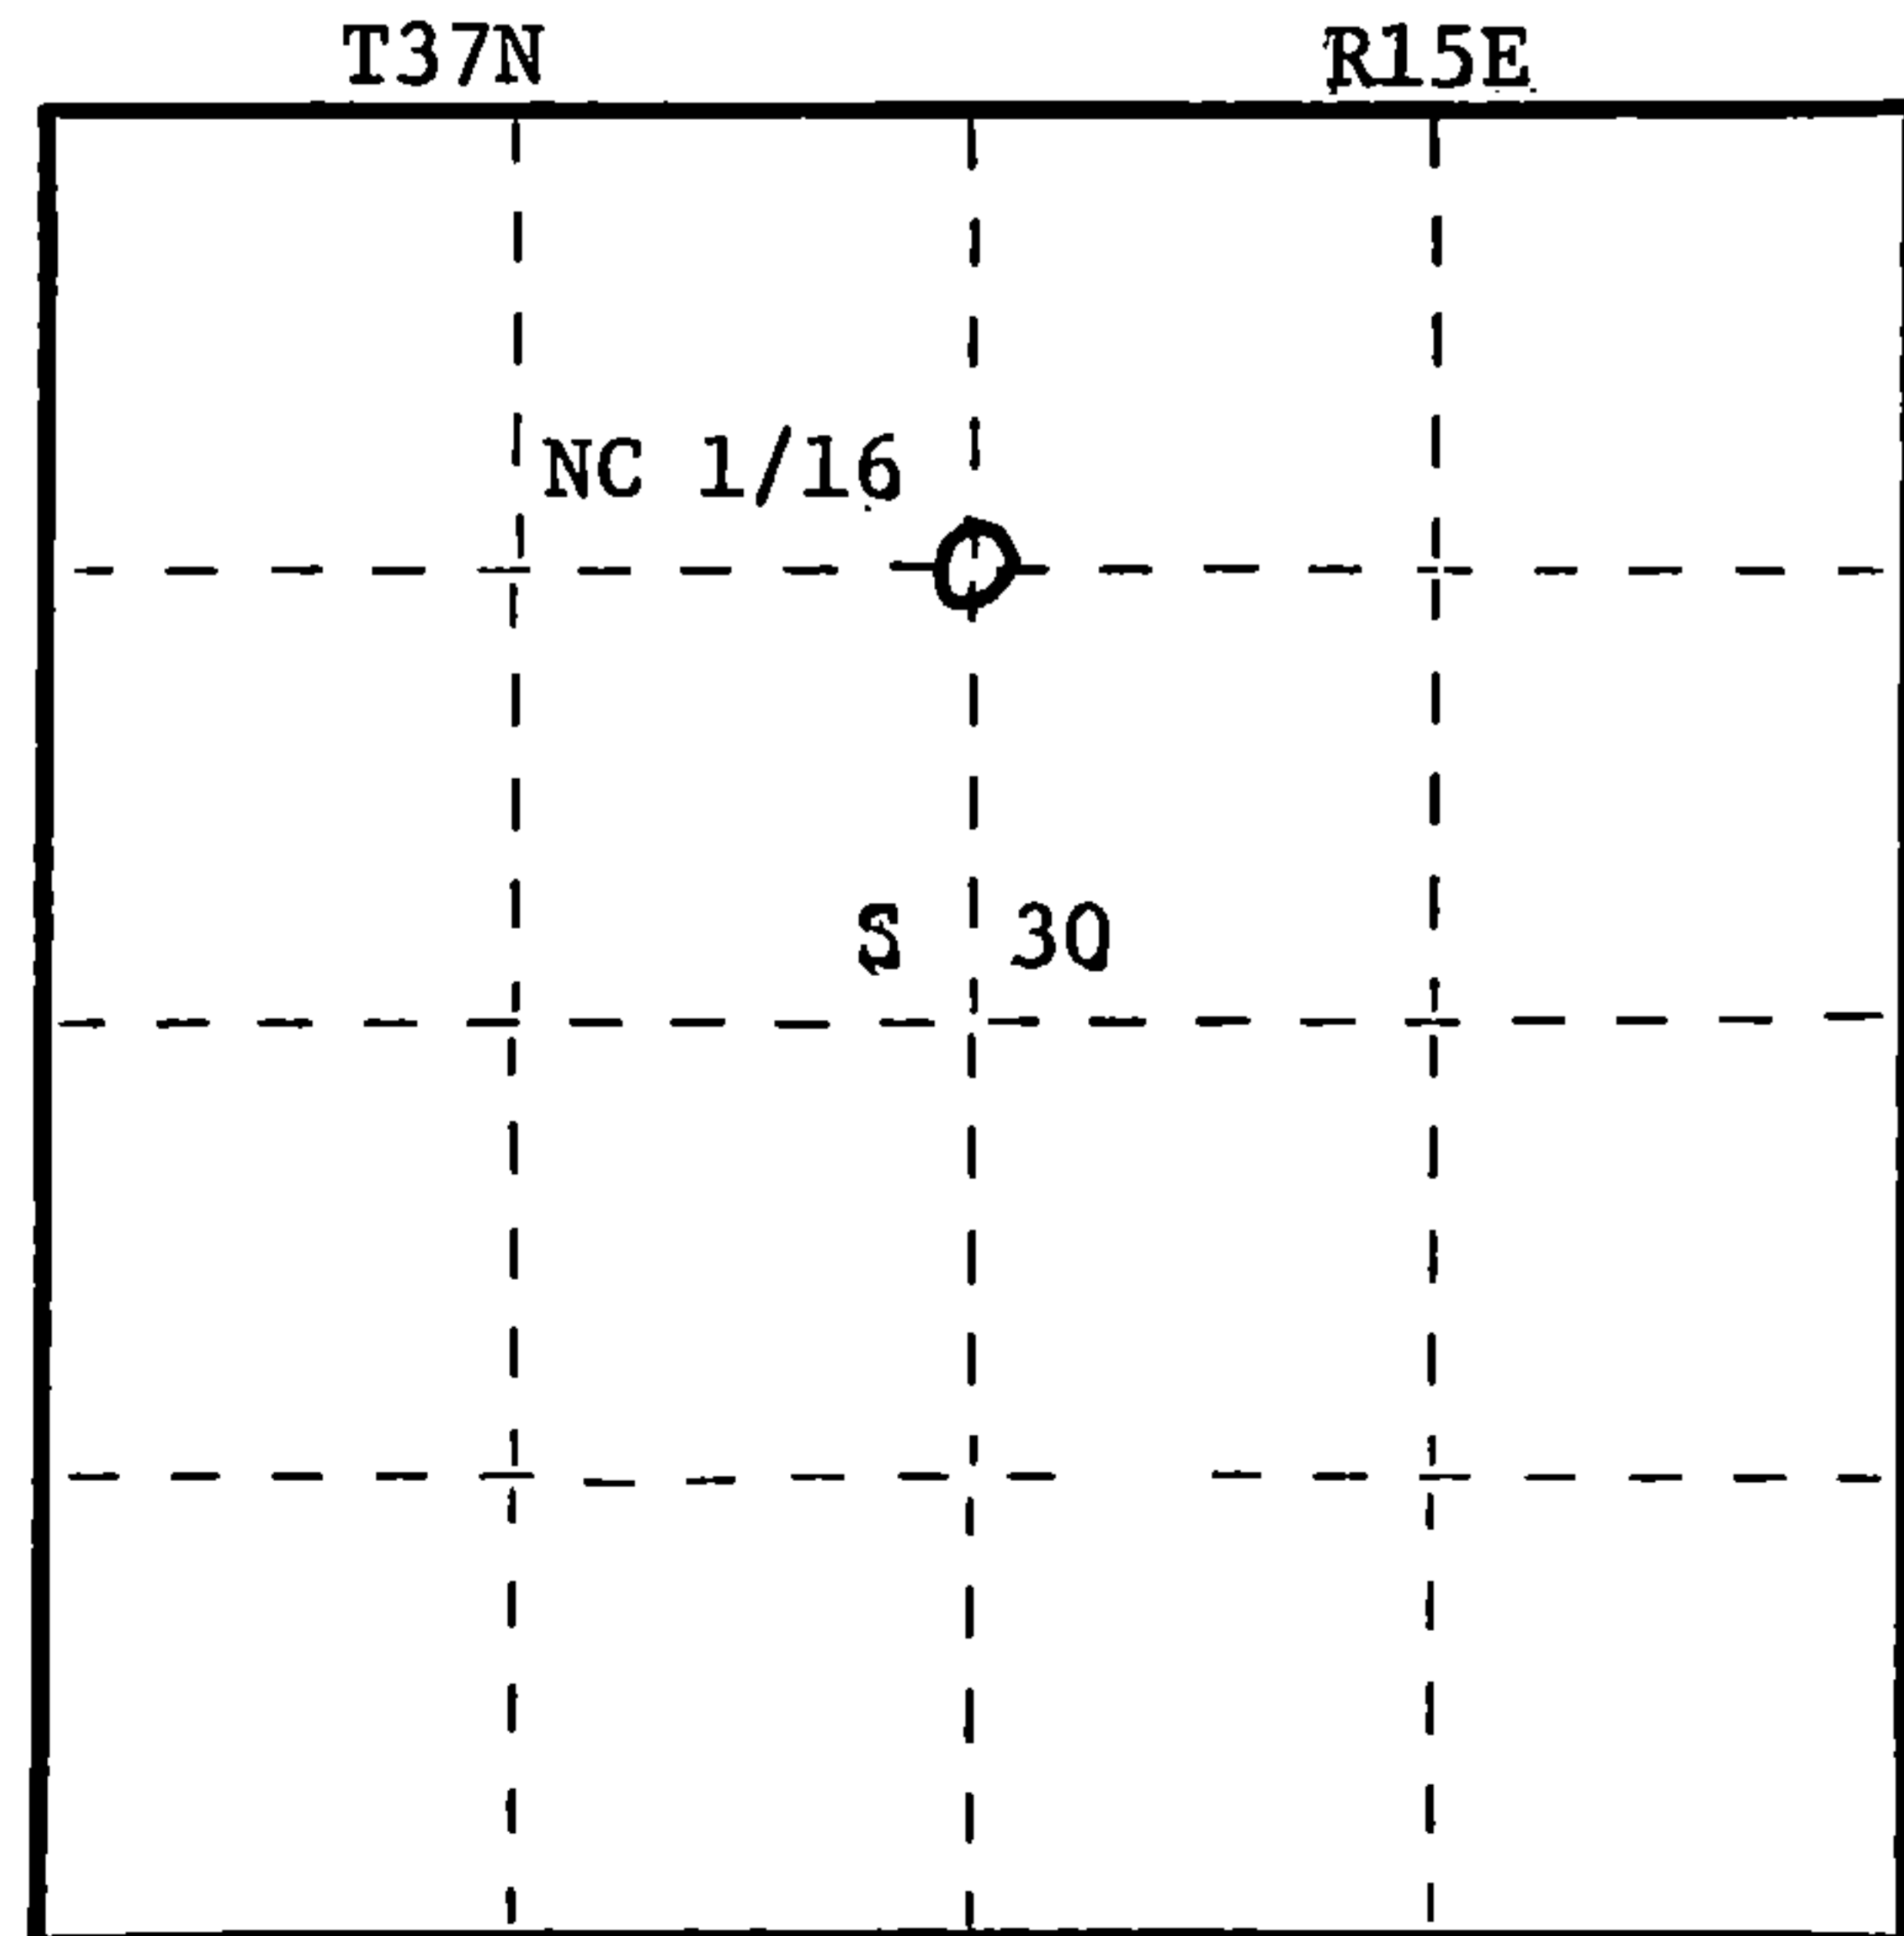

○ = Corner monument restored.

History of original corner establishment:

No evidence of any previous corner.

Description of corner evidence found:

Total distance from 1/4 corner between sections 19 & 30 to C 1/4 corner section 30 is 2791.891 ft. at bearing S0-48-10E.
Set NC 1/16 1395.945 ft. intermediate.

Description of monument and accessories I established to perpetuate the original location of this corner.

Set a 1 1/2" iron pipe with 2" diameter brass cap stamped
Monument projects 18" above ground
Marked NBTs
Basswood 8" N33W 20.45 ft.
Elm 13" S48W 43.60 ft.
Scribed 1/16 - B.T.

T37N R15E
NC 1/16 S 30
S1537 - 1981

Dated at Rhinelander, Wis., this 21 day of September, 1981.

Signature Daniel K. Pleoger Title Registered Land Surveyor Registration No. 1537
(County Surveyor, Registered Land Surveyor, or other duly authorized official)

Office of Register of Deeds, County of Forest, I hereby certify that the within instrument was filed in this office for record on the 25th day of September, 1981 at 2:00 o'clock P.M.

Eugene Staszynski (Register of Deeds)

By Deputy

DOCUMENT NO. 120530

43719303020