

CERTIFIED LAND CORNER RESTORATION

Index No. S-22

State of Wisconsin }
County of Forest } ss.

I Daniel K. Pleoger, do hereby
certify that on the 14 day
of July, 19 81, I


Established the NW 1/16
corner of Section 30
Township 37, North, Range
15 East, Fourth Principal Meridian,
as described hereon; and that from this evidence
I established a new monument and accessories
as described hereon to perpetuate the original
location of this corner.

Resident witnesses:



FORM 985 M. C. MILLER CO., MILWAUKEE

T37N R15E

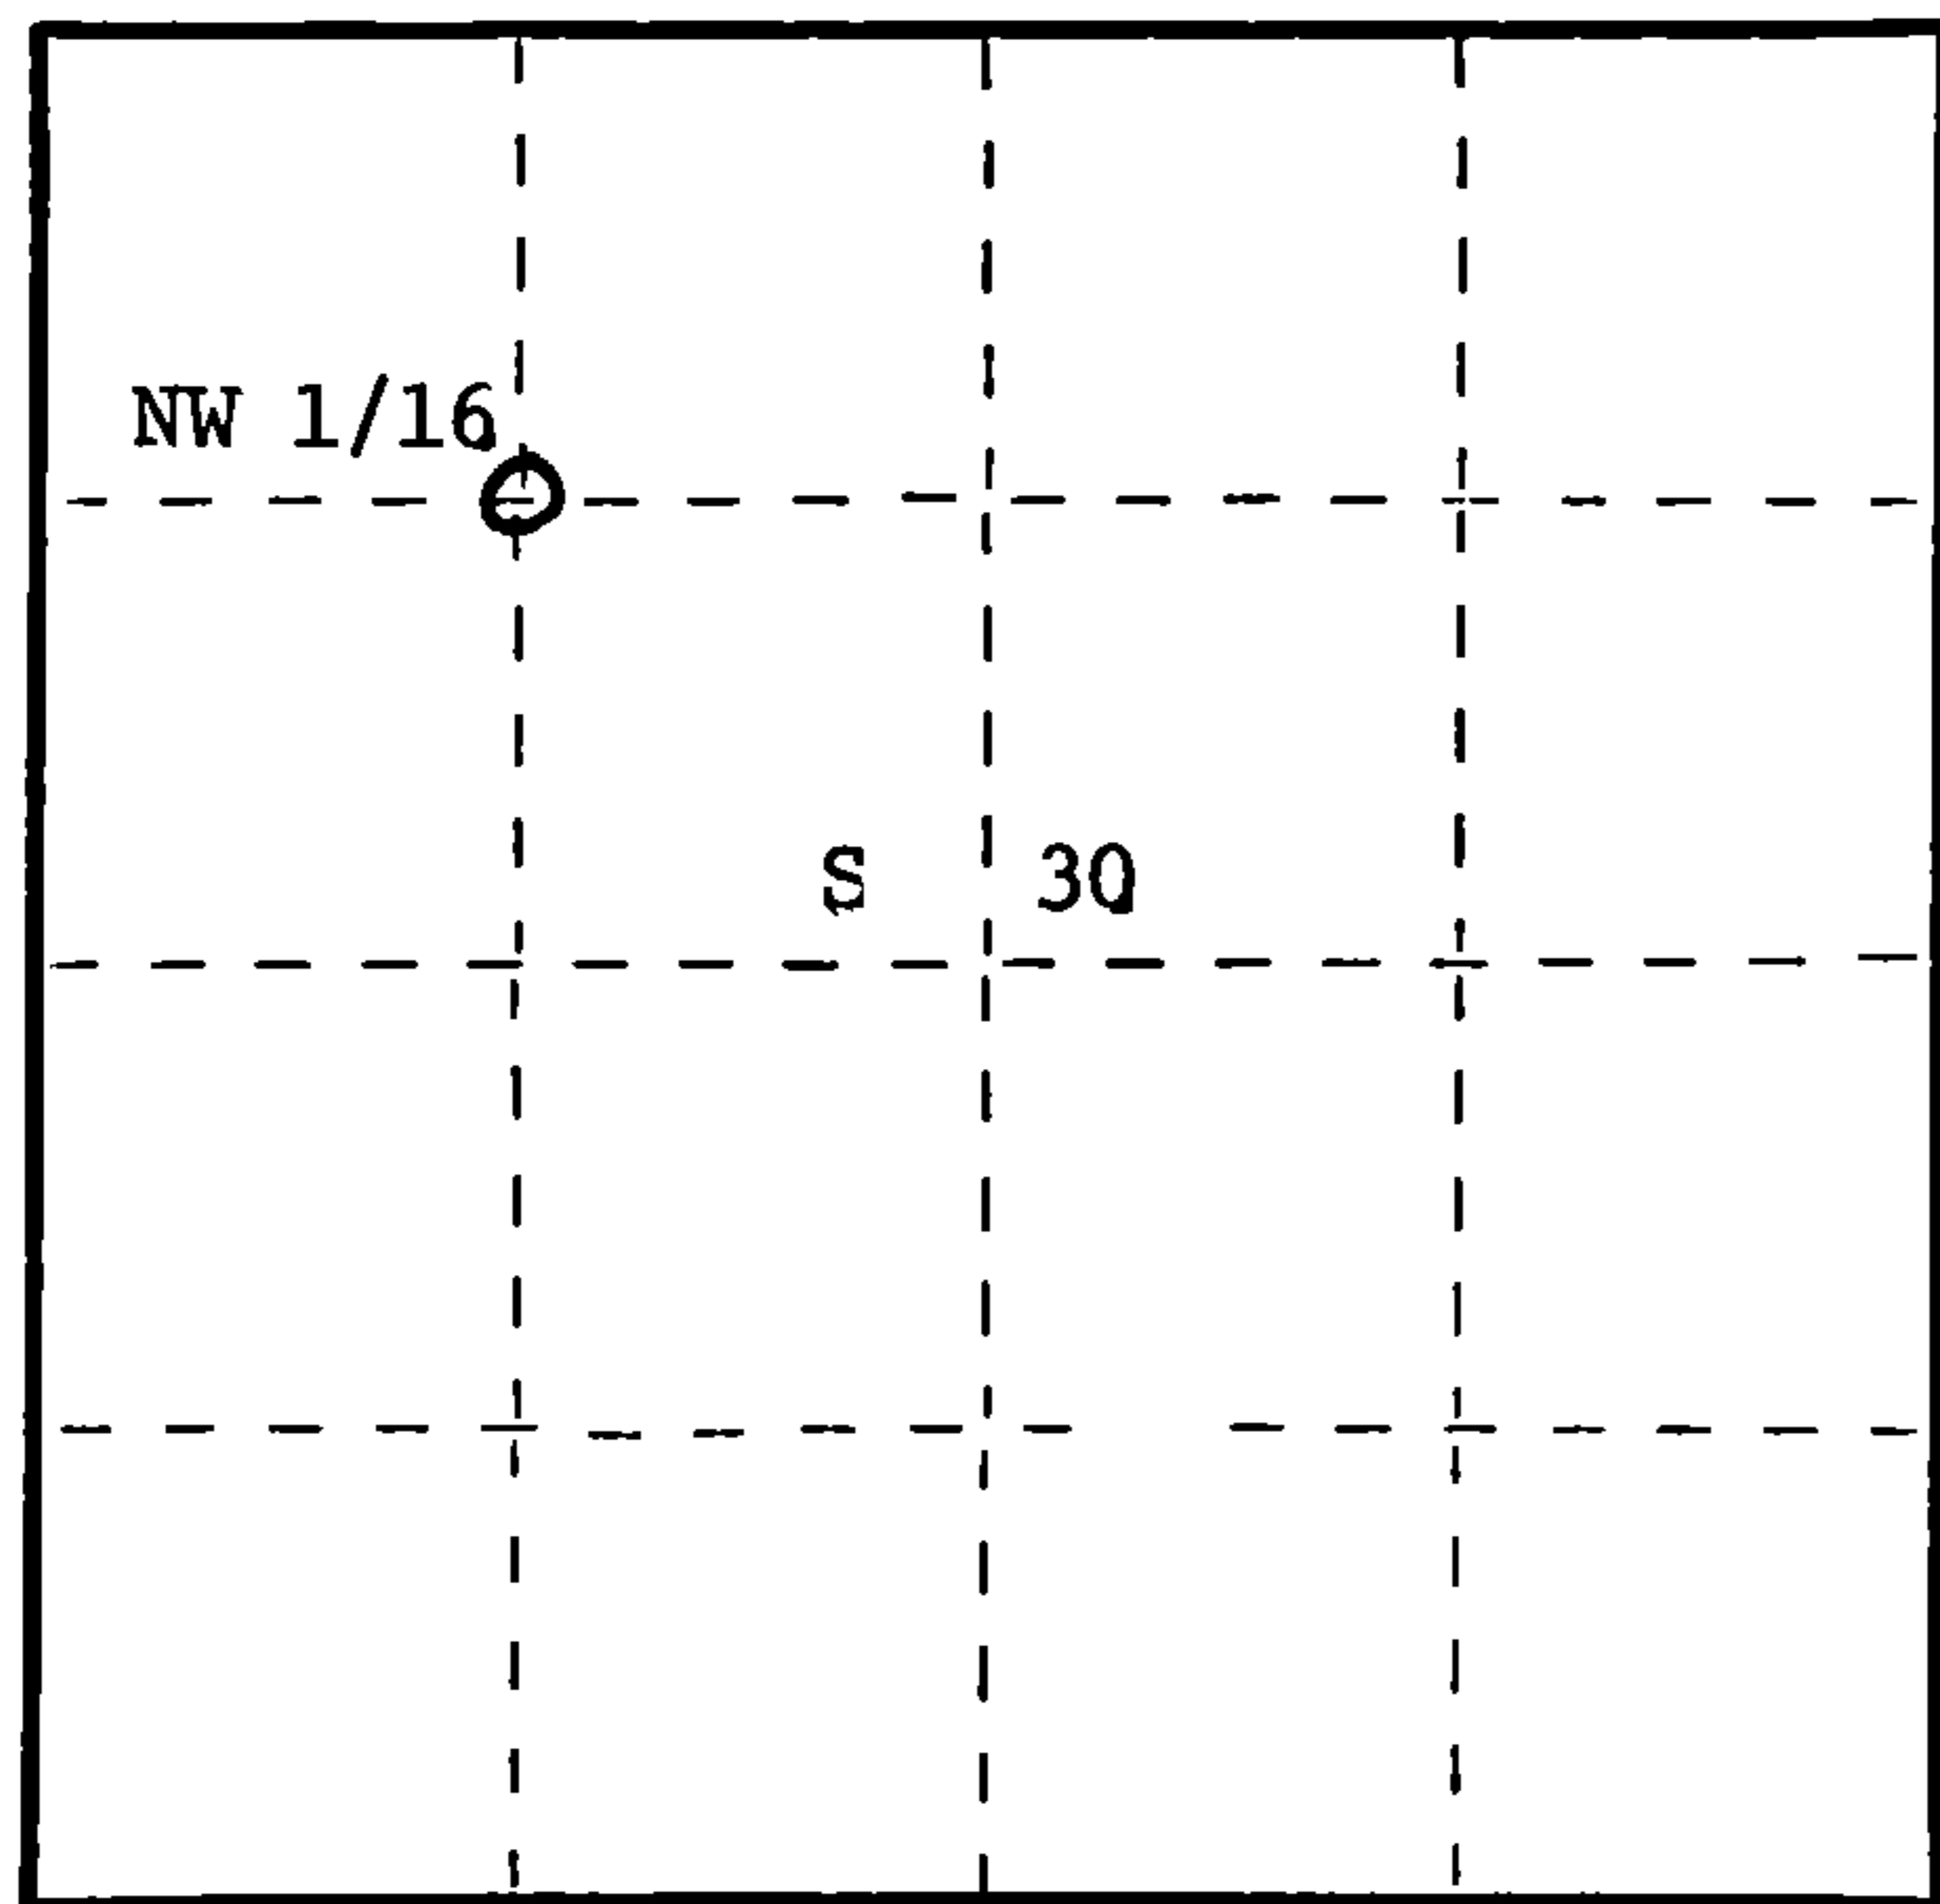

○ = Corner monument restored.

History of original corner establishment:
No evidence of any previous corner.

Description of corner evidence found:

Corner established by subdivision of the NW 1/4.
Location of NW 1/16 is S83-22-24W 1189.126 ft. of NC 1/16 and N0-11-13W 1354.882 ft.
of WC 1/16

Description of monument and accessories I established to perpetuate the original location of this corner.
Set a 1 1/2" iron pipe with 2" diameter brass cap stamped:

Monument projects 18" above ground

Marked N.B.T.s
Maple 7" N8°E 54.10 ft.
Sugar 7" S14E 69.90 ft. - Scribed 1/16 - B.T.

S1537
T37N R15E
NW 1/16 S 30
C.P.I. - 1981

Dated at Rhinelander, Wis., this 17 day of September, 19 81

Signature Daniel K. Pleoger Title Registered Land Surveyor Registration No. 1537
(County Surveyor, Registered Land Surveyor, or other duly authorized official)

Office of Register of Deeds, County of Forest, I hereby certify that the within
instrument was filed in this office for record on the 25th day of September, 19 81
at 2:00 o'clock P. M.

By Eugene Stegny (Register of Deeds) Deputy

DOCUMENT NO. 120529

43715303030