

CERTIFIED LAND CORNER RESTORATION

State of Wisconsin }
 County of Forest } ss.

I Milo E. Stefan, do hereby certify that on the 19th day of May, 1981, I found evidence of the North Quarter corner of Section 5 Township 36 North, Range 15 East, Fourth Principal Meridian, as described hereon; and that from this evidence I established a new monument and accessories as described hereon to perpetuate the original location of this corner:

Description of original monument and accessories and subsequent restorations:

Surveyed in 1857 by Artemus Curtis
 40.00 chains west between sections 5 and 32, Set 1/4 section post.
 Aspen 7", N.29°E., 27 lks.
 Aspen 8", S.48°W., 21 lks.
 3.00 chains west, enter swamp bears north.
 8.25 chains east, spring brook, 8 lks., wide, runs north.


Description of corner evidence found:

Fallen squared cedar post, with 1 1/2" X 18" Galv. iron pipe 1.8' north 55° east of proper position from BT stump holes.
 Aspen stump hole, N.29°E., 27 lks.
 Aspen stump hole, S.48°W., 21 lks.
 Swamp call 3.00 chains, checks.
 Creek call 8.25 chains, checks.

Description of monument and accessories I established to perpetuate the location of this corner:

Places a 2" X 30" aluminum monument cap stamped to identify corner.
 Blazed and scribed the following new bearing trees:
 Sugar maple 4", N.65°E., 20.39 feet.
 Sugar maple 4", S.89°W., 34.59 feet
 Basswood 11", N. 5°W., 12.53 feet
 Placed mound of stone around monument.
 Set steel sign post north, 1.0 feet

DOCUMENT NO.
119855

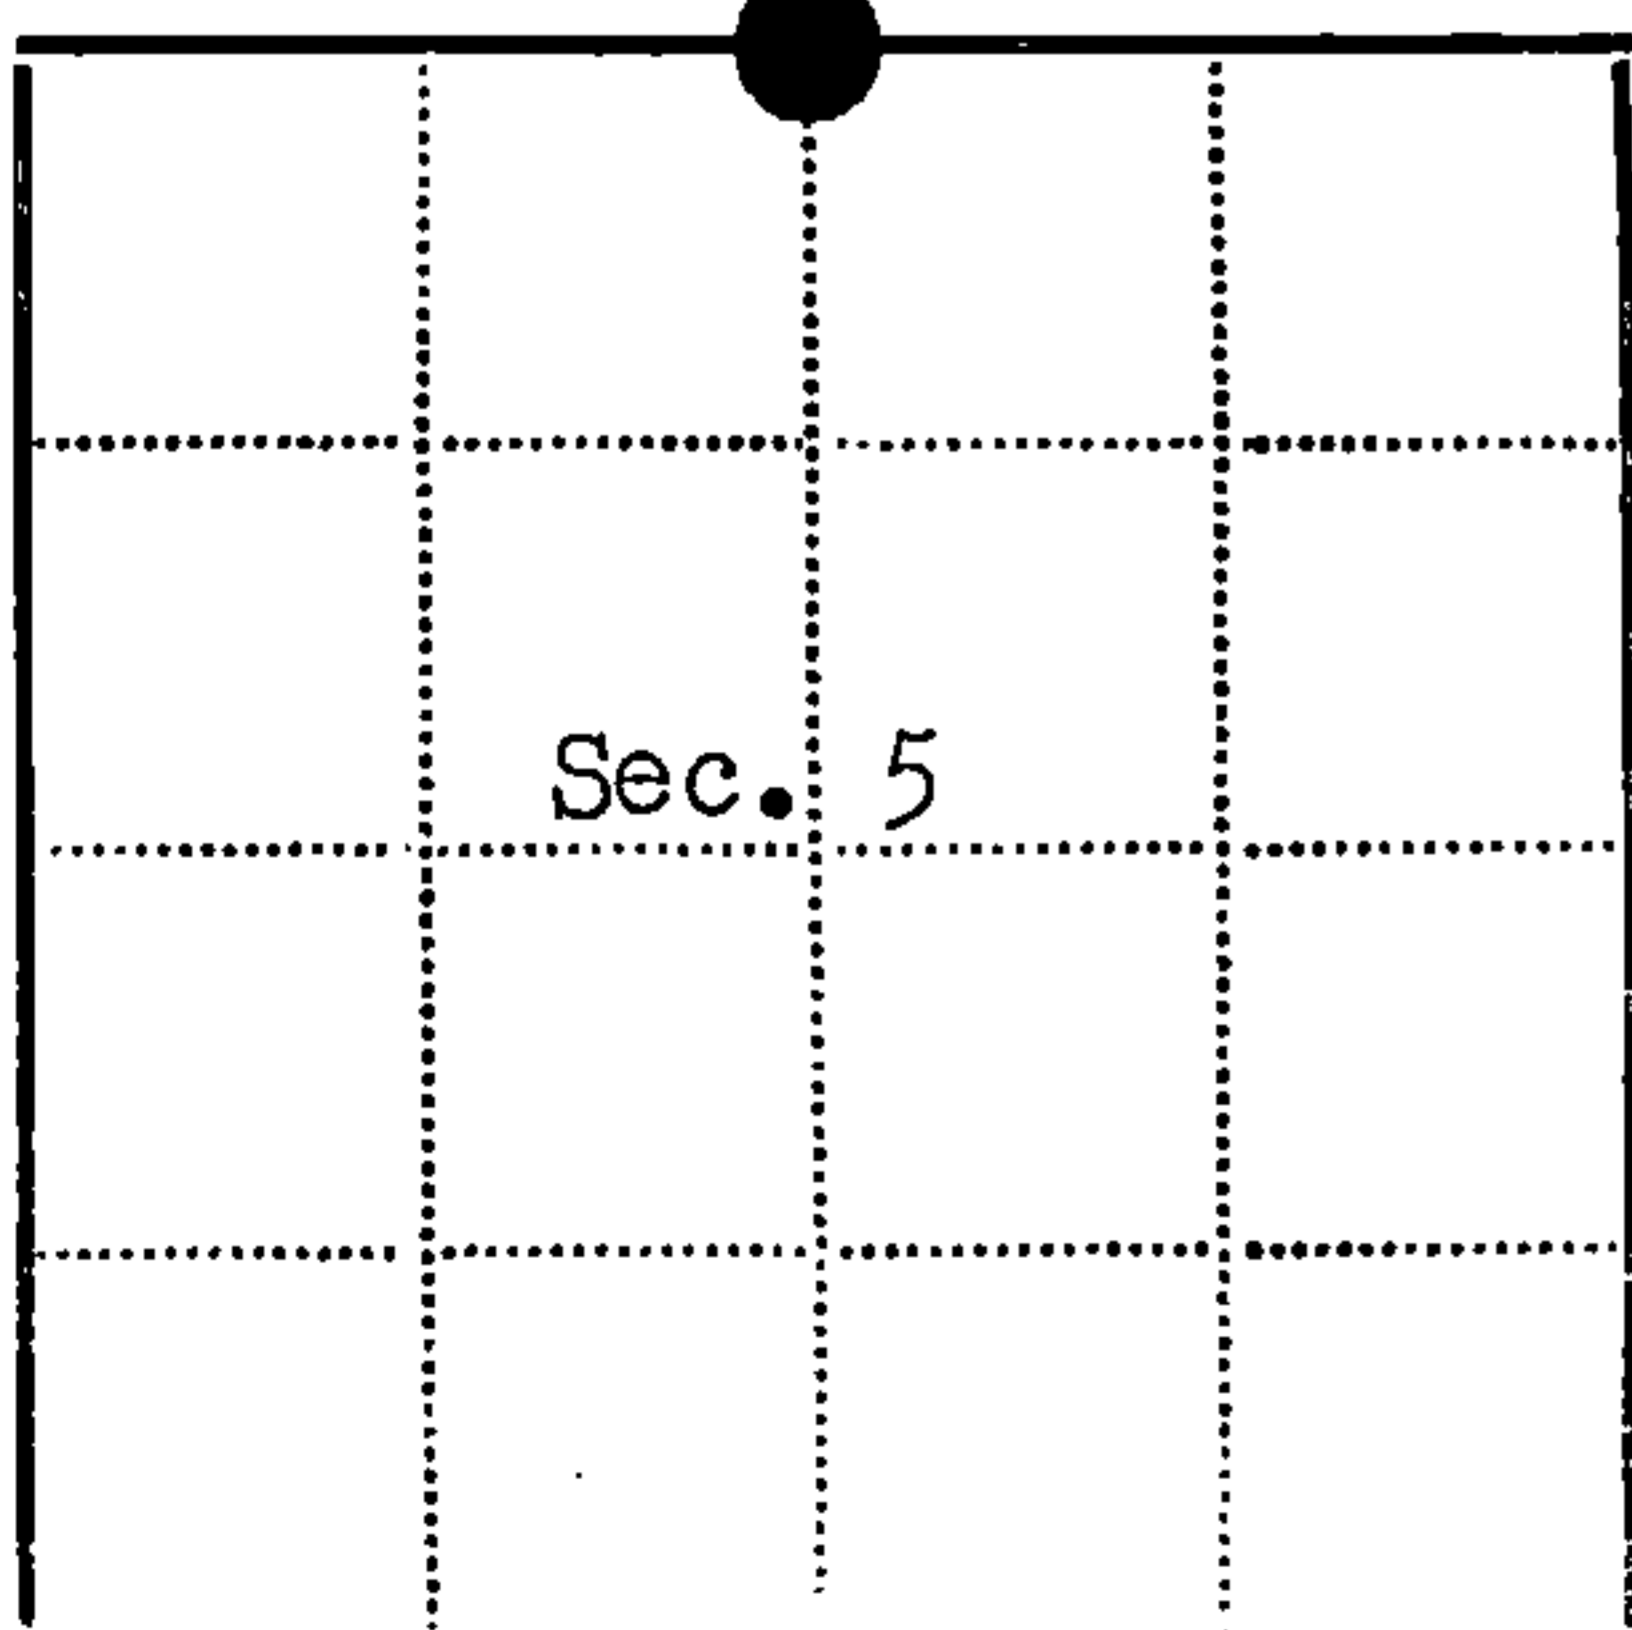

● - Corner monument restored
 □ -

Resident witnesses.....

Dated at Laona Wisconsin, this 26 day of May 1981.

Signature *Milo E. Stefan* Title Land Surveyor
 (County Surveyor, Registered Land Surveyor, or other duly authorized official)

Surveyors Registration No. S-1558

Office of Register of deeds County of Forest

I hereby certify that the within instrument was filed in this office for record on the 2nd day of June 1981, and was filed in Book No. Page No. of County Records.

Signature *Eugene Stately* Title Register of Deeds

Township 36 North, Range 15 East, Section 5, Index No. A-7, Page No.