


U. S. PUBLIC LAND SURVEY MONUMENT RECORD

INSTRUCTIONS:

This record shall show the location of the corner and shall include all of the following nine elements (a through i).

- (a) Identify the corner by reference to the U.S. public land survey system.
 O = Corner monument restored.

Quarter Corner Common to Sections 2 and 3,
 Township 37 North, Range 16 East, Forest County,
 State of Wisconsin.

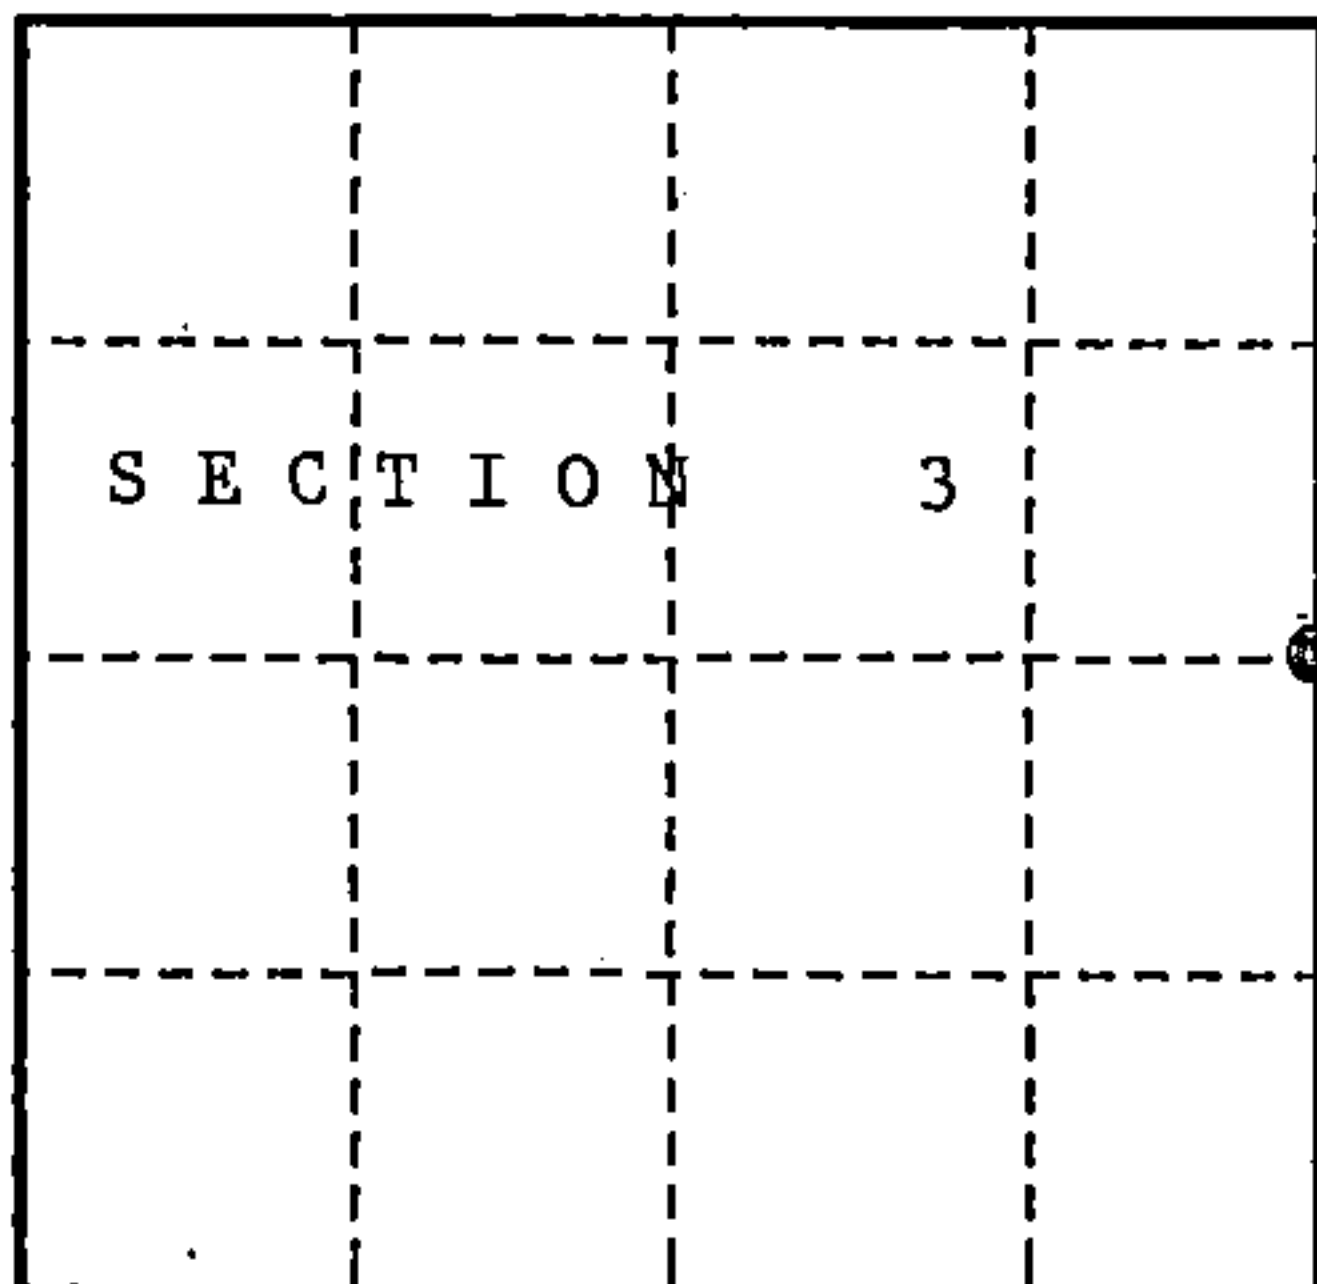

- (b) Describe any record evidence, monument evidence, occupational evidence, testimonial evidence or any other material evidence you considered, and whether the monument was found or placed.

In 1859, James McBride set a wooden post at the corner and with the following bearing trees:
 Sugar 10" S84°E, 26 lks. Sugar 12" S86°W, 42 lks.

In 1982, Kim Pritzlaff established the corner and set 2" dia. driveable aluminum Berntsen monument stamped to identify the corner. The following corner references:

Maple	8"	S22°E	17.48 ft.
Maple	6"	N61°E	5.88 ft.
Steel post		S30°E	1.2 ft.

In 1990, John Schulke recovered monument in place and flush to the ground. Also, recovered the following corner references:

Red Maple	7"	N76°E	5.87 ft.
Red Maple	9"	S15°E	17.47 ft.
Steel sign post		SE	1.2 ft.

The following new corner reference:


Red Maple 5" N69°W 48.62 ft.

Center line of a two track is West 30 ft. of the monument.

- (c) In the plan view drawing below, provide reference ties to at least 4 witness monuments, or, if the location is within a municipality, to at least 2 witness monuments. (witness monuments shall be made of concrete, natural stone, iron or other equally durable material.)

- (d) Show a plan view drawing depicting the relevant monuments and reference ties which is sufficient in detail to enable accurate relocation of the corner monument if the corner monument is disturbed. Indicate north.

- 2" dia. aluminum monument stamped to identify the corner.
- Red Maple 7" N76°E 5.87 ft.
- Red Maple 9" S15°E 17.47 ft.
- Red Maple 5" N69°W 48.62 ft.
- Steel sign post SE 1.2 ft.

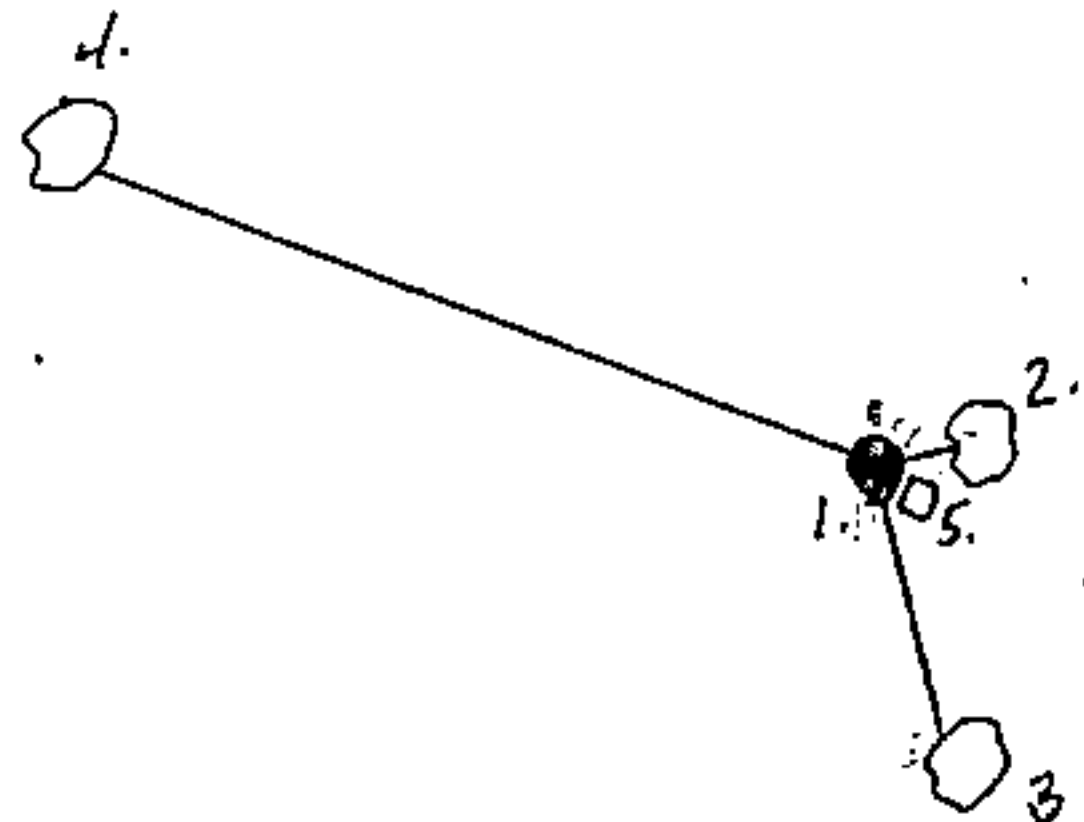

REGISTER'S OFFICE }
 Forest County, Wis. }

Received for record this 19th day
 of December A.D., 1990 at
8:45 o'clock A.M. and recorded
 in Vol. Corner Restorations

page C-17

Paul Hachen
 Register of Deeds

43716032000

(e) Describe any material discrepancy between the location of the corner as restored or reestablished and the location of that corner as previously restored or reestablished by distance and direction. Show the discrepancy on the plan view drawing under (d), above. Show the distances between the corner as previously restored or reestablished and (1) the corner as restored or reestablished, and (2) to at least 2 of the witness monuments shown on the drawing in (d), above.


NONE.

(f) Was the corner restored through acceptance of (1) an obliterated evidence location, or, (2) a found perpetuated location?

(2) found perpetuated location.

(g & h) Was the corner reestablished through lost corner proportionate methods? If so, show the method, including the directions and distances to other public land survey corners used as evidence or used for proportioning in determining the corner location?

NO.

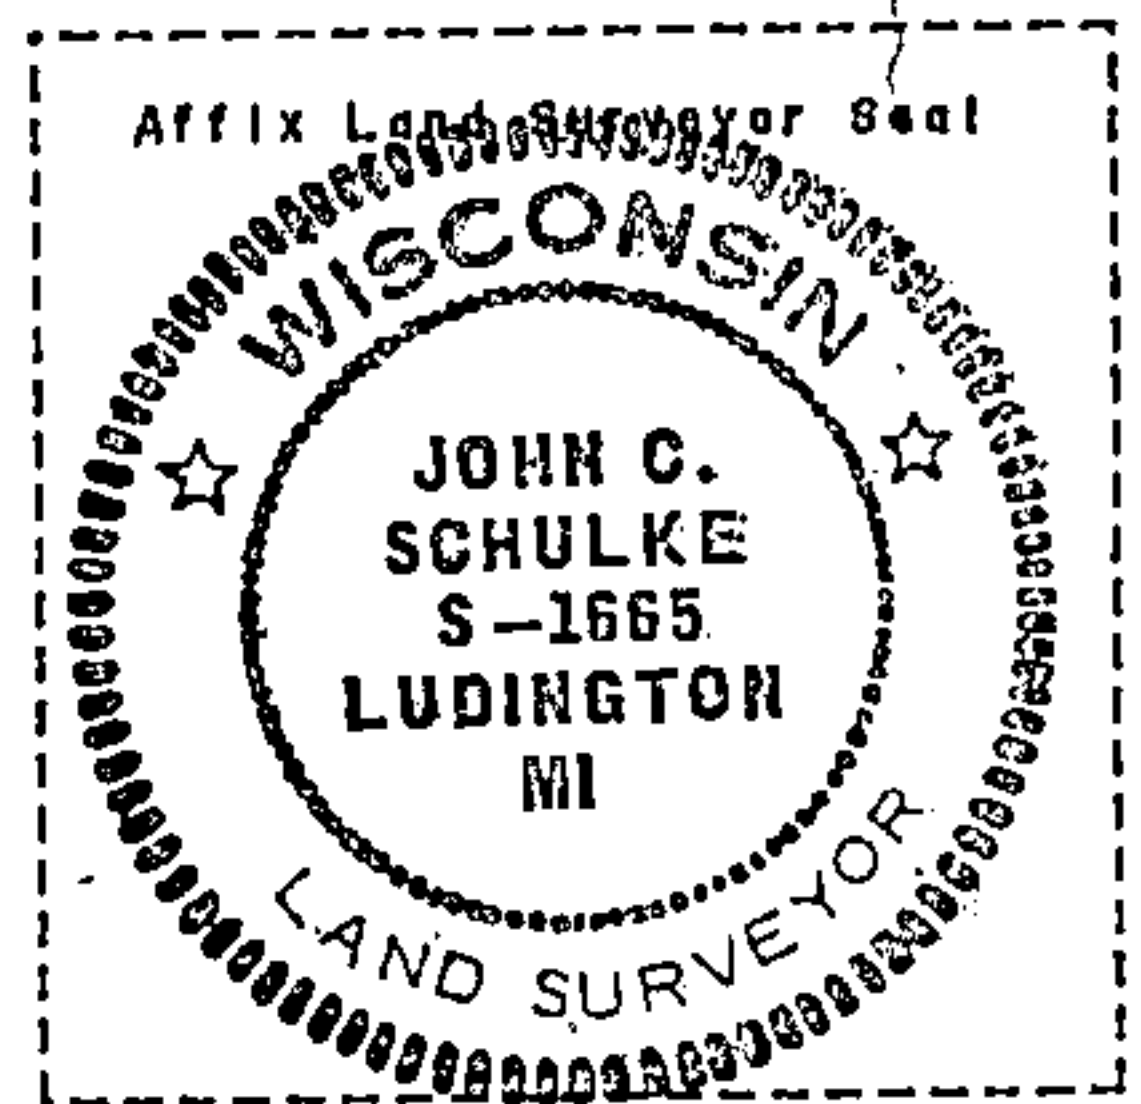

(1) I, John Schulke a Register Land Surveyor
(type or print name) certify that the corner location shown on this record was determined by me or under my direction and control and that this U.S. Public Land Survey Monument Record is correct and complete to the best of my knowledge and belief.

John Schulke
Signature

10/23/90
Date

CERTIFICATE READY FOR FILING:

Paul B. Haeger
District Ranger