

CERTIFIED LAND CORNER RESTORATION


Index No. **G 21**

State of Wisconsin }
County of Forest } ss.

I Thomas R. Arnott, do hereby certify that on the 21st day of June, 1976, I found evidence of the 1/4 corner of sections 11 & 12 Township 37, North, Range 16 E, Fourth Principal Meridian, as described hereon; and that from this evidence I established a new monument and accessories as described hereon to perpetuate the original location of this corner.

Resident witnesses:

.....
.....
.....

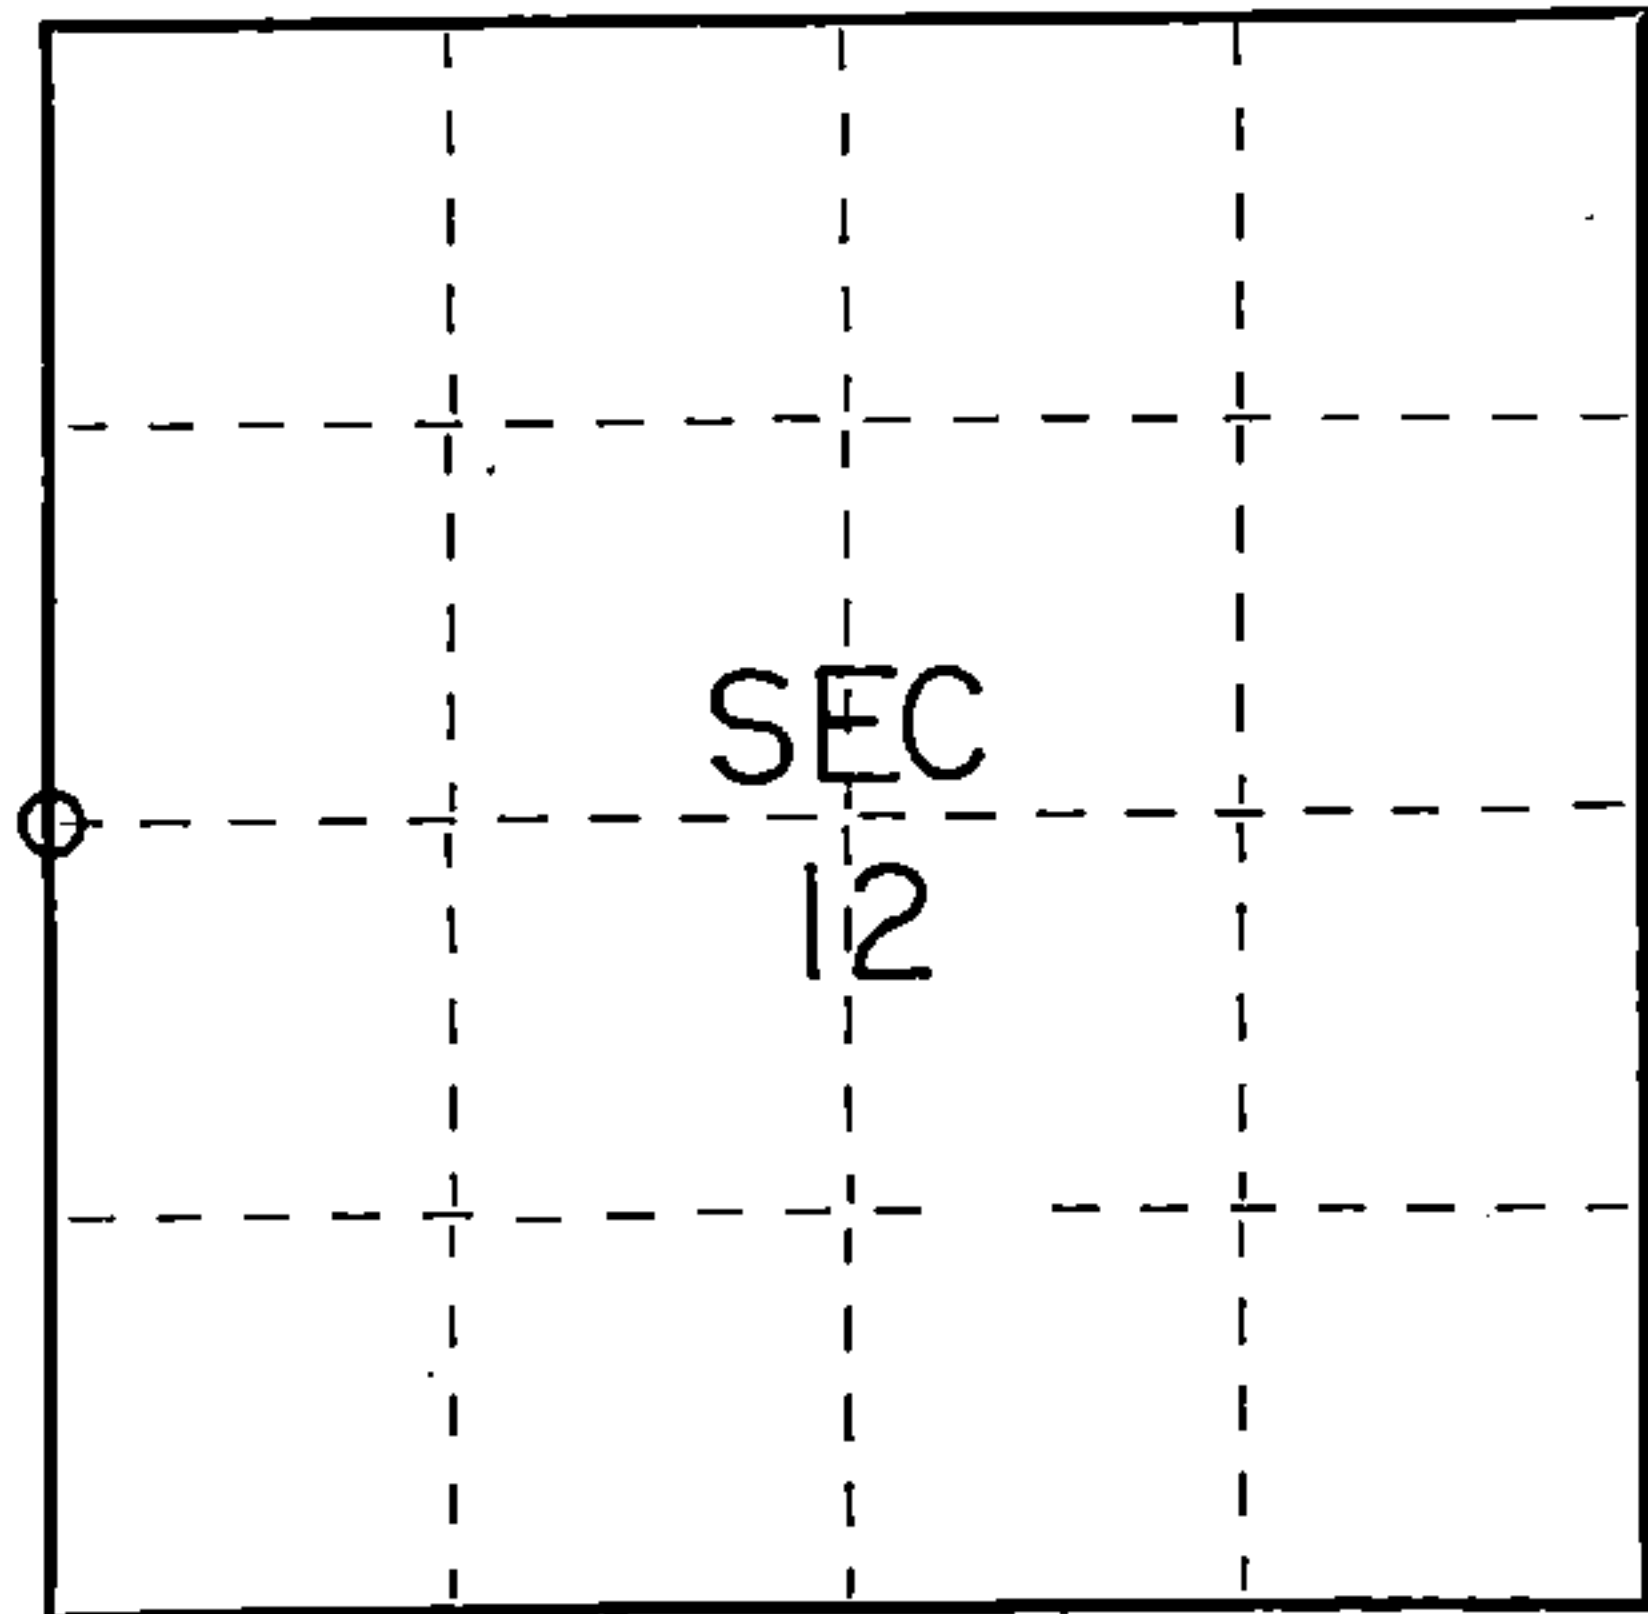

○ = Corner monument restored.

History of original corner establishment:

Original subdivision by James McBride 11 July - 16 July, 1859

Hemlock 16 S72W 42 lks.
Hemlock 8 S69E 17 lks.

Description of corner evidence found:

3/4" iron pipe found 8" below road bed

Description of monument and accessories I established to perpetuate the original location of this corner.

Left 3/4" iron pipe set new 1 1/2" iron pipe over 3/4" iron pipe 6" below road

Ties:

Forest County aluminum monument N60E 21.19 feet
W. Birch 8 S19E 54.00 feet



43716112000

Dated at Grandon, Wis., this 23rd day of June, 1976

Signature Thomas R. Arnott Title Surveyor Registration No S-887
(County Surveyor, Registered Land Surveyor, or other duly authorized official)

Office of Register of Deeds, County of Forest, I hereby certify that the within instrument was filed in this office for record on the 23rd day of June, 1976 at 3 o'clock P. M.

Eugene Stutzman (Register of Deeds) Document Number **109510**

By..... Deputy

FORM 985 H. C. MILLER CO., MILWAUKEE