

CERTIFIED LAND CORNER RESTORATION


Index No. **N25**

State of Wisconsin }
County of Forest } ss.

I Thomas R. Arnott, do hereby certify that on the 21st day of June, 1976; I found evidence of the section corner of Sections 13, 18, 19 & 24 Township 37, North, Range 16-17 E, Fourth Principal Meridian, as described hereon; and that from this evidence I established a new monument and accessories as described hereon to perpetuate the original location of this corner.

Resident witnesses:

.....
.....
.....

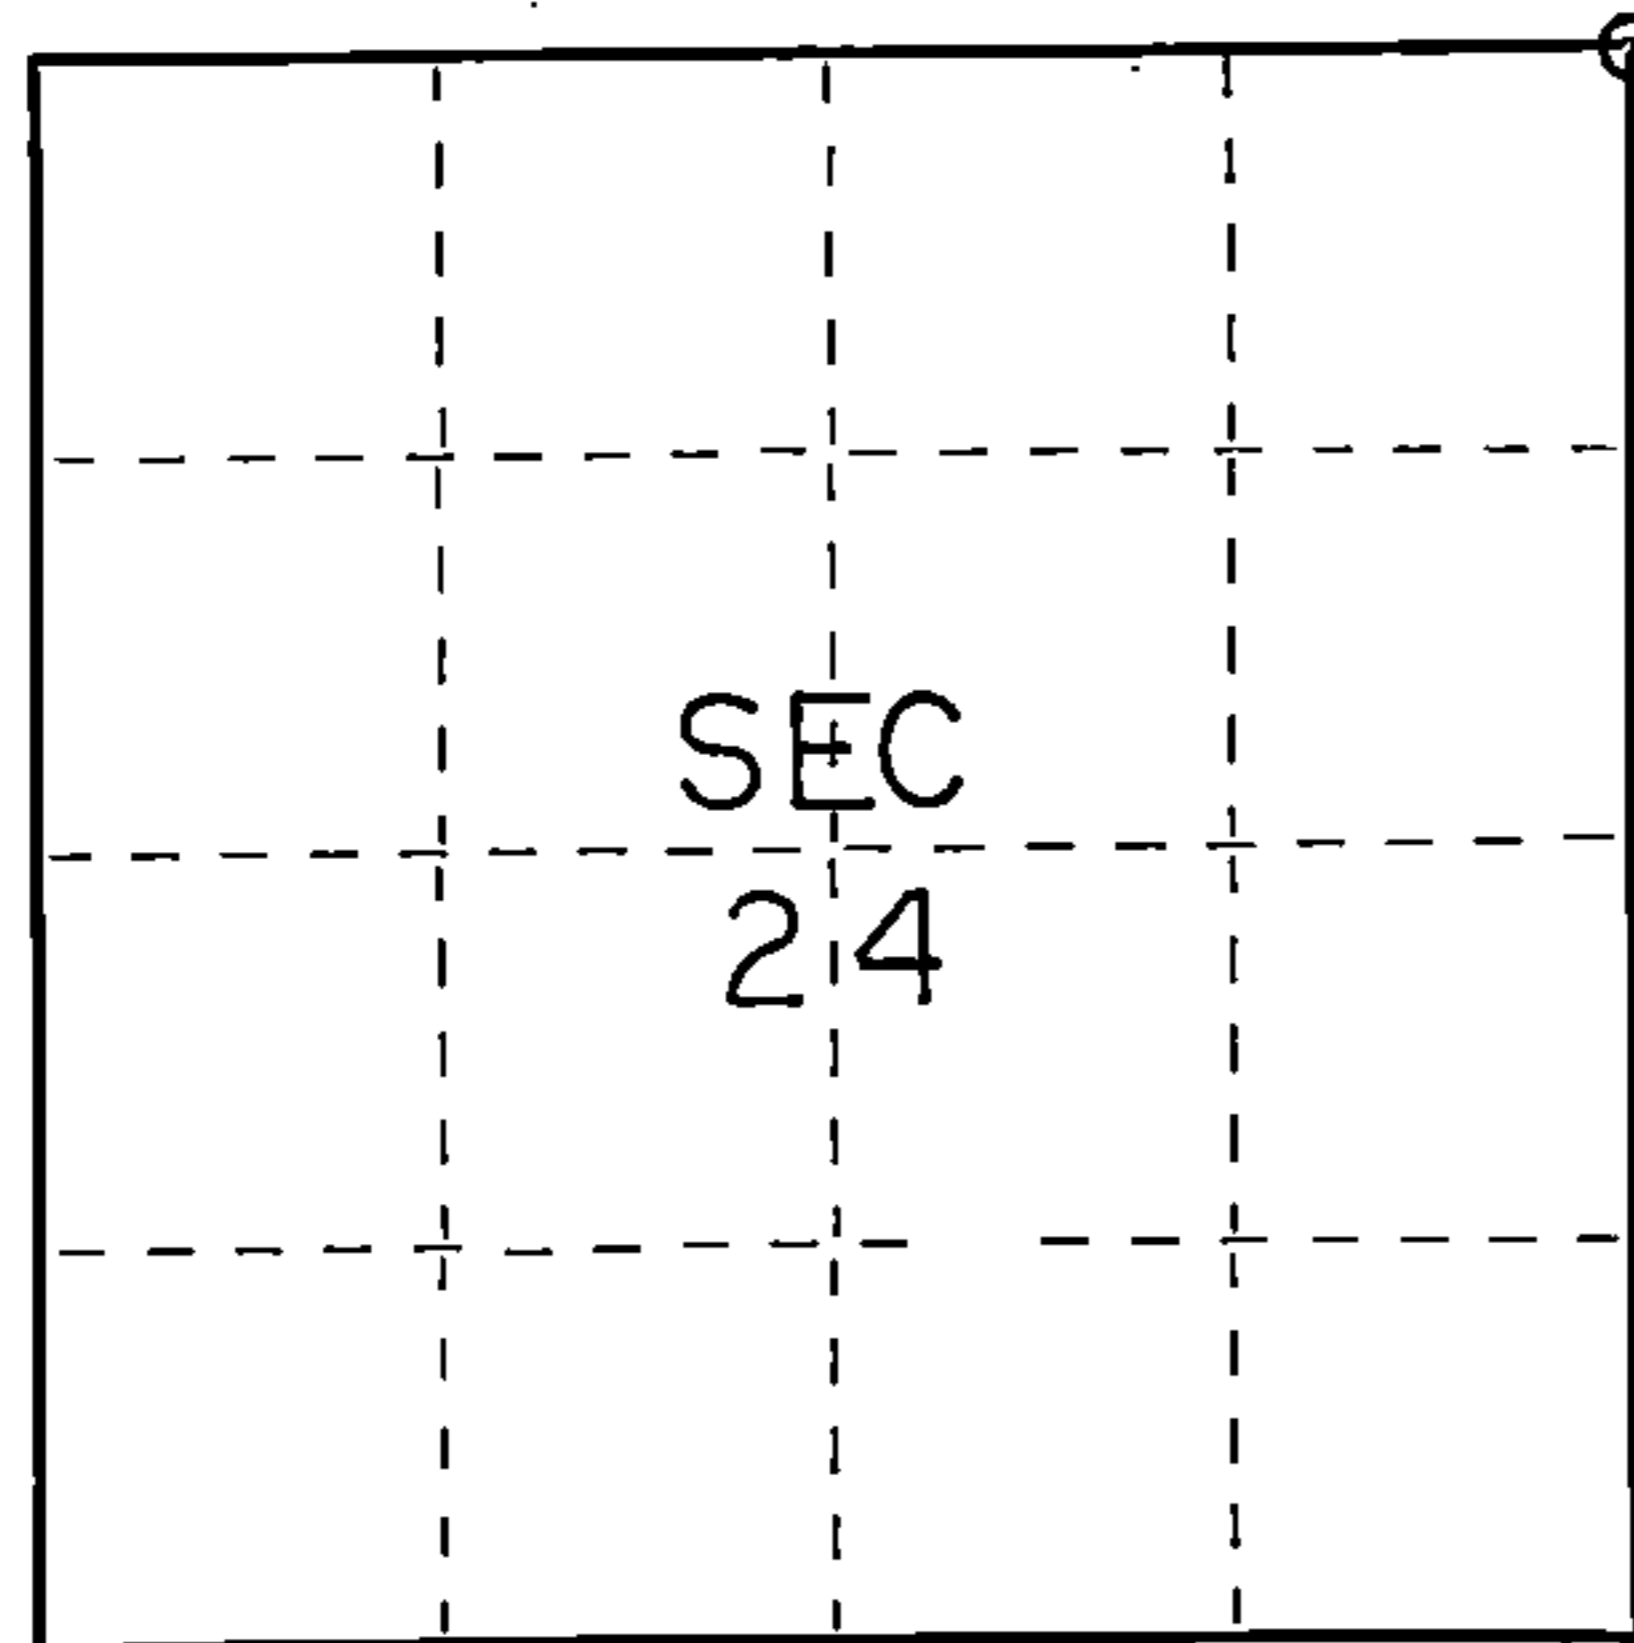

○ = Corner monument restored.

History of original corner establishment:

Original line by Astemus Curtis 1857

Sugar 14 S65W 39 Lks.
Sugar 10 N27W 30 Lks.
Sugar 18 N68E 42 Lks.
Lynn 12 S64E 23 Lks.

Description of corner evidence found:

Found $1\frac{1}{4}$ " iron pipe in road

Description of monument and accessories I established to perpetuate the original location of this corner.

Left $1\frac{1}{4}$ " iron pipe

Ties:

Forest County aluminum monument S59W 34.22 feet.
Power pole (3716 13R16) N66W 32.52 feet.
guy pole (3716 25W7) N52E 26.98 feet.

Dated at Grandon, Wis., this 23rd day of June, 1976.

Signature Thomas Arnott Title Surveyor Registration No. S-887
(County Surveyor, Registered Land Surveyor, or other duly authorized official)

Office of Register of Deeds, County of Forest, I hereby certify that the within instrument was filed in this office for record on the 23rd day of June, 1976 at 3 o'clock P.M.

Eugene Staszny Document Number **109512**
(Register of Deeds)

By _____ Deputy



43716130000

FORM 985 R. C. MILLER CO., MILWAUKEE