

CERTIFIED LAND CORNER RESTORATION

Index No. N 9 9

State of Wisconsin }
County of Forest } ss.

History of original corner establishment:

Original survey done by James McBride July 11 - July 16, 1859.

| | | | |
|-------|----|------|---------|
| Cedar | 12 | N75W | 10 Lks. |
| Cedar | 10 | N49E | 30 Lks. |
| Cedar | 10 | S70E | 32 Lks. |
| Cedar | 8 | S37W | 18 Lks. |

Description of corner evidence found:

2' wood post points found. 3 of the 4 bearing tree stumps found.

Description of monument and accessories I established to perpetuate the original location of this corner.

Replaced wood post points with Forest Co. Aluminum monument.

Ties:


| | | | |
|-------|----|------|------------|
| Cedar | 8 | N44E | 17.04 feet |
| Cedar | 8 | S15E | 18.42 feet |
| Cedar | 10 | S49W | 22.56 feet |

I Thomas R. Arnott, do hereby certify that on the 22 day of Oct., 1976, I found evidence of the section corner of sec. 16, 17, 20 & 21 Township 37, North, Range 16 E, Fourth Principal Meridian, as described hereon; and that from this evidence I established a new monument and accessories as described hereon to perpetuate the original location of this corner.

Resident witnesses:

.....
.....
.....

FORM 985 H. C. MILLER CO., MILWAUKEE

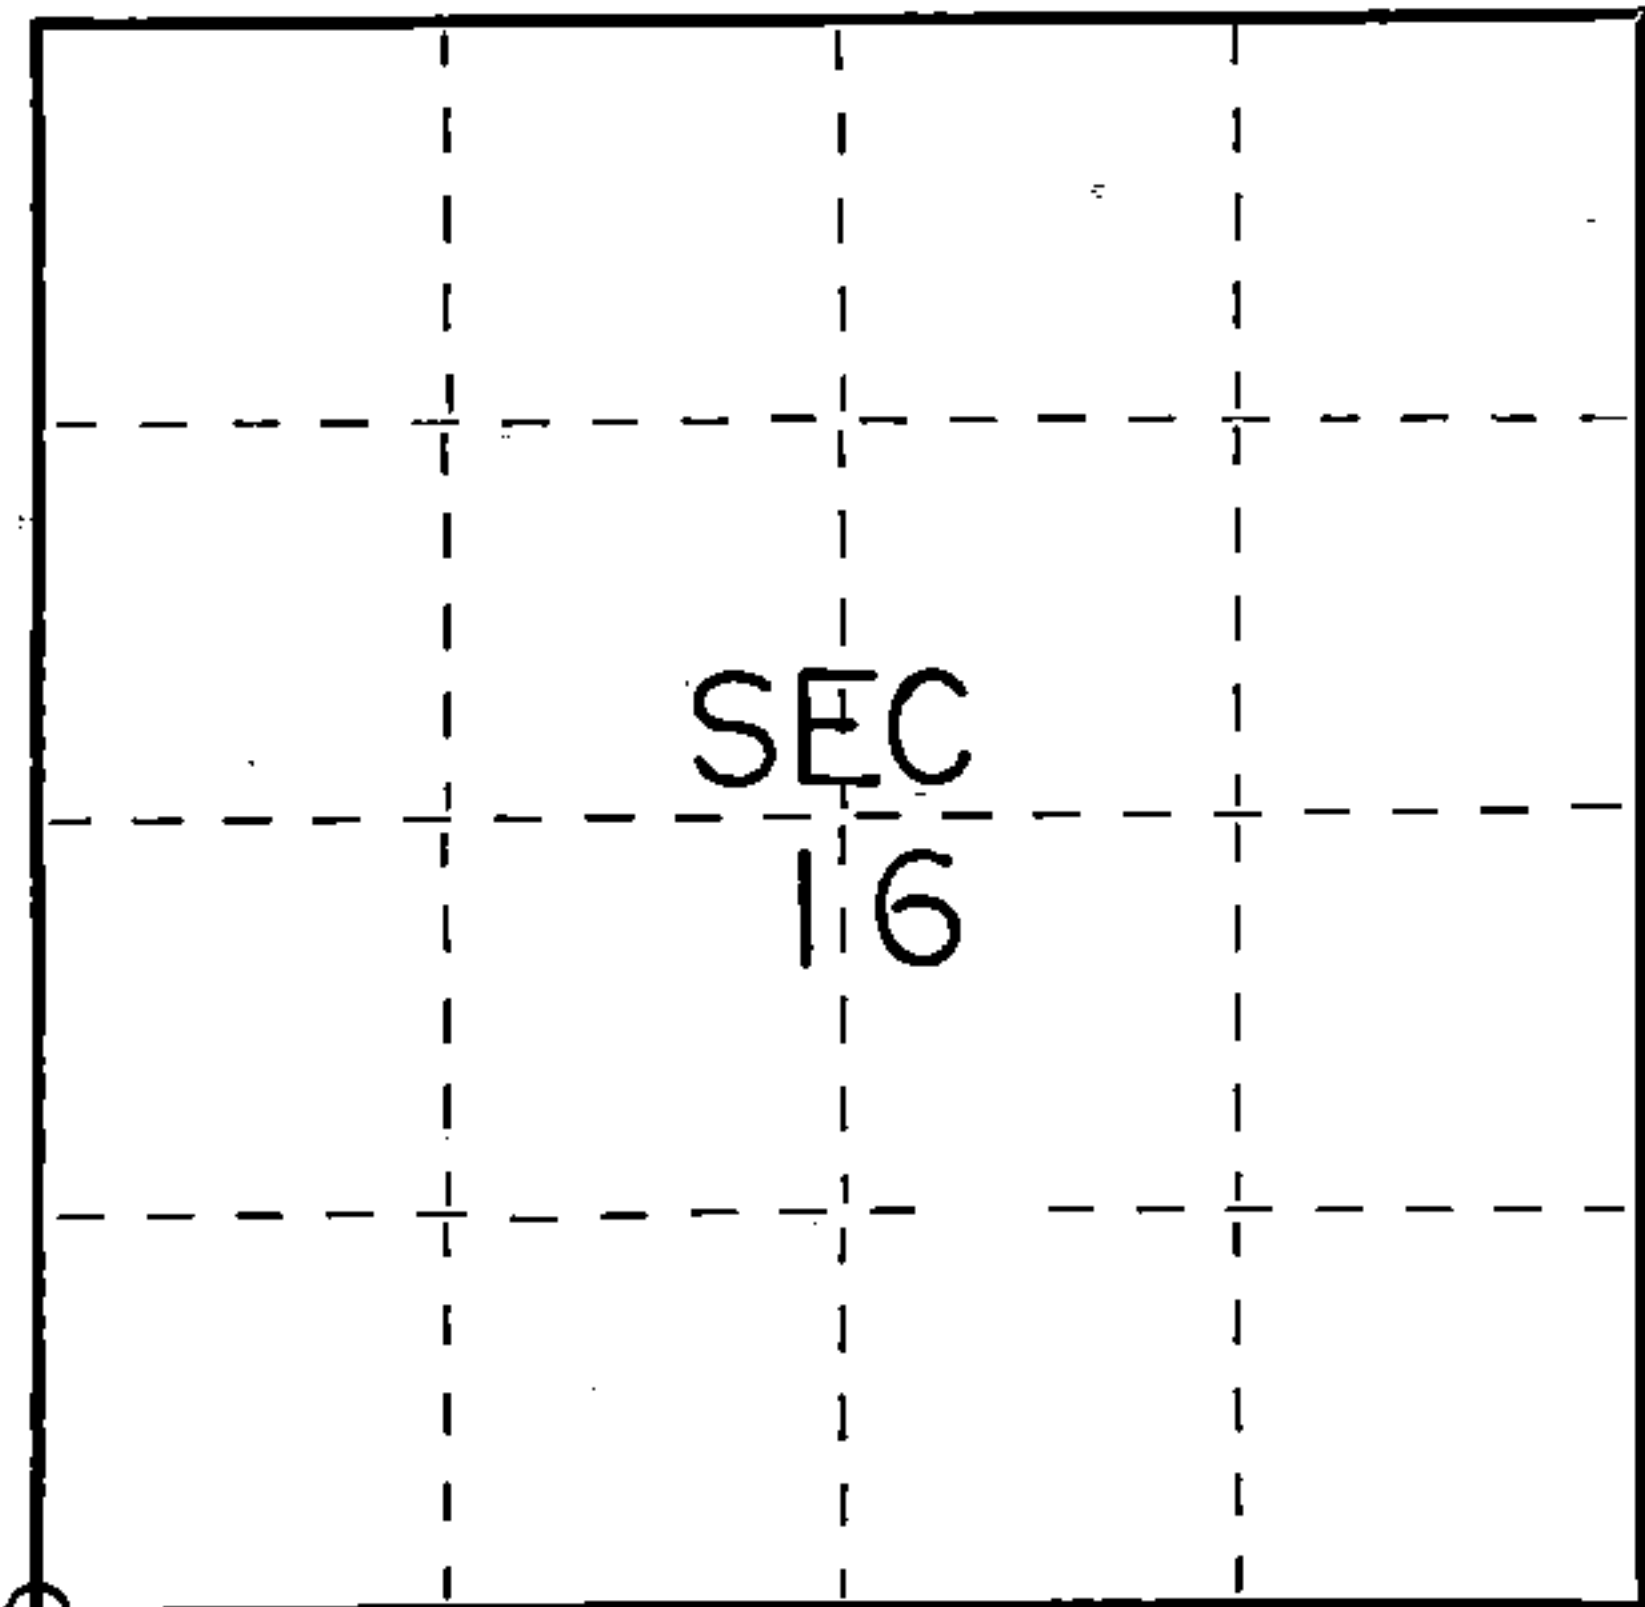

○ = Corner monument restored.


Dated at Grandon, Wis., this 26 day of Nov., 1976.

Signature Thomas R. Arnott Title Surveyor Registration No. S-887
(County Surveyor, Registered Land Surveyor, or other duly authorized official)

Office of Register of Deeds, County of Forest, I hereby certify that the within instrument was filed in this office for record on the 26 day of Nov., 1976 at 3:30 o'clock P. M.

EUGENE STATEZNY Document Number 110613
(Register of Deeds)

By Eileen Schmidt Deputy

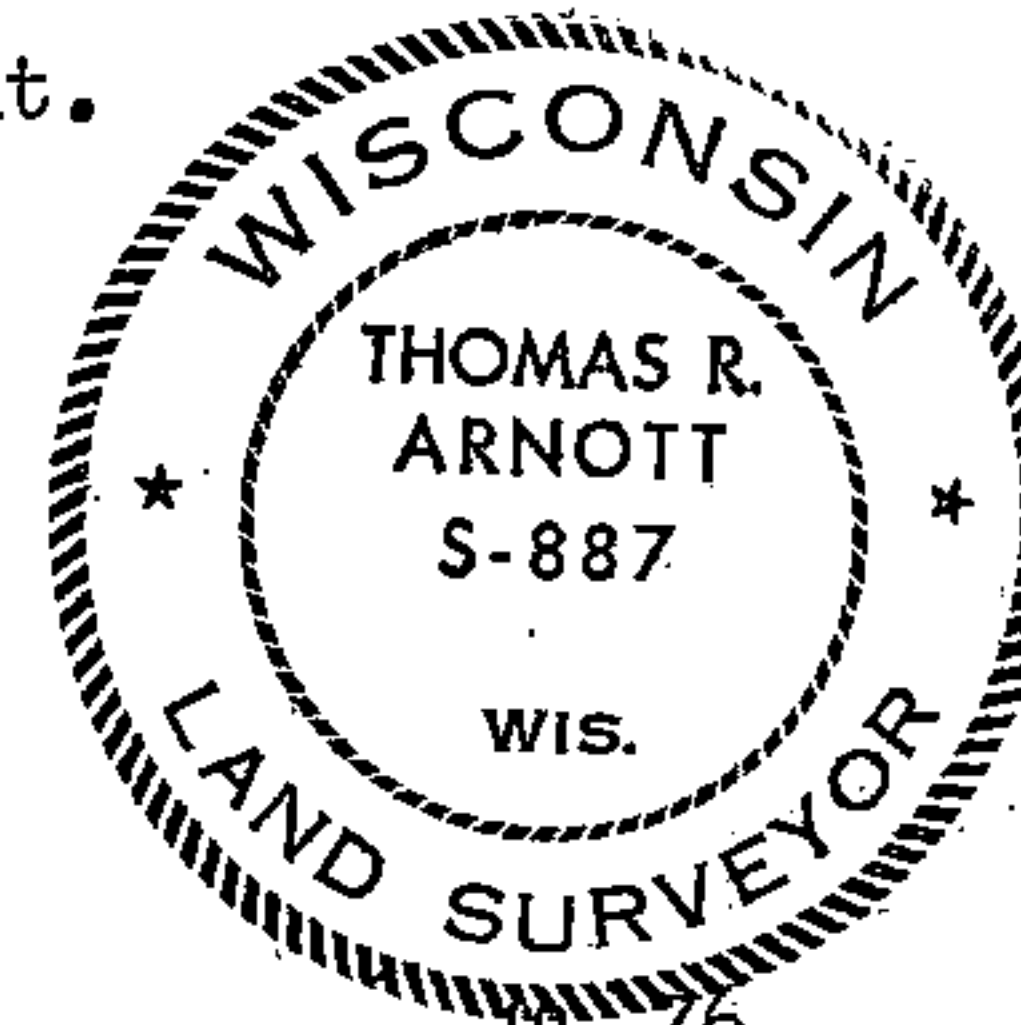

437161700000