

CERTIFIED LAND CORNER RESTORATION


Index No. P17

State of Wisconsin }
County of Forest } ss.

I Thomas R. Arnott, do hereby certify that on the 21 day of Oct., 1976, I found evidence of the 1/4 corner of sec. 22 & 23 Township 37, North, Range 16 E, Fourth Principal Meridian, as described hereon; and that from this evidence I established a new monument and accessories as described hereon to perpetuate the original location of this corner.

Resident witnesses:

.....
.....
.....

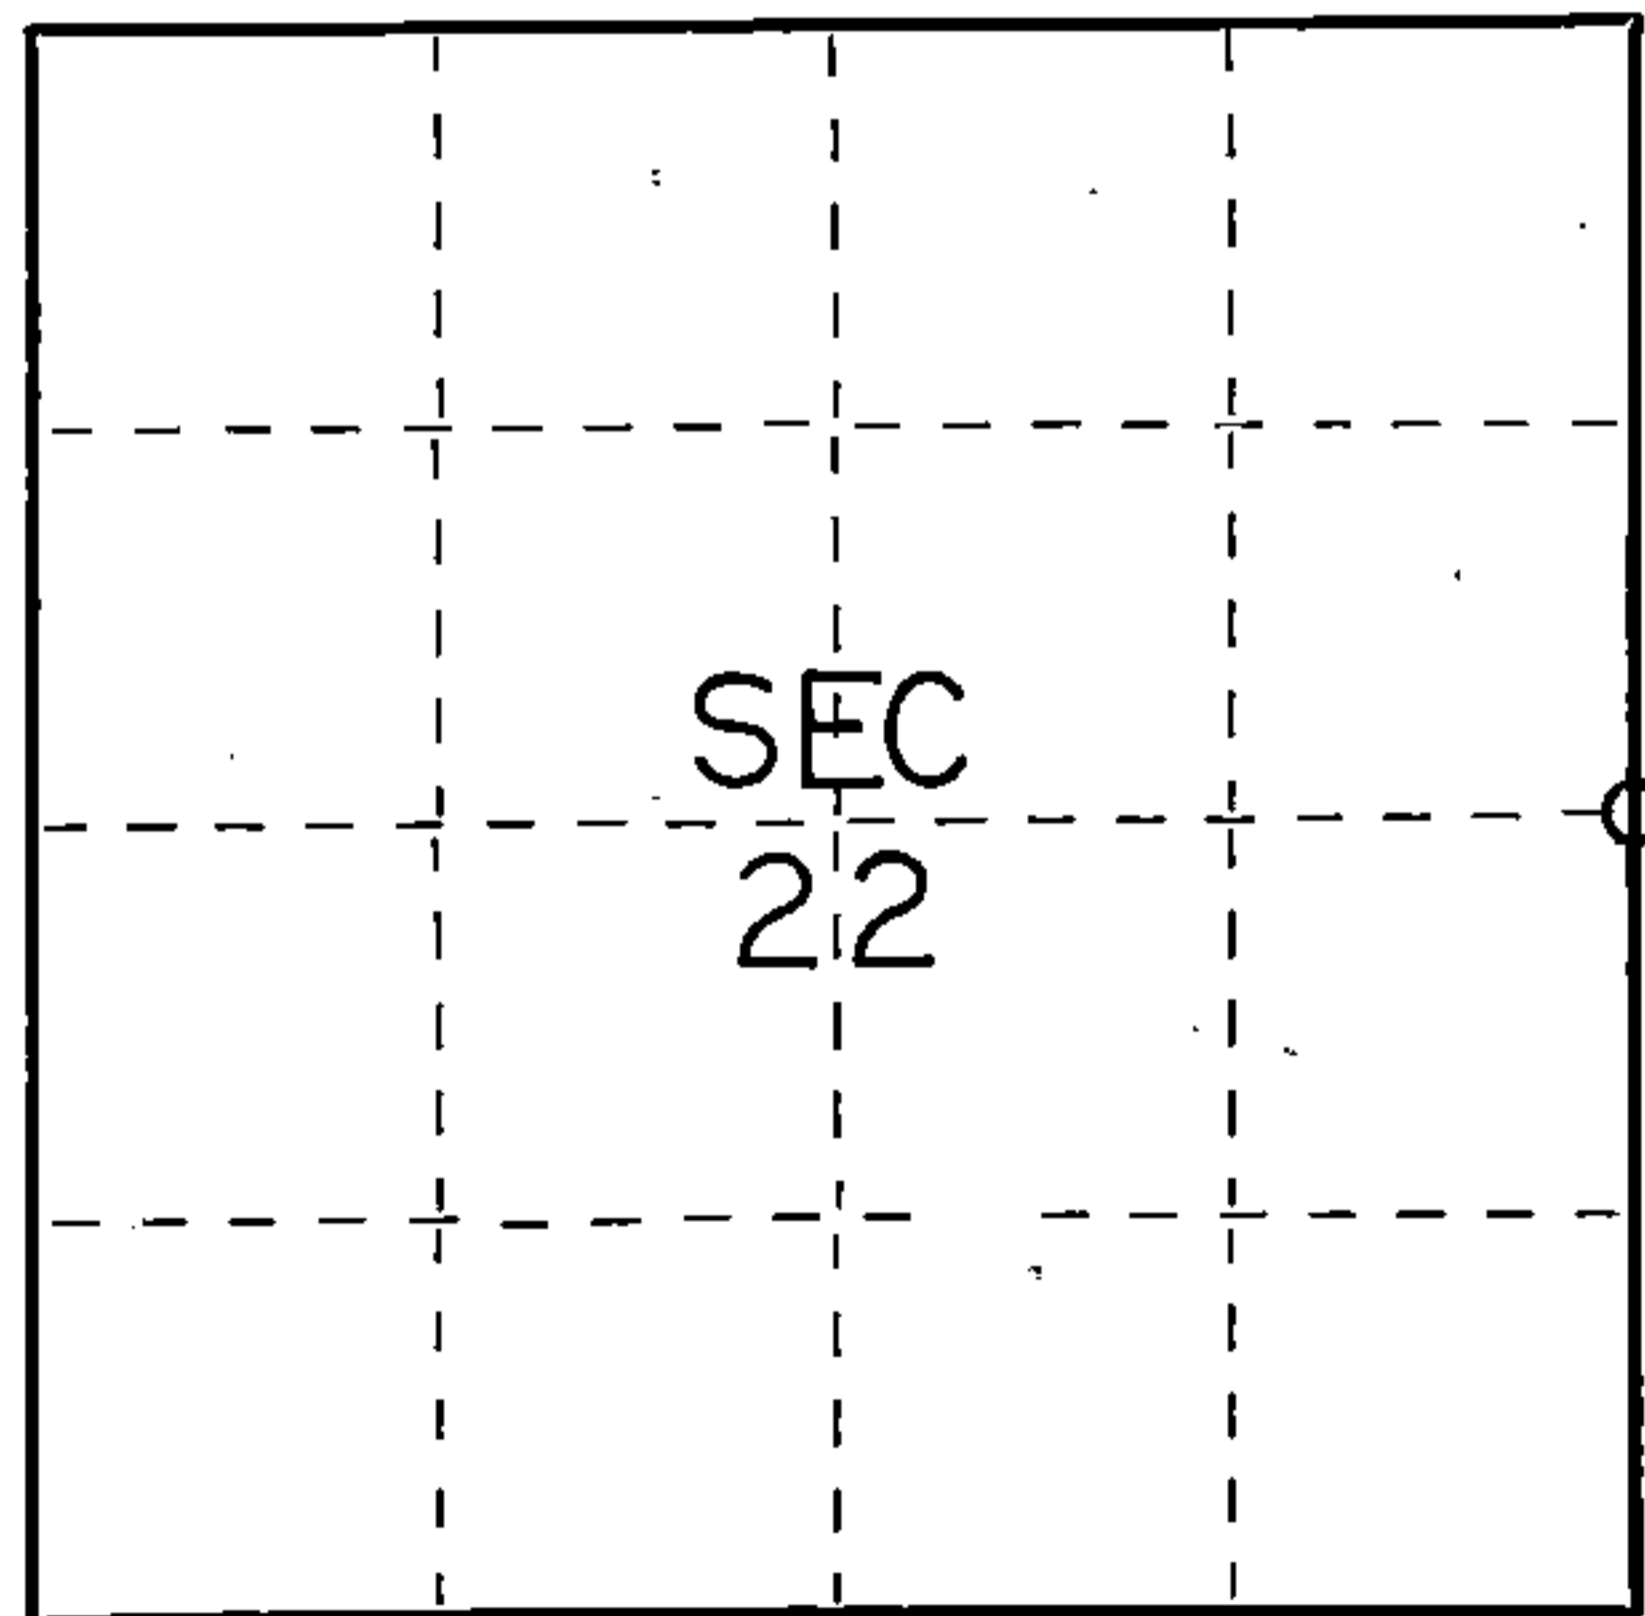

○ = Corner monument restored.

History of original corner establishment:

Original survey done by James McBride July 11 - July 16, 1859

Hemlock 10 N74E 17 Lks.
Hemlock 12 N73W 10 Lks.

Description of corner evidence found:

Old wood post found by Louis Witkowski. Corner fence post was set at location of old wood post.

Description of monument and accessories I established to perpetuate the original location of this corner.

Set Forest Co. Aluminum monument as reference monument .6 feet north of fence post.

Ties: to ref. Mon.

Maple 5 N15E 30.38 Feet
W. Birch 8 West 43.63 feet

Dated at Crandon, Wis., this 26 day of Nov., 1976

Signature Thomas Arnott Title Surveyor Registration No. S-887
(County Surveyor, Registered Land Surveyor, or other duly authorized official)

Office of Register of Deeds, County of Forest, I hereby certify that the within instrument was filed in this office for record on the 26 day of Nov., 1976 at 3:30 clock P. M.

EUGENE STATEZNY
(Register of Deeds)

Document Number 110617

By Eileen Schmidt Deputy

FORM 985 H. C. MILLER CO., MILWAUKEE

43716222000

