

CERTIFIED LAND CORNER RESTORATION


Index No. V 21

State of Wisconsin }
County of FOREST } ss.

I NORMAN A. HARRISON, do hereby certify that on the Twenty-eighth day of June, 1980, I found evidence of the North west corner of Sec. 36 Township 37, North, Range 16 East, Fourth Principal Meridian, as described hereon; and that from this evidence I established a new monument and accessories as described hereon to perpetuate the original location of this corner.

Resident witnesses:

FORM 985 H. G. MILLER CO., MILWAUKEE

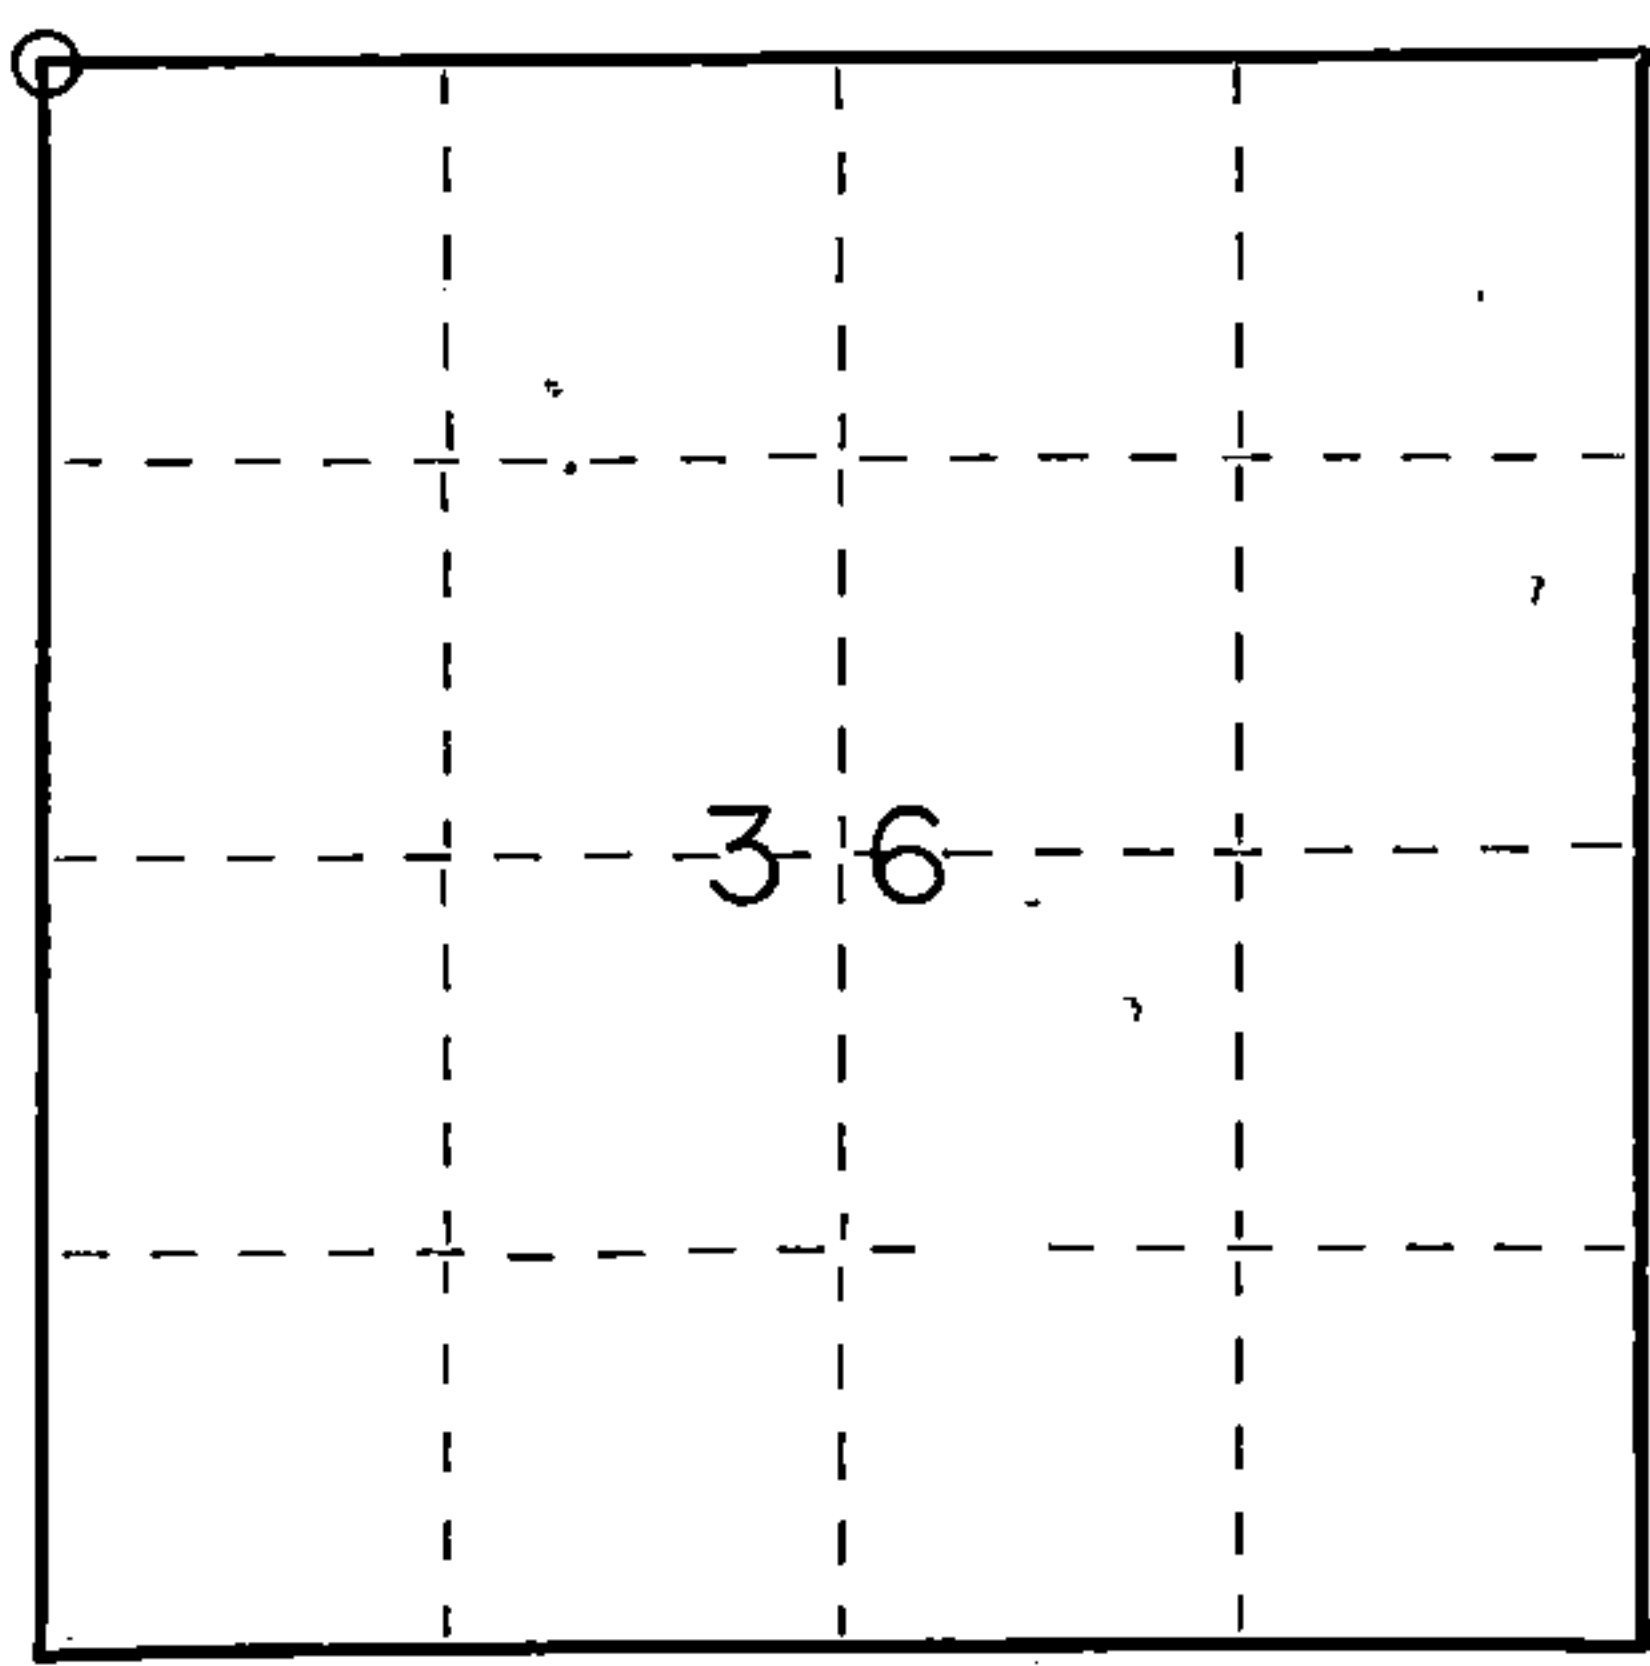

○ = Corner monument restored.

History of original corner establishment:
Original survey by James McBride
July 11- July 16, 1859

Lind	10	N 34 W	28 Lks
Birch	18	N 24 E	25 Lks
Hemlock	16	S 55 E	26 Lks
Birch	16	S 52 W	10 Lks

Description of corner evidence found:

No original corner evidence found. Accepted road intersection as best evidence of corner perpetuation.

See sheet 2

Description of monument and accessories I established to perpetuate the original location of this corner.

- Set 1 1/2" iron pipe in intersection at corner.
- Set Forest County aluminum monument as witness monument, S 89° 45' E, 33.00 feet
- Near edge of power pole, N 28° 57' W, 52.30'
- N.E. Corner of telephone riser, N 64° 05' W, 68.50'
- B.T., center of most easterly maple tree in clump of three 9" maple trees.
- S 42° 20' W, 75.3'. Tree blazed

Dated at Fence, Wis., this 25 day of Nov., 1980.

Signature Norman A. Harrison Title Surveyor Registration No. 1394
(County Surveyor, Registered Land Surveyor, or other duly authorized official)

Office of Register of Deeds, County of Forest, I hereby certify that the within instrument was filed in this office for record on the 25th day of November, 1980 at 3:30 o'clock P. M.

EUGENE STATEZNY
(Register of Deeds)

DOCUMENT NO. **119055**

By Sharon Mueller Deputy

43716260000