

DOCUMENT NUMBER  
143940


FORM 985 H. C. MILLER CO., MILWAUKEE

State of Wisconsin }  
A County of Forest } ss.

I, Norman A. Harrison, do hereby certify that on the 22 day of October, 1991, I found evidence of the Northeast corner of Sec. 34 Township 37 North, Range 16 East, Fourth Principal Meridian, as described hereon; and that from this evidence I established a new monument and accessories as described hereon to perpetuate the original location of this corner.

Resident witnesses:

.....  
.....  
.....

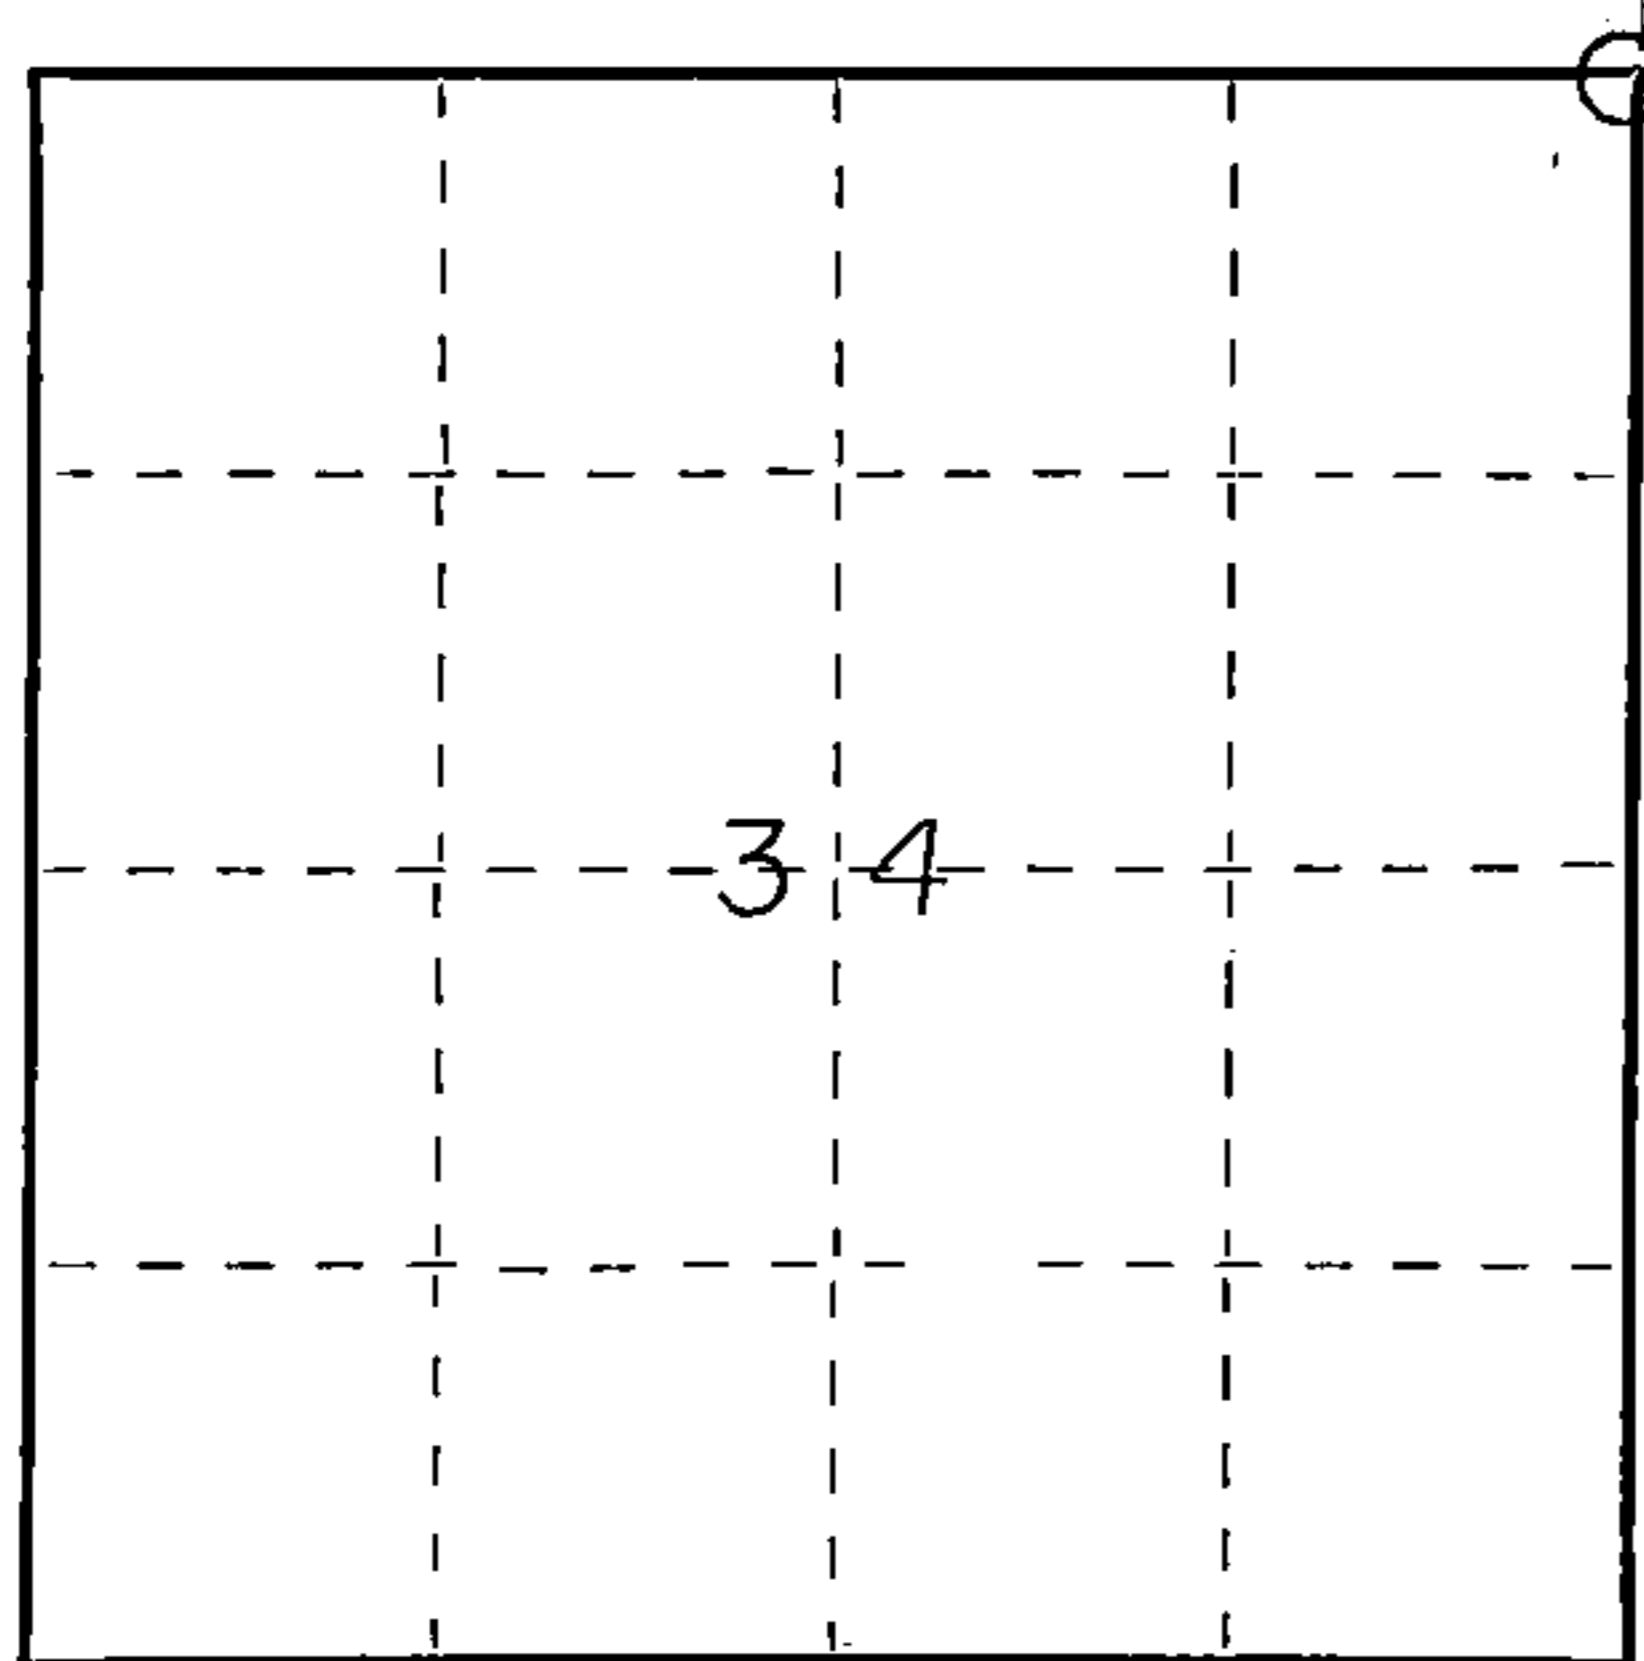

○ = Corner monument restored.

43716270000

CERTIFIED LAND CORNER RESTORATION

U.S. PUBLIC LAND SURVEY MONUMENT RECORD

History of original corner establishment:  
Original survey by: James McBride

Commenced July 11, 1859

Finished July 16, 1859

original bearing trees

yellow pine	24	N 74 W	30	( 19.8' )
hemlock	10	N 53 E	48	( 31.68' )
W. pine	24	S 33 E	14	( 9.24' )
W. pine	24	S 58 W	48	( 31.68' )

B Description of corner evidence found:  
Found 4" square wood post with scribing  
3/4" iron pipe along side wood post

F accepted wood post as best evidence of perpetuation  
of original corner location

Description of monument and accessories I established to perpetuate the original location of this corner:  
set Forest County aluminum monument along side of wood post and iron pipe

bearing trees:

spruce	4"	N 62° 55' E	44.25 feet
balsam	4"	S 30° 05' E	8.60 "
soft maple	6"	S 64° 08' W	30.25 "
soft maple	8"	N 87° 53' W	21.30 "

G,H corner was not set by proportionate methods

Dated at Fence, Wis., this Feb 10 day of Feb., 1992

Signature Norman A. Harrison Title Surveyor Registration No. 1394  
(County Surveyor, Registered Land Surveyor, or other duly authorized official)

Office of Register of Deeds, County of Forest, I hereby certify that the within instrument was filed in this office for record on the 5th day of March, 1992 at 3:30 o'clock P M.

Paul Aschenbrenner  
(Register of Deeds)

By: \_\_\_\_\_ Deputy

Index No. V-17

C,D,E

