

CERTIFIED LAND CORNER RESTORATION

State of Wisconsin }
County of Forest } ss.

I, Jean F. Resvick, do hereby certify that on the 14 day of March, 1974, I found evidence of the Southeast Section corner of Section 14 Township 38 north, Range 12 east, Fourth Principal Meridian, as described hereon; and that from this evidence I established a new monument and accessories as described hereon to perpetuate the original location of this corner:

Description of original monument and accessories and subsequent restorations:



Dependent Resurvey in 1937 by Wesson Cook
From original evidence found set a concrete monument, 24 ins. long, 6 ins. diam., 20 ins. in the ground for corner of sections 13, 14, 23, and 24 with a brass cap marked: T38N, R12E, S13, S14, S23, S24, 1937
From which: Spruce, 6" bears N27°E, 35 lks.
Spruce, 6" bears S25° 45'E, 32 lks.
Spruce, 6" bears S21° 45'W, 17 lks.
Spruce 6" bears N40°W, 16 lks.

Description of corner evidence found:

Concrete monument as described above and in place
Spruce stump, N27°E, 35 lks.
Spruce stump, S26°E, 32 lks.
Spruce stump, S22°W, 17 lks.
Spruce, 7", N40°W, 16 lks.

Description of monument and accessories I established to perpetuate the location of this corner:

Blazed and scribed the following new bearing trees
Spruce, 4", S88°E, 19.03 ft.
Spruce, 3", S39°E, 7.32 ft.
Set a steel sign post, north, alongside the monument

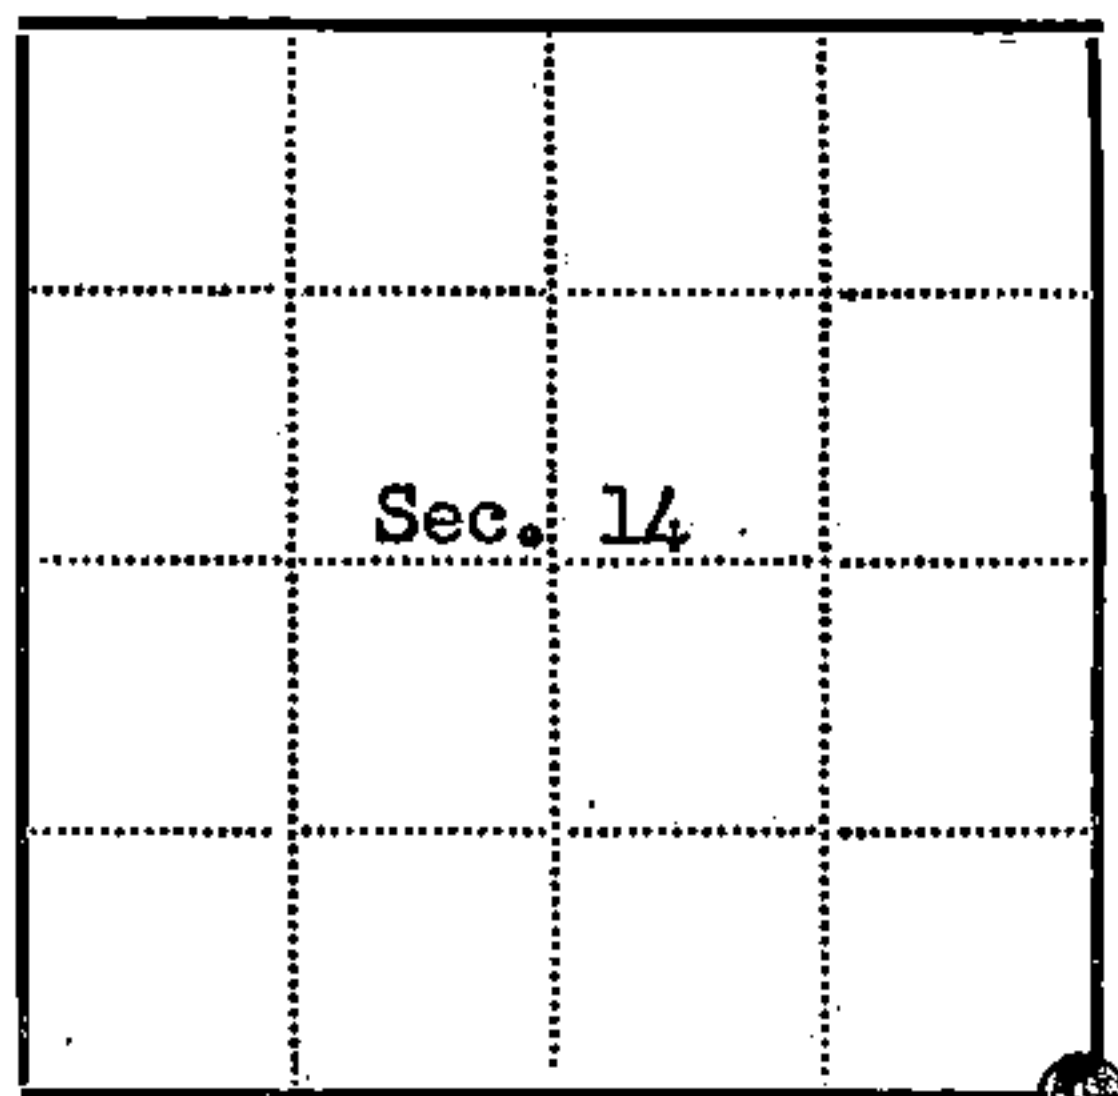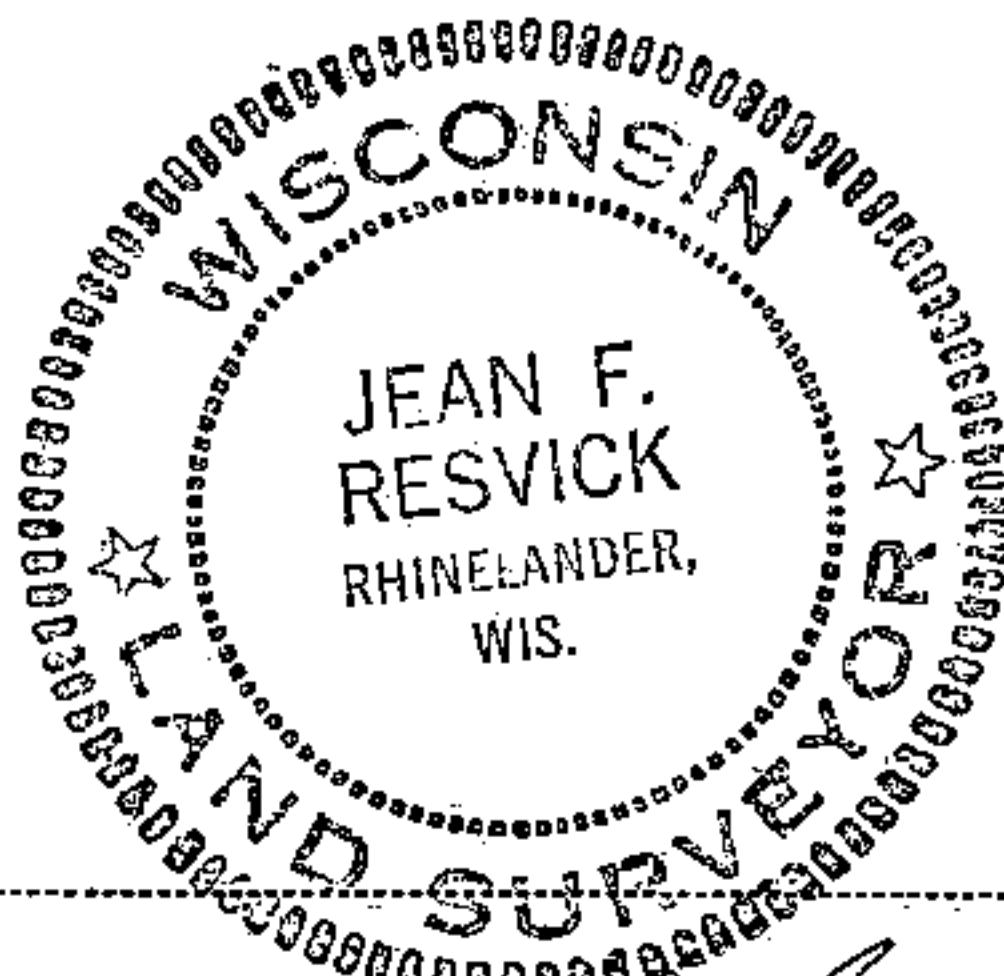

● - Corner monument restored
□ -

Resident witnesses.....

Dated at Rhinelander Wisconsin, this 17 day of May 1974.

Signature Jean F. Resvick Title Land Surveyor
(County Surveyor, Registered Land Surveyor, or other duly authorized official)

Surveyors Registration No. S-802 DOCUMENT NUMBER 105813

Office of Forest County of Forest

I hereby certify that the within instrument was filed in this office for record on the 8th day of August 1974, and was filed in Book No. Corner Restorations Page No. N-21 of County Records.

Signature Eugene Stutzman Title

Township 38 north, Range 12 east, Section 14, Index No. N-21, Page No.

43812140000

N21