

U.S. PUBLIC LAND SURVEY MONUMENT RECORD

Index No. E-13

State of Wisconsin }
County of FOREST } ss.

I, John C. Schulke, do hereby certify that on the 20th day of May, 1988, I found evidence of the Section 3, 4, 9 and 10 corner of Township 38, North, Range 14 East, Fourth Principal Meridian, as described hereon; and that from this evidence I established a new monument and accessories as described hereon to perpetuate the original location of this corner.

Resident witnesses:

History of original corner establishment:

The Original Government Survey of the subdivision of the township was made in 1865 by J. L. Nowlin. Set a wooden post with the following bearing trees:
Sugar 12" N67°W 10 lks.
Birch 18" N63°E 8 lks.

Description of corner evidence found:

In 1936, Carpenter placed a location tag on a 7" dia. Spruce tree on the SW side 8 feet Northeast of the corner. He piled rocks at the base of the stake.

In 1988, Found a mound of moss covered rock pile and the following


blazed trees: Red Maple stub 14" S20°E 11.6 ft.
Balsam stub 14" N23°W 5.8 ft.
Stump hole N63°E 5.3 ft.

Description of monument and accessories I established to perpetuate the original location of this corner.

Set a 2 1/2" diameter aluminum pipe monument, 3 feet long, 2 feet in the ground, with an aluminum cap stamped: T38N, R14E, S3, S4, S9, S10, 1988, S-1665. Established the following corner

references: Red Maple 12" N85°W 18.27 ft.
Sugar Maple 9" N06°W 35.60 ft.
Sugar Maple 8" S05°W 27.65 ft.
Red Maple 10" N29°E 45.73 ft.
Steel sign post East 1.5 ft.

REGISTER'S OFFICE / Forest County, Wis
Received for record this 9th day of December, A.D. 1988 at 10:10 o'clock A.M. and recorded in Vol. CORNER RESTORATIONS page E-13
Paul Aschenbrenner Register of Deeds

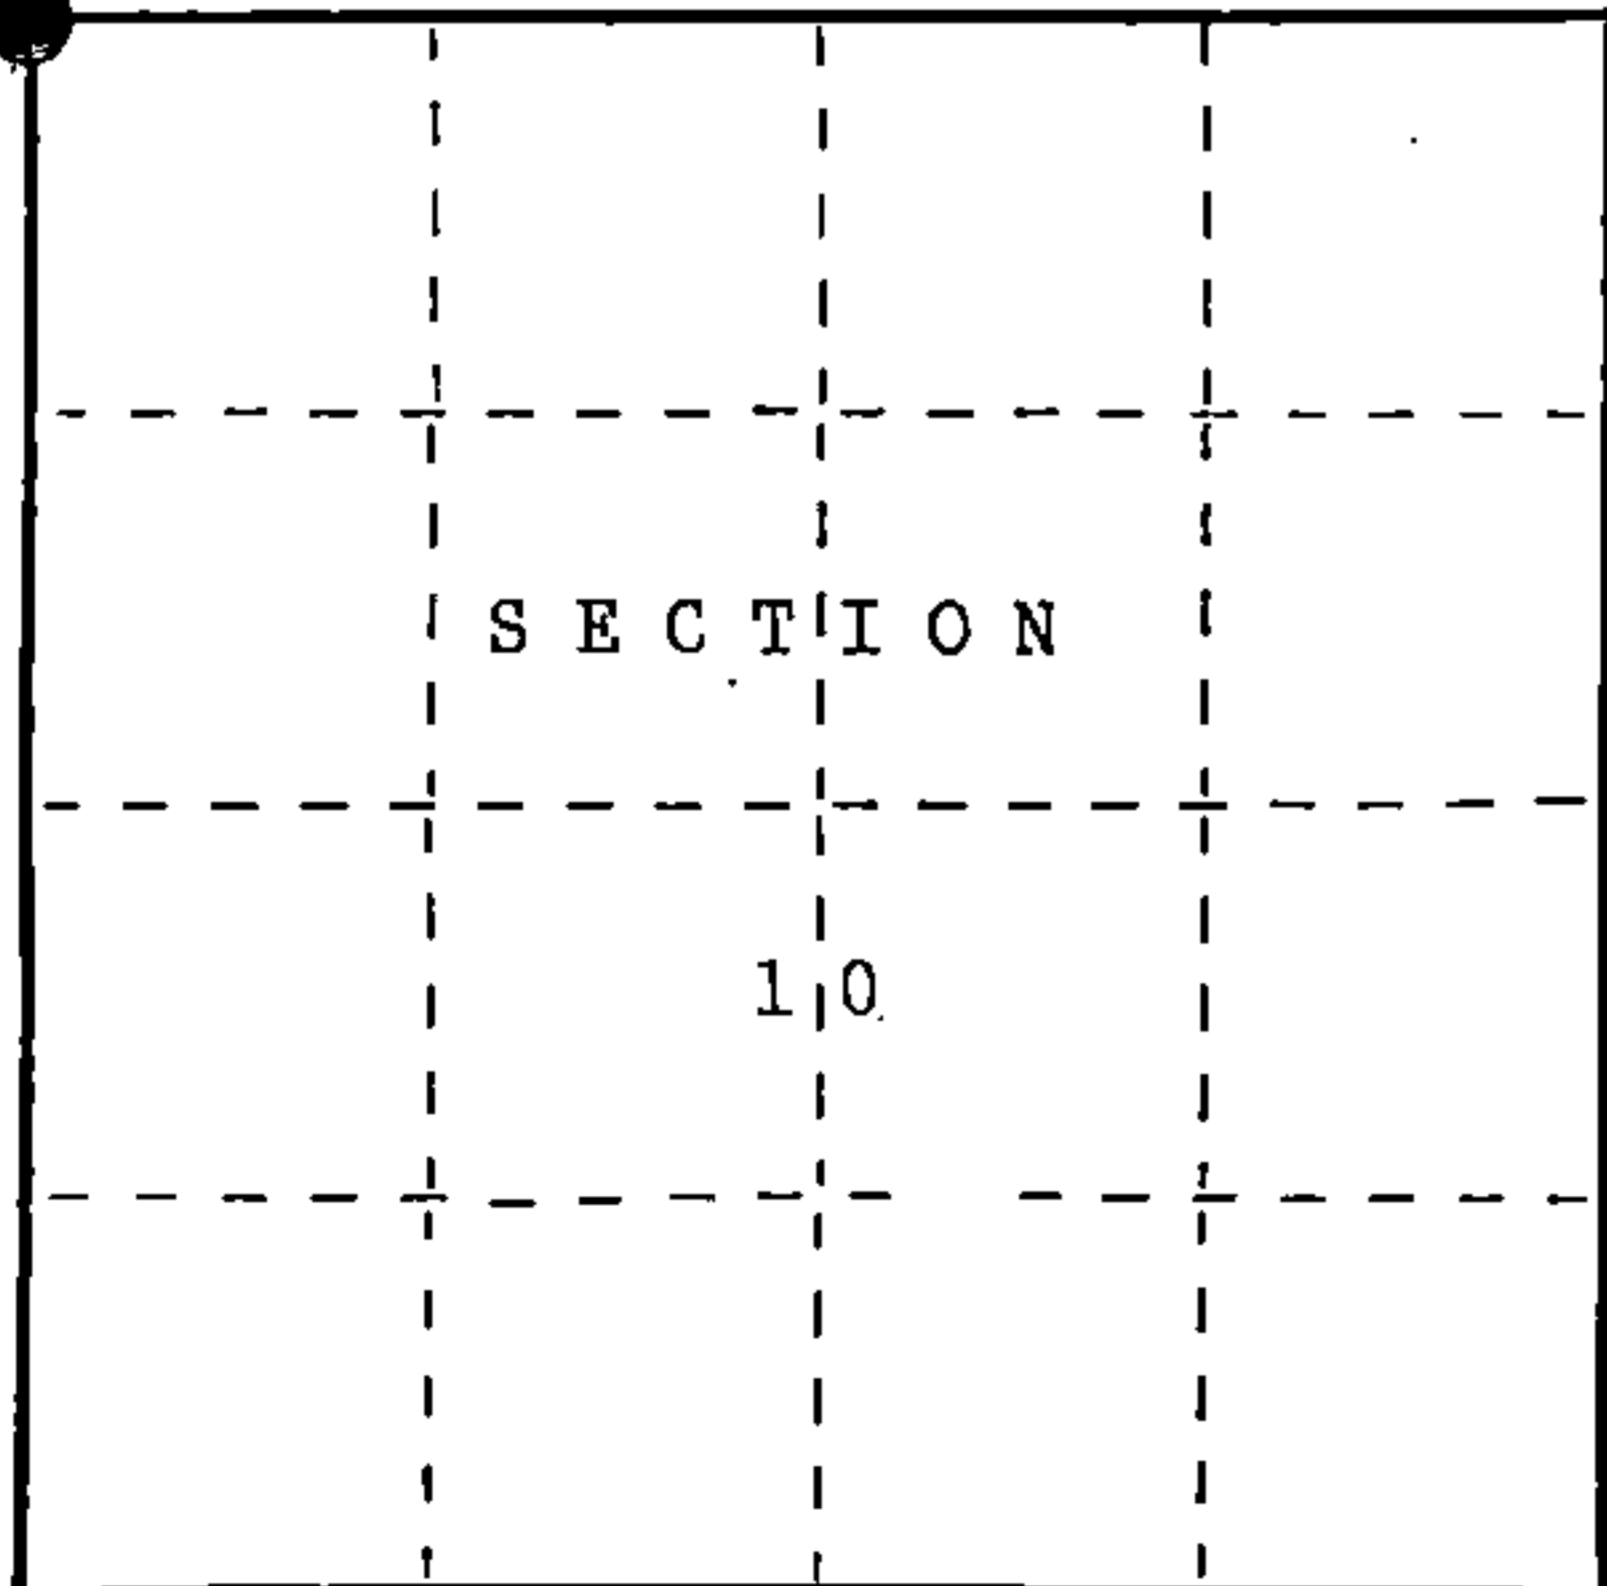

○ = Corner monument restored.

Dated at Cable, Wis., this 15th day of October, 1988.

Signature John C. Schulke Title Register Land Surveyor Registration No. S-1665
(County Surveyor, Registered Land Surveyor, or other duly authorized official)

Office of Register of Deeds, County of Forest, I hereby certify that the within instrument was filed in this office for record on the 9th day of December, 1988 at 10:10 o'clock A.M.

Paul Aschenbrenner
(Register of Deeds)

By Deputy

FORM NO. 985-A
H.C. Miller Company

Stock No. 26273

DOCUMENT NUMBER 136590

43814040000

