


U. S. PUBLIC LAND SURVEY MONUMENT RECORD

INSTRUCTIONS: This record shall show the location of the corner and shall include all of the following nine elements (a through i).

- (a) Identify the corner by reference to the U.S. public land survey system.
- = Corner monument restored.

West One Quarter Corner of Section 26, T38N, R14E

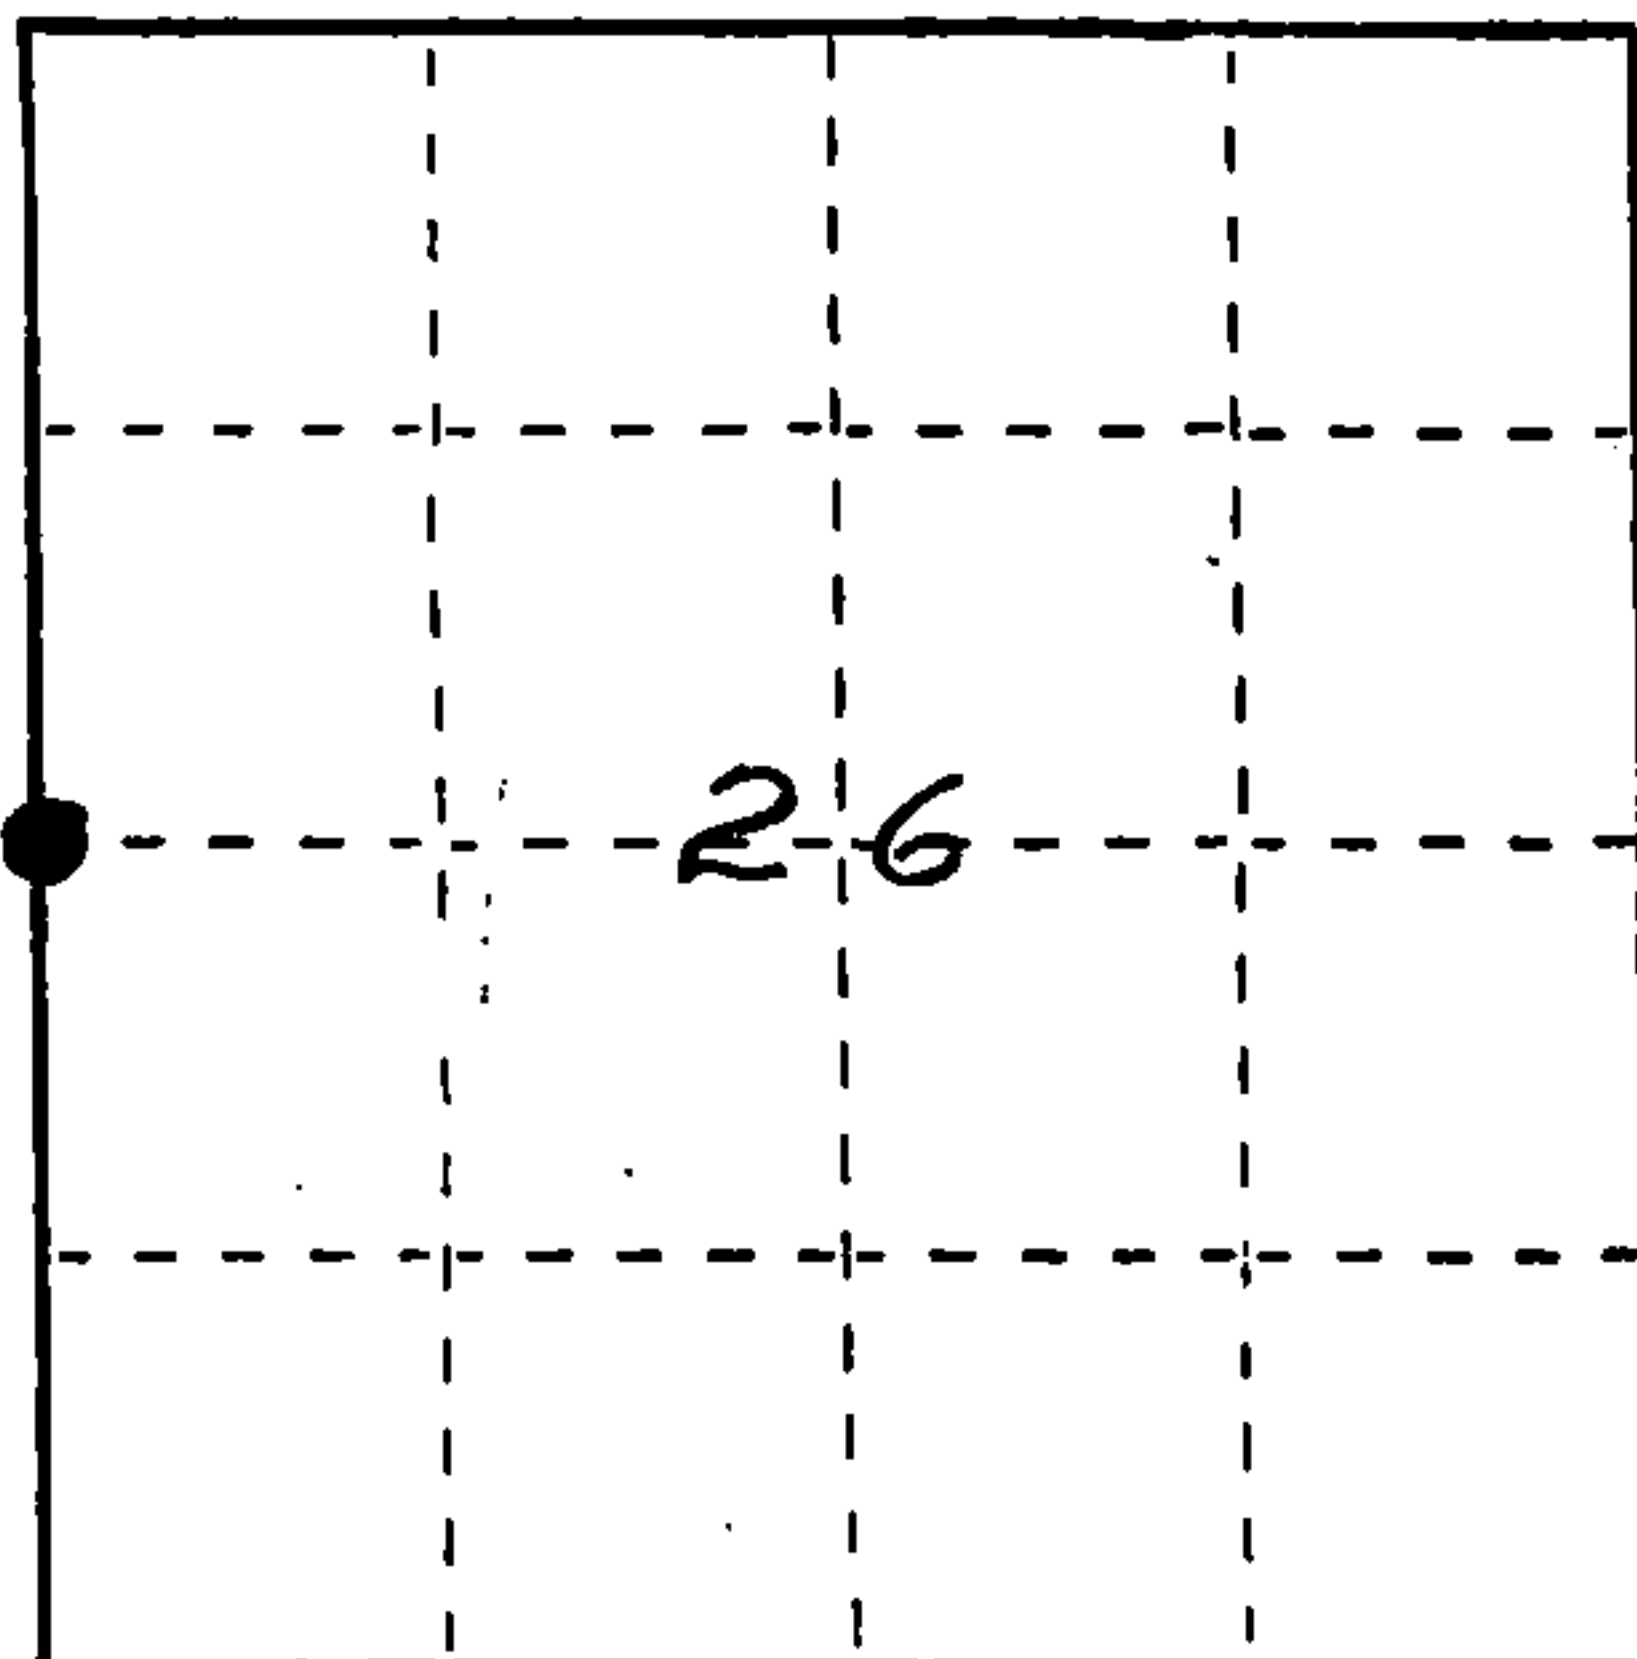

REGISTER'S OFFICE
Forest County, Wis.

Received for record this 5th day
of November A.D., 1986 at
3:50 o'clock P. M. and recorded
in Vol. CORNER RESTORATION

Page T-17
Paul Aschenbrenner
Register of Deeds.

- (b) Describe any record evidence, monument evidence, occupational evidence, testimonial evidence or any other material evidence you considered, and whether the monument was found or placed.


In 1865 James L. Nowlin set wood post with the following BTs:
Tamarack, 10", N66°E, 16 links; Tamarack, 7", S45°W, 22 links.
Set 2" diameter aluminum pipe 3 feet long with 3" diameter aluminum tablet stamped to identify corner. Corner was set on line from the East One Quarter of Section 26 through N.H. Smith's Center One Quarter and 5273.90 feet from the East One Quarter, which is weighted distance based on Smith distance on the south line of Section 26 compared to our distance on south line of Section 26.

Smith South Line 5220.26 feet Ours 5309.49 feet

Smith 1/4 Line 5284.62 feet Ours 5273.80 feet

- (c) In the plan view drawing below, provide reference ties to at least 4 witness monuments, or, if the location is within a municipality, to at least 2 witness monuments. (Witness monuments shall be made of concrete, natural stone, iron or other equally durable material.) Describe witness monuments.

- (d) Show a plan view drawing depicting the relevant monuments and reference ties which is sufficient in detail to enable accurate relocation of the corner monument if the corner monument is disturbed. Indicate north.

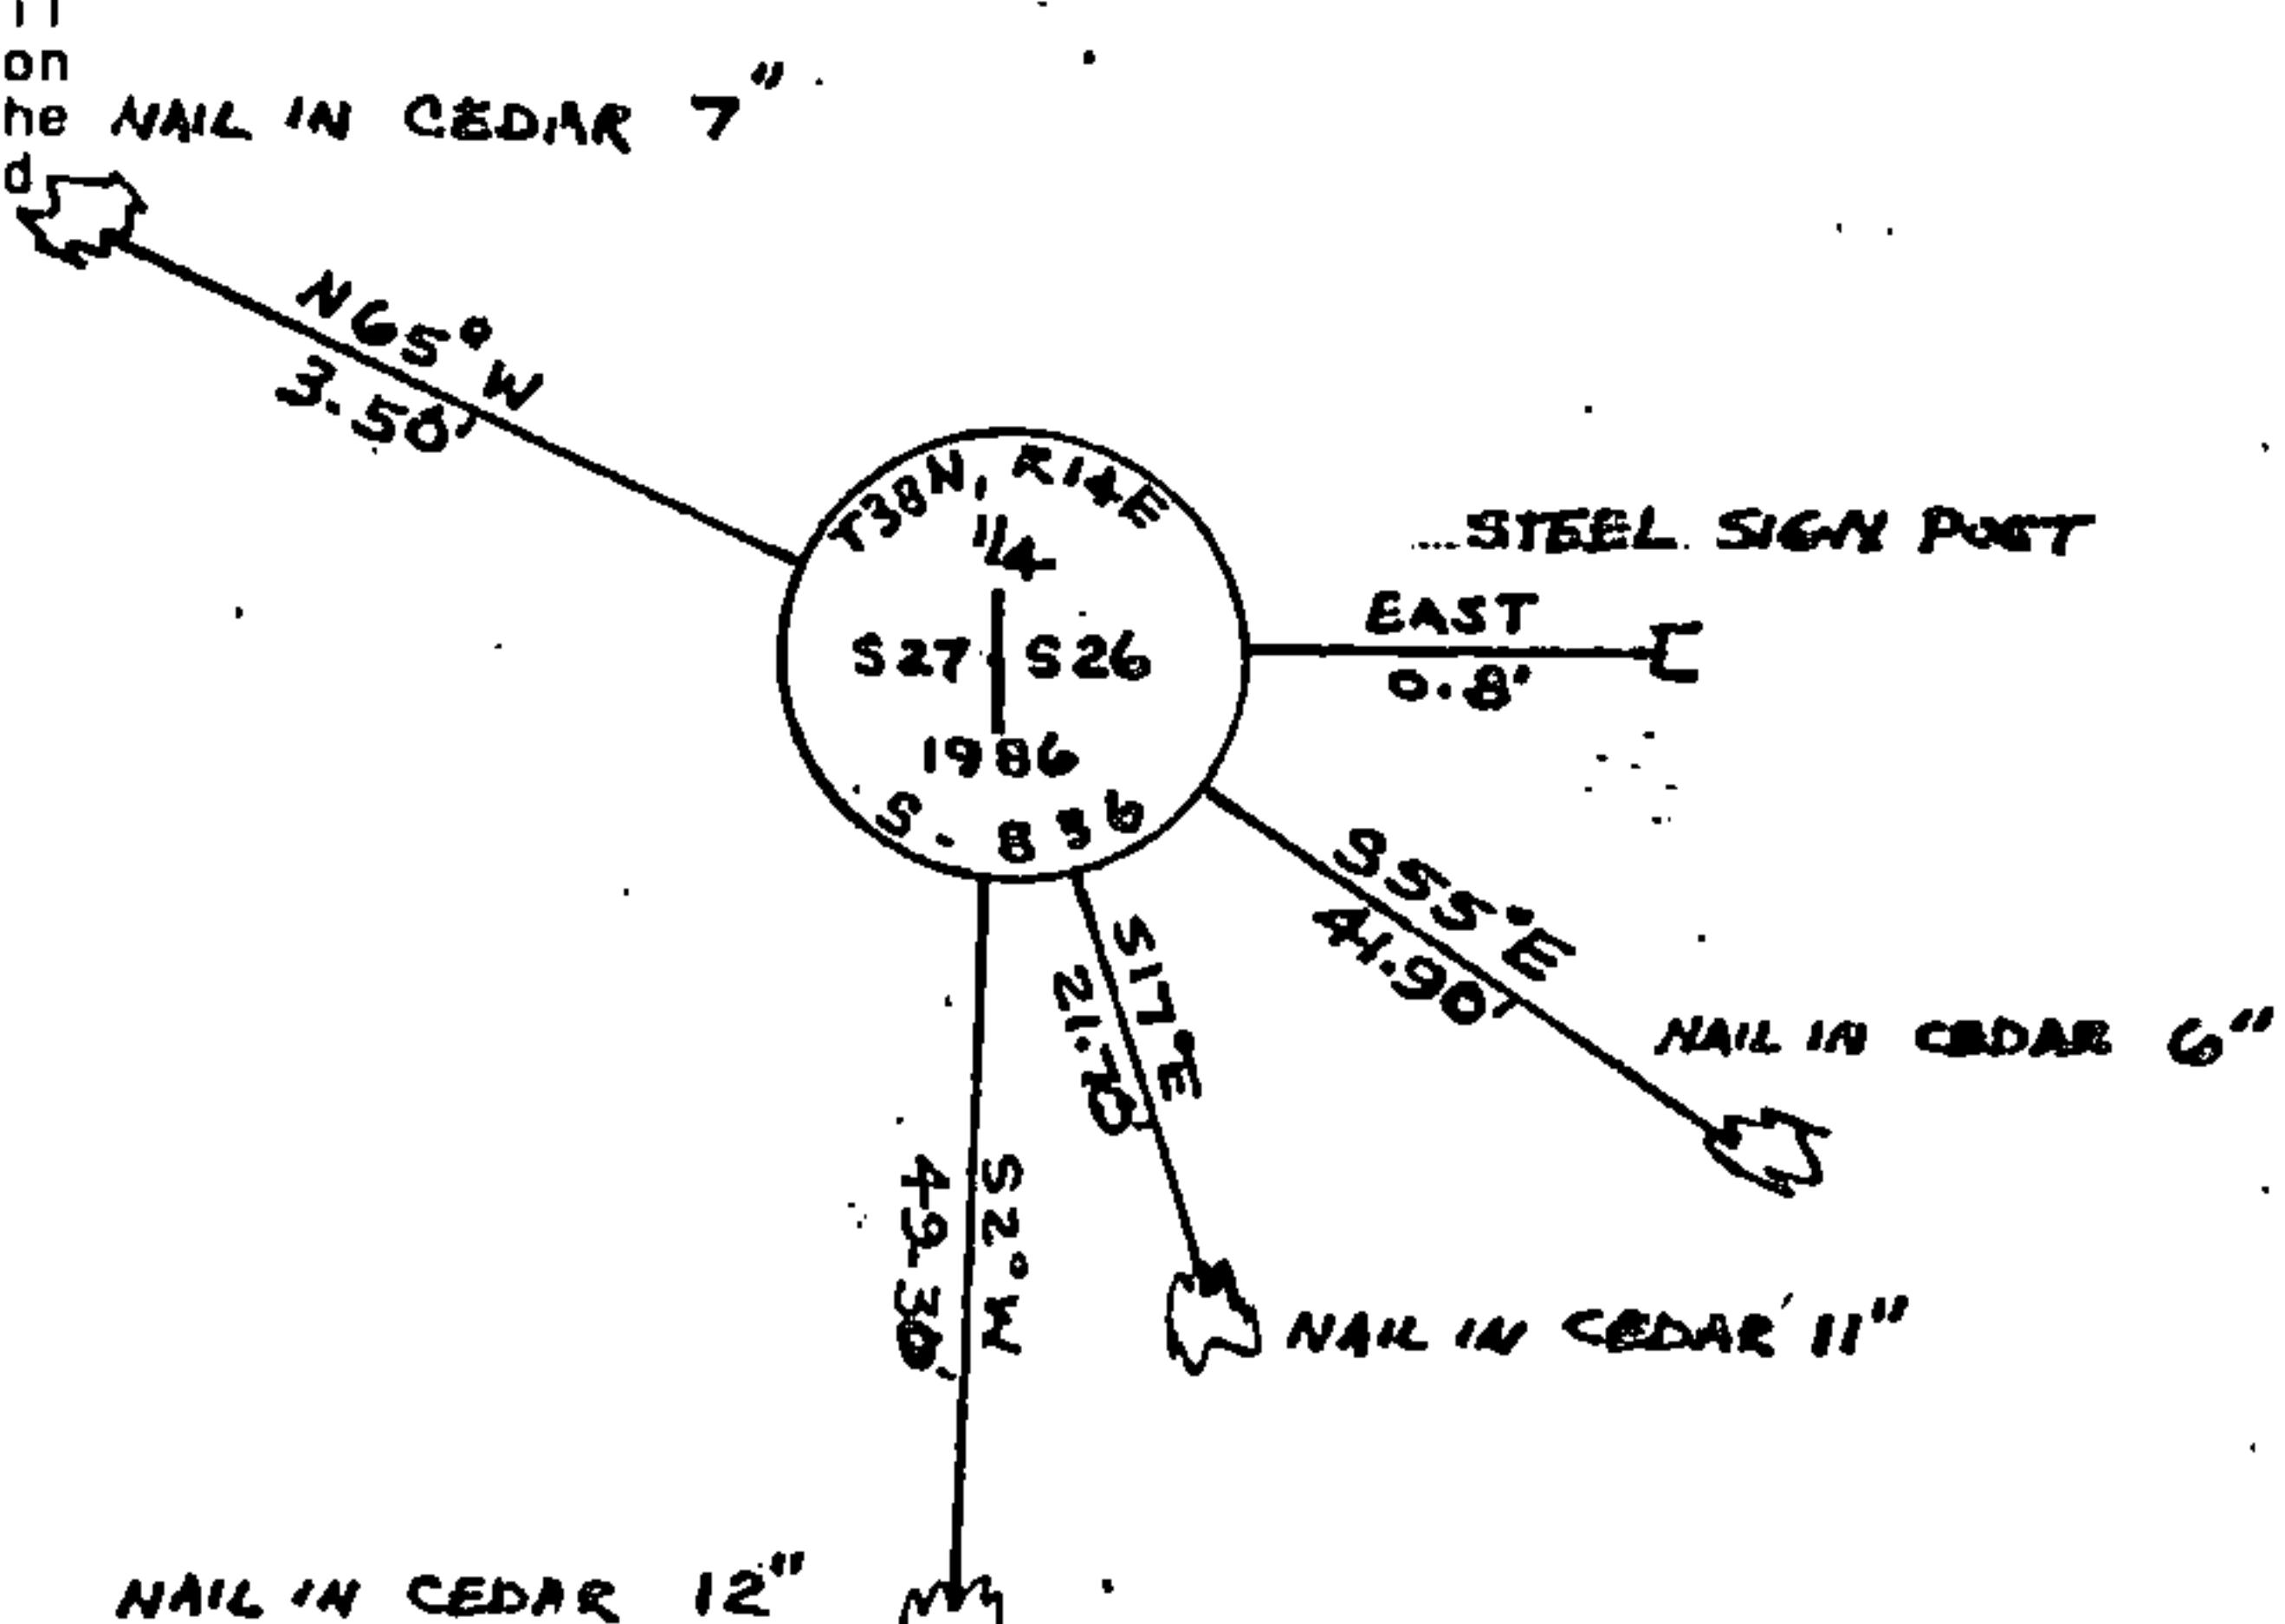


(e) Describe any material discrepancy between the location of the corner as restored or reestablished and the location of that corner as previously restored or reestablished by distance and direction. Show the discrepancy on the plan view drawing under (d), above. Show the distances between the corner as previously restored or reestablished and (1) the corner as restored or reestablished, and (2) to at least 2 of the witness monuments shown on the drawing in (d), above.

NA

(f) Was the corner restored through acceptance of (1) an obliterated evidence location, or, (2) a found perpetuated location?

NO

(g) Was the corner reestablished through lost corner proportionate methods? If so, show the method, including the directions and distances to other public land survey corners used as evidence or used for proportioning in determining the corner location?

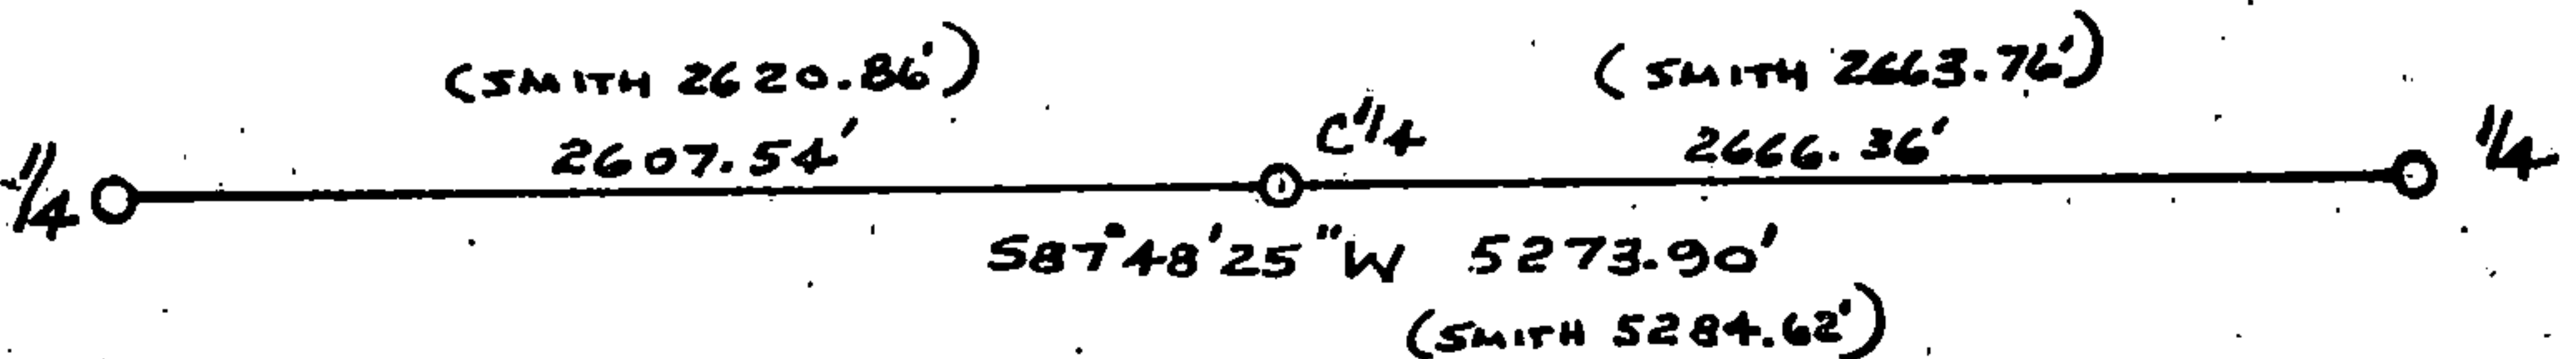

Affix Land Surveyor Seal



(1) I, John H. Fisher

(Type or print name) certify that the corner location shown on this record was determined by me or under my direction and control and that this U.S. Public Land Survey Monument Record is correct and complete to the best of my knowledge and belief.

John H. Fisher
Signature

10/30/86
Date