

U.S. PUBLIC LAND SURVEY MONUMENT RECORD

Index No. Z-19

State of Wisconsin }
County of Forest } ss.

I, Gary L. Pisoni, do hereby certify that on the 7th day of March, 1994, I found evidence of the South Quarter corner of Section 35 Township 38 North, Range 14 East, Fourth Principal Meridian, as described hereon; and that from this evidence I established a new monument and accessories as described hereon to perpetuate the original location of this corner.

Resident witnesses:

History of original corner establishment:

Original Government Survey in 1857 by Alfred Millard. West bet. Sections 35 and 2, at 40.00 chs., set Quarter Section Post, from which the following bear; Spruce, 6", N45°W, 5 1/2 kals, Spruce, 6", S28°E, 31 1/2 kals.

On 5-24-88, Glen Barker, a Land Surveyor with Consolidated Papers, found the following set by Norman Harrison, RLS-1394: 1 1/2" dia. iron pipe flush with woods road, Maple, 12", NE 1/4, 24.92 feet, Yellow Birch, 28", SE 1/4, 39.25 feet. Barker replaced iron pipe with a 2 1/2" aluminum Forest County Monument with an alloy cap stamped; T38N, R14E, 1/4, S35, S2, T37N, R14E, 1988, S1682. Blazed and scribed the following new bearing trees;

Description of corner evidence found:	Sugar	10"	N70°W	54.95 feet
	Maple	14"	N18°E	51.63 feet
	Maple	16"	S18°W	42.55 feet
	Elm	6"	S24°E	24.47 feet


Found the monument as described above and the following bearing trees;

Sugar	10"	N70°W	54.95 feet
Red Maple	16"	N18°E	51.63 feet
Red Maple	18"	S18°W	42.55 feet

Description of monument and accessories I established to perpetuate the original location of this corner.

Blazed and scribed a new bearing tree:(Measurement is taken to a nail in side of tree)

Red Maple	4"	S33°E	37.65 feet
Steel Sign Post		S15°W	1.20 feet

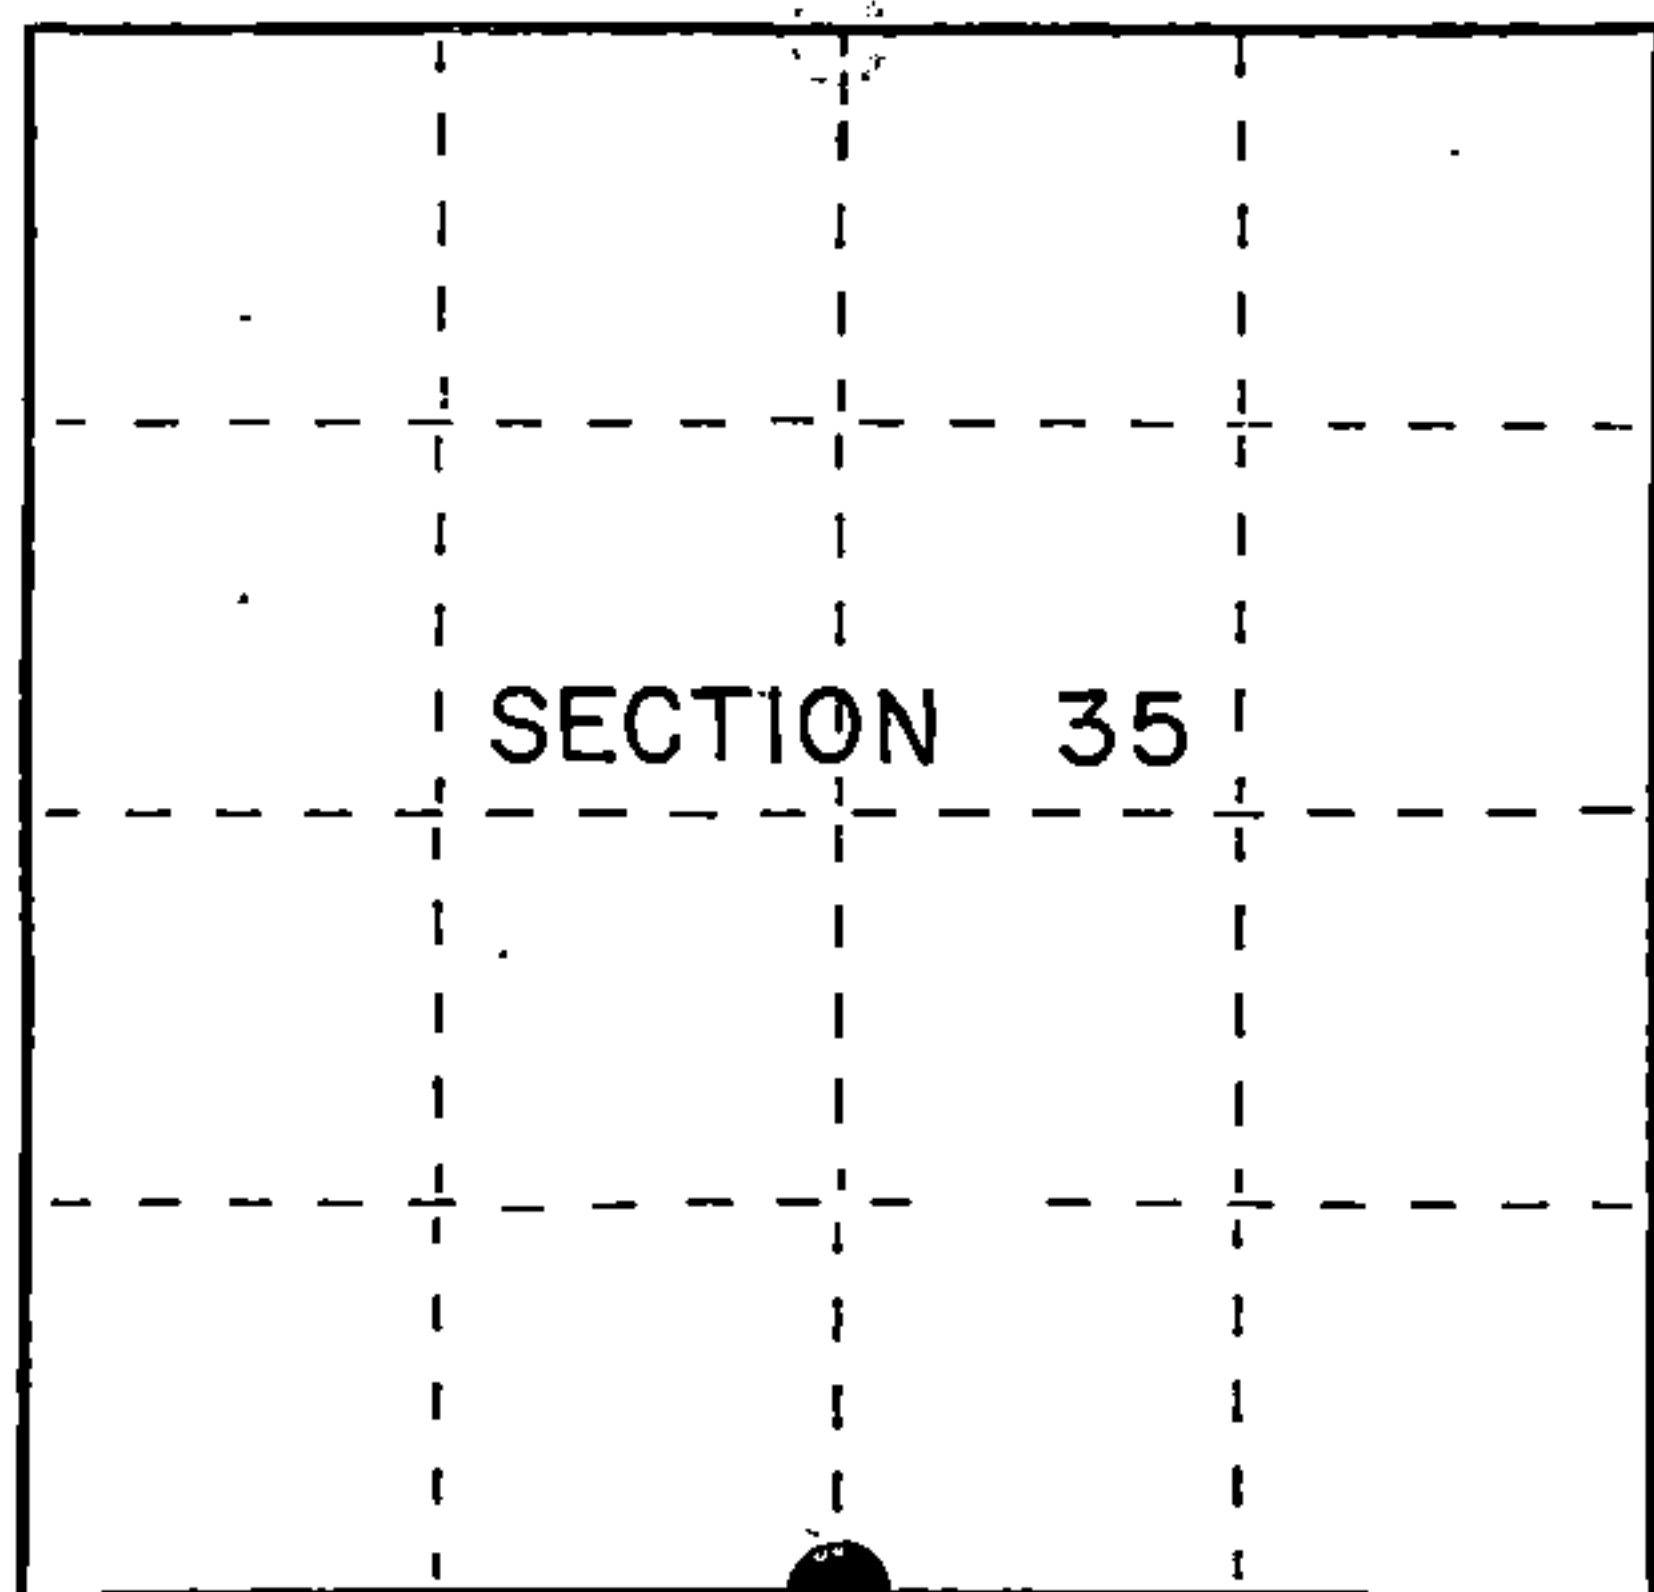

● = Corner monument restored.

Dated at Iron River, MI - Wis., this 5th day of May, 1994

Signature Gary L. Pisoni Title Land Surveyor Registration No. _____
(County Surveyor, Registered Land Surveyor, or other duly authorized official)

Office of Register of Deeds, County of Forest, I hereby certify that the within instrument was filed in this office for record on the 20th day of March, 1997 at 1:30 o'clock P. M.

(Register of Deeds)

By [Signature] Deputy

FORM NO. 985-A

H.C. Miller Company

Stock No. 26273

158160

43814350020

CERTIFIED LAND CORNER RESTORATION
U.S. PUBLIC LAND SURVEY

Index No. A-19

State of Wisconsin }
County of Forest } ss.

History of original corner establishment:

Original corner established by A. Curtis, Deputy Surveyor in 1857 from which Hemlock 25" bears N22°W 23 links and Yellow Birch 14" bears S63°E 15 links.

I Glen Barker, do hereby certify that on the 24th day of May, 1988, I found evidence of the quarter section corner of 2 & 35 Township 37 & 38, North, Range 14 East, Fourth Principal Meridian, as described hereon; and that from this evidence I established a new monument and accessories as described hereon to perpetuate the original location of this corner.

Description of corner evidence found:

Recovered Norman A. Harrison R.L.S. S-1394 1½" I.P. flush with old woods road bed and B.T.'s Maple 12" NE¼ 24.92'. Yellow Birch 28" SE¼ 39.25'.

Resident witnesses:

Norm Spiess

Herb Wagoner

Description of monument and accessories I established to perpetuate the original location of this corner.

Replaced 1½" I.P. with a 2½" aluminum Forest County monument with 3½" alloy cap stamped:


Monument flush with old road bed.

Marked N.B.T.'s
Sugar 10" N70°W 54.95'
Maple 14" N18°E 51.63'
Maple 16" S18°W 42.55'
Elm 6" S24°E 24.47'

T38N
S1682
S1/4 S 35
S 12
T37N-R14E
1988

DOCUMENT NUMBER
136224

FORM 985 H. C. MILLER CO., MILWAUKEE

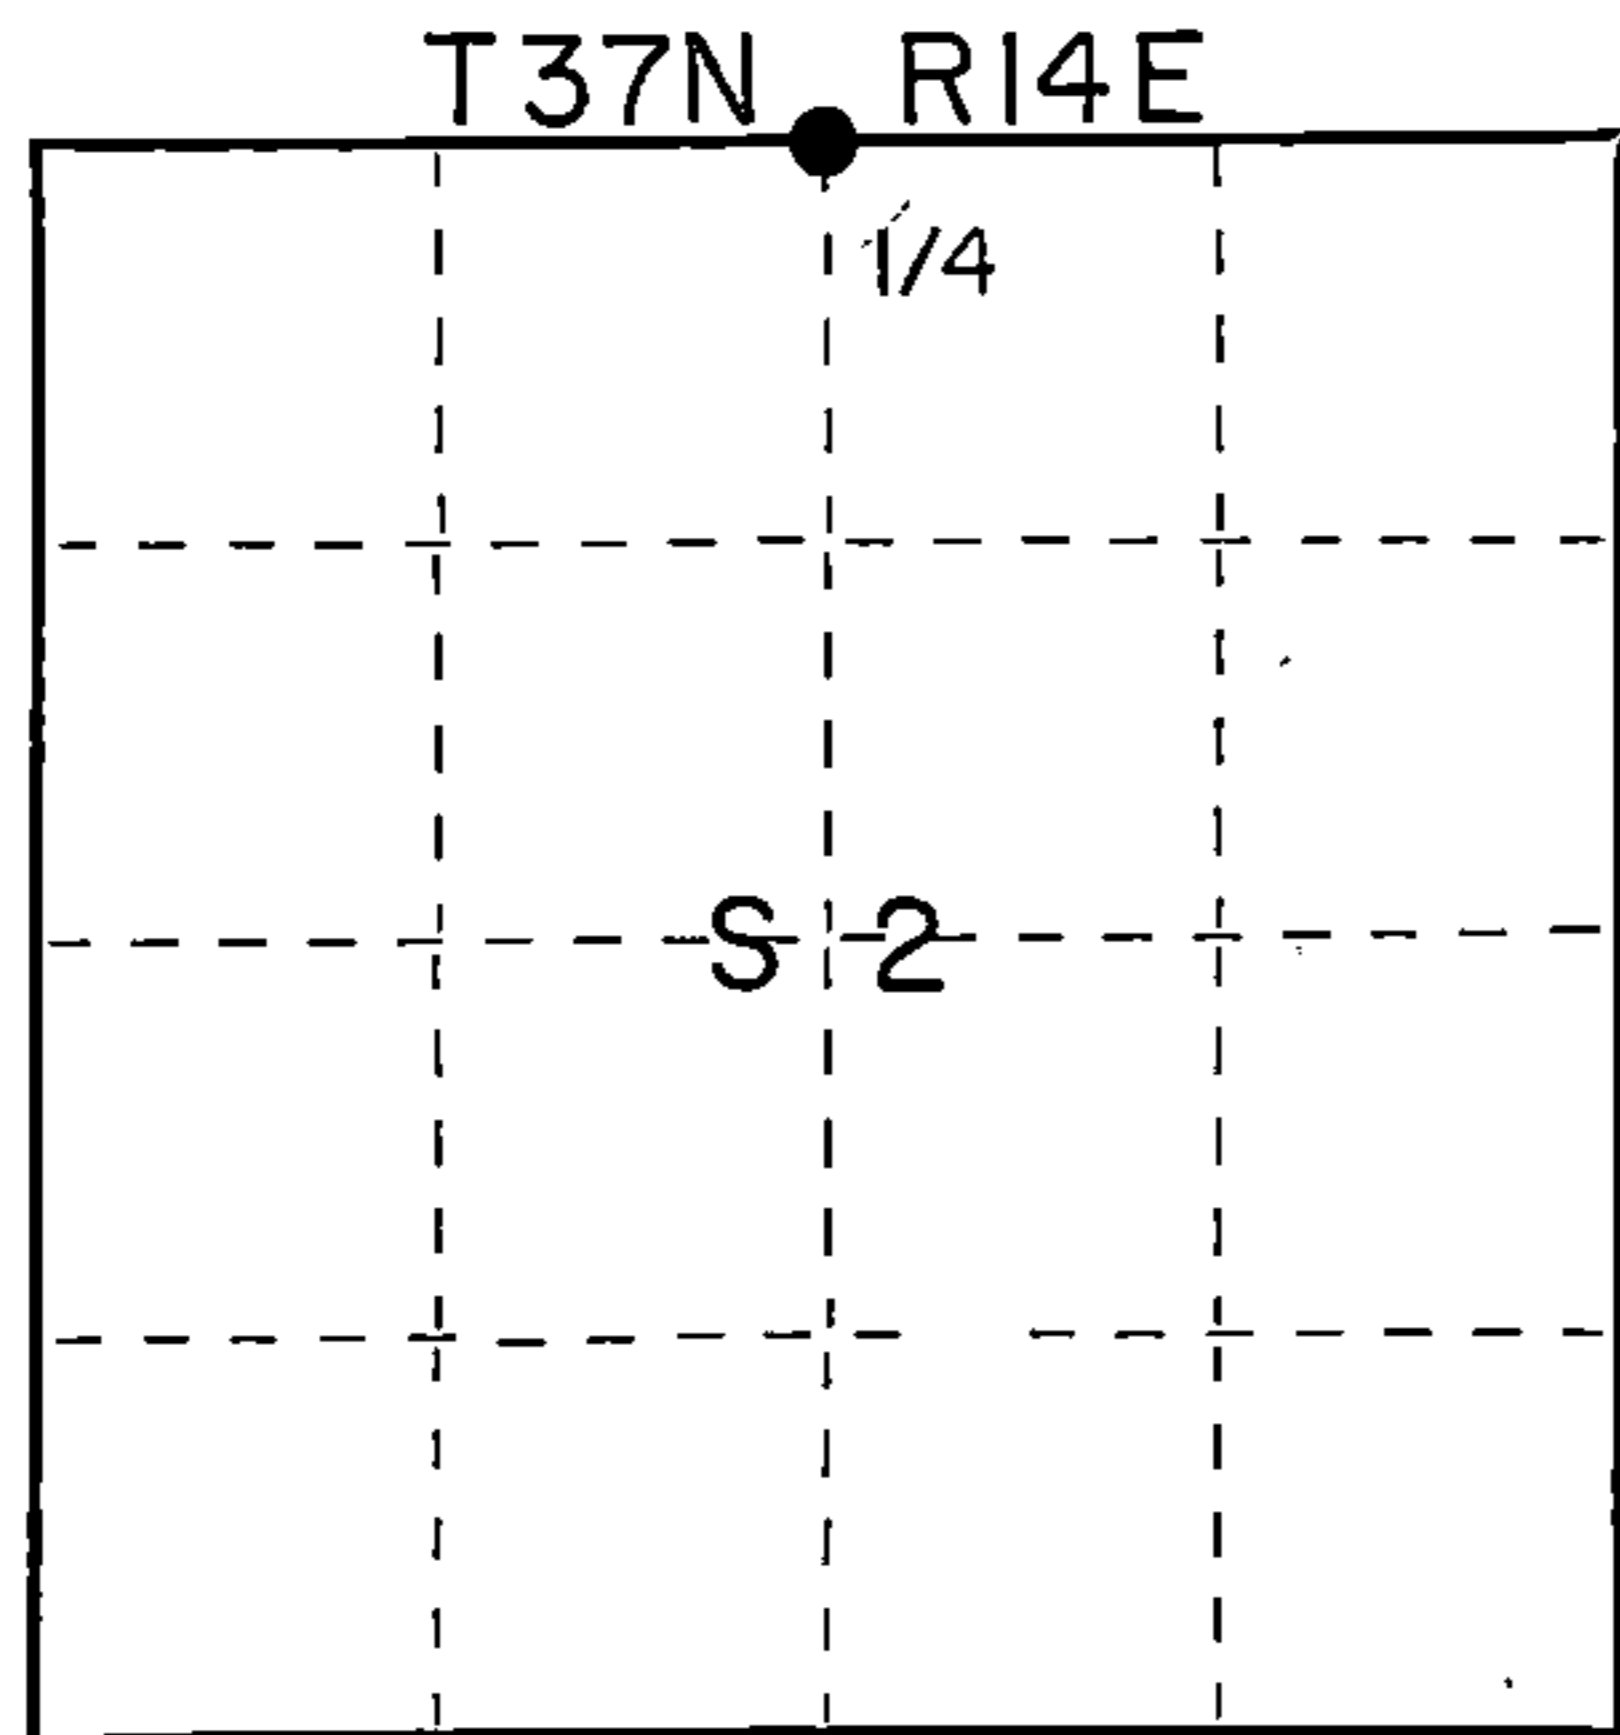

○ = Corner monument restored.

Dated at _____, Wis., this _____ day of _____, 19_____

Signature Glen Barker Title _____ Registration No. _____
(County Surveyor, Registered Land Surveyor, or other duly authorized official)

Office of Register of Deeds, County of Forest, I hereby certify that the within instrument was filed in this office for record on the 19th day of October, 1988 at 11:00 o'clock A. M.

Paul Aschenbrenner
(Register of Deeds)

By _____ Deputy

43814350020

(c) Describe any material discrepancy between the location of the corner as restored or reestablished and the location of that corner as previously restored or reestablished by distance and direction. Show the discrepancy on the plan view drawing under (d), above. Show the distances between the corner as previously restored or reestablished and (1) the corner as restored or reestablished, and (2) to at least 2 of the witness monuments shown on the drawing in (d), above.

(f) Was the corner restored through acceptance of (1) an obliterated evidence location, or, (2) a found perpetuated location?
Perpetuated Location

(g&h) Was the corner reestablished through lost corner proportionate methods? If so, show the method, including the directions and distances to other public land survey corners used as evidence or used for proportioning in determining the corner location?

(i) I, Glen Barker
(type or print name) certify that the corner location shown on this record was determined by me or under my direction and control and that this U.S. Public Land Survey Monument Record is correct and complete to the best of my knowledge and belief.

Glen Barker
Signature

Sept. 7, 1988
Date

