St	tate	of	Wisconsin	l
County	of	Fo	rest	ſ

nilo E. Stefan , do hereby certify that on the 20th day of October , 19.88, I found evidence of the Meander corner of Section 6 and 7

Township 39 , North, Range 12 East , Fourth Principal Meridian, as described hereon; and that from this evidence I established a new monument and accessories as described hereon to perpetuate the original location of this corner.

## Resident witnesses:

DOCUMENT NUMBER

2627

Stock No.

FORM NO. 985-A

Myron L. Smith	
Jeffrey L. Kennedy	
Jeanne M. Stefan	

6	
i i i	
SEVENMILE	-
Jerem 172	
LAME	
	_
/!!!!!!	
<del> </del>	-
1 1	

O = Corner monument restored.

## U.S. PUBLIC LAND SURVEY MONUMENT RECORD

Index No. E-2,3

History of original corner establishment:

1859 William Daugherty established this corner.

1939 G.L.O. conducted a dependent resurvey and extension survey and restored this corner.

1967 Jean Resvick maintained corner as set by G.L.O. by placement of a 2"  $\times$  20" galvanized iron pipe and made two new BTs:

5" Hemlock, N60°E, 17.58'

6" Balsam, S35°?, 35.00'

Description of corner evidence found:

We found Resvick's monument and both his BTs. G.L.O. BTs down and cedar post gone. Certificate filed by Resvick 3/27/68, Document #94348.

10" Hemlock, N60°E, 17.58'

8" Balsam, S35°W, 35.09'

Description of monument and accessories I established to perpetuate the original location of this corner. We made new BT, set sign post and posted accessories to Forest Service standards:

6" White Birch, N87°E, 21.77'


6 Steel Sign Post, East, 12.5

_
(6
12
M
10
O
17
3
4

Dated at Crandon	, Wis., this	15 <b>t</b> h	day of	Novemb	er	19.88
Signature Mile C. Slejen (County Surveyor, Registere	Titled Land Surve	Land yor, or oth	Surveyor	official)	Registration	n NoS-1558
Office of Register of Deeds, County of instrument was filed in this office for reco at 9:55 o'clock A. M.	FOI ord on the	est 7th	day	of	hereby certify March	that the within
Paul Aschenbrenner (Register of Deeds)						

(e) Describe any material discrepancy between the location of the corner as restored or reestablished and the location of that corner as previously restored or reestablished by distance and direction. Show the discrepancy on the plan view drawing under (d), above. Show the distances between the corner as previously restored or reestablished and (1) the corner as restored or reestablished, and (2) to at least 2 of the witness monuments shown on the drawing in (d), above.

- (f) Was the corner restored through acceptance of (1) an obliterated evidence location, or, (2) a found perpetuated location?
  - 2) A found restored position.
- (g&h) Was the corner reestablished through lost corner proportionate methods? If so, show the method, including the directions and distances to other public land survey corners used as evidence or used for proportioning in determining the corner location?

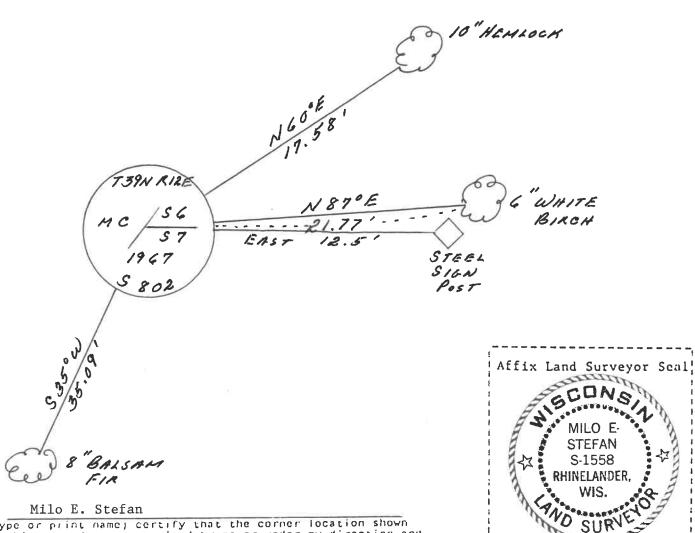

( i )

(type or print name) certify that the corner location shown on this record was determined by me or under my direction and control and that this U.S. Public Land Survey Monument Record is correct and complete to the best of my knowledge and belief.

tefan Signature

Miller

Certificate ready for filing:

Januar Ford District Ranger