

CERTIFIED LAND CORNER RESTORATION

State of Wisconsin

County of Forest

ss.

I Jean F. Resvick, do hereby certify that on the 8th day of November, 1974, I found evidence of the Southeast Section corner of Section 9 Township 39 North, Range 12 East, Fourth Principal Meridian, as described hereon; and that from this evidence I established a new monument and accessories as described hereon to perpetuate the original location of this corner:

Description of original monument and accessories and subsequent restorations:

Surveyed in 1859 by William E. Daugherty
Dependent resurvey in 1941 by H. D. Craig
From original evidence set iron post 3 ft. long 2 inch diameter, 27 inches in the ground, for corner of sections 9, 10, 15 and 16 with brass cap marked:
T39N, R12E, S9, S10, S16, S15 1941 from which a hard maple, 16 inches diameter bears:
N42 1/2 E, 37 lks. dist.
A cedar, 5 inch diameter, bears S19 1/4 E, 88 lks. dist.
A cedar, 12 inch diameter, bears S 24 W, 97 lks. dist.
A white pine, 8 inch diameter bears N 70 1/2 W, 33 lks. dist.



Description of corner evidence found:

Monument found as described above from which a maple, 22 inch diameter, bears N42 1/2 E, 37 lks. dist.
A cedar stump, bears S 19 1/4 E, 88 lks., dist.
A cedar stump scribed, bears S 24 W, 97 lks. dist.
A white pine, 19 inches bears N 70 1/2 W, 33 lks. dist.

Description of monument and accessories I established to perpetuate the location of this corner:

Blazed and scribed the following new bearing tree;

A cedar 8 inch diameter, bears S45E, 47.50 feet
A steel sign post northeast 1 foot

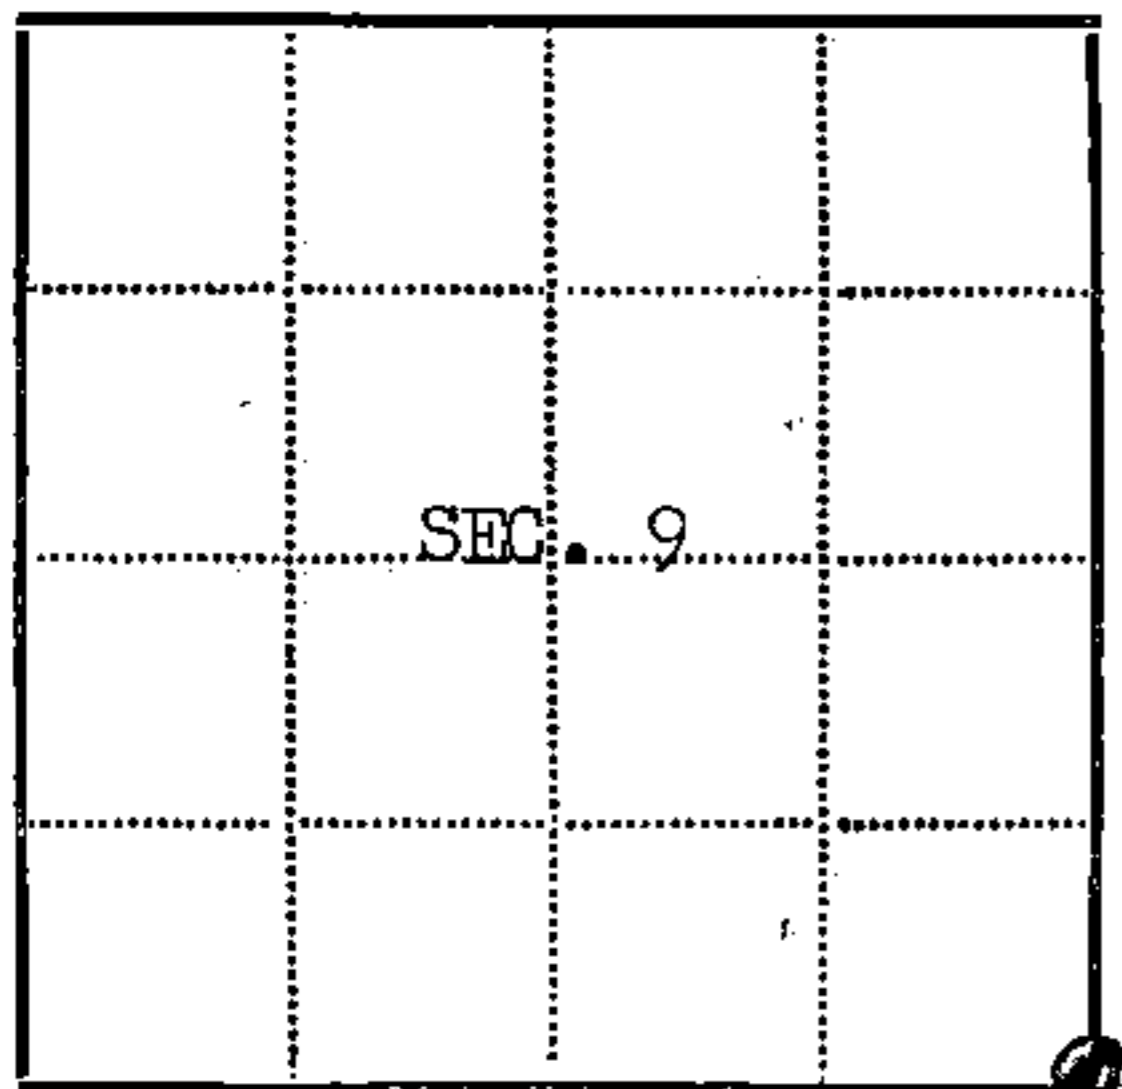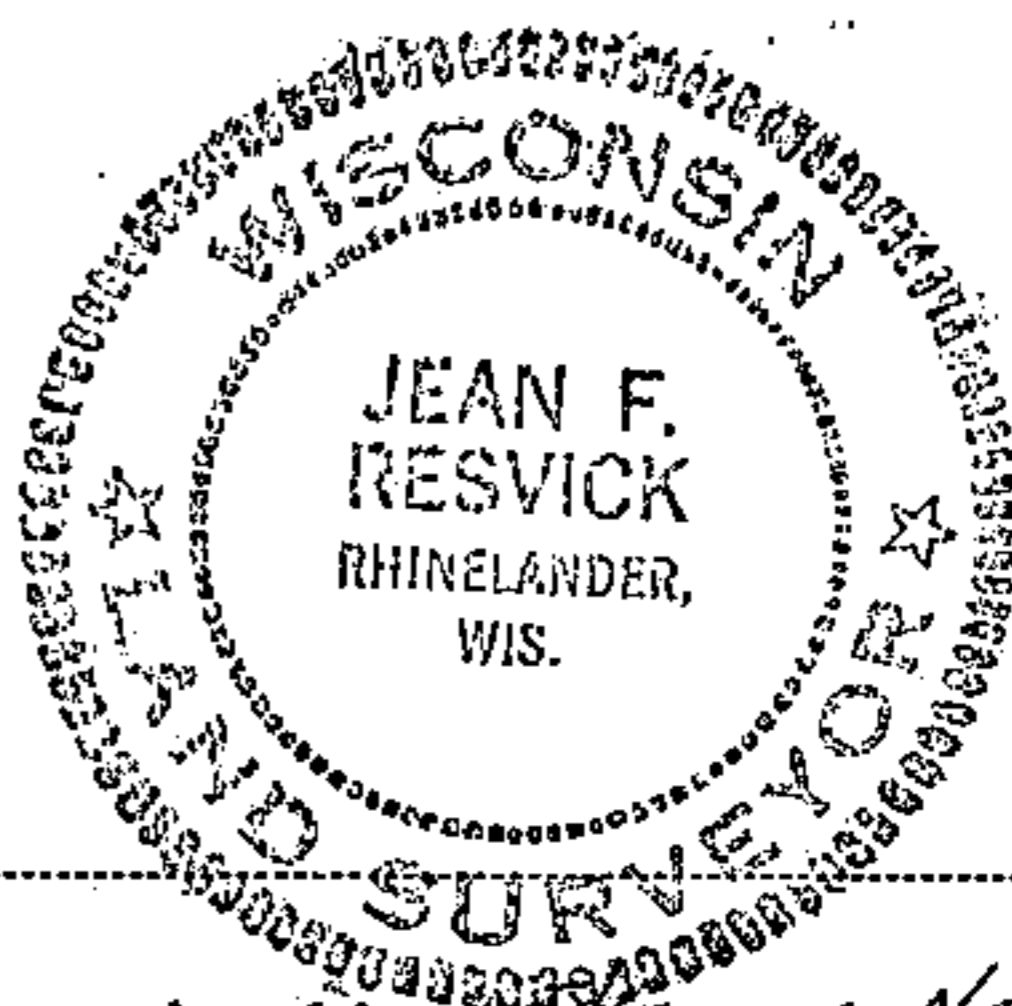

Legend: Circle with dot = Corner monument restored; Square =

Resident witnesses

Dated at Rhinelander Wisconsin, this 12th day of Nov 1974

Signature: Jean F. Resvick Title: Land Surveyor
(County Surveyor, Registered Land Surveyor, or other duly authorized official)

Surveyors Registration No. S-802 DOCUMENT NUMBER 106702

Office of Register of Deeds County of Forest

I hereby certify that the within instrument was filed in this office for record on the 10th day of February 1975, and was filed in Book No. 8:45 AM Page No. of County Records.

Signature: Eugene Stetson Title: Register of Deeds

Township 39N, Range 12E, Section 9, Index No. J-13, Page No.

43912090000

13