

CERTIFIED LAND CORNER RESTORATION

State of Wisconsin }
 County of Forest } ss.

I, Jean F. Resvick, do hereby certify that on the 18th day of July, 1967, I found evidence of the North quarter corner of Section 6 Township 38 North, Range 12 East, Fourth Principal Meridian, as described hereon; and that from this evidence I established a new monument and accessories as described hereon to perpetuate the original location of this corner:

Description of original monument and accessories and subsequent restorations:


Original survey in 1859 by William E. Daugherty.
 Dependent resurvey in 1937 by Wesson Cook.
 At proportionate distance, set a concrete monument, 6 ins. diam., 22 ins. in the ground, for 1/4 section corner; with brass tablet marked: 1/4, S31, S6, 1937, from which:
 A birch, 12 ins. diam., bears S52°E, 83 lks.
 A basswood, 13 ins. diam. bears S48° 30'W, 145 lks.

Description of corner evidence found:

Basswood 21 ins. diam., scribed.
 White birch stump 14 ins. diam., scribed.
 Location of corner as located by the record bearing and distances would fall in road.


Description of monument and accessories I established to perpetuate the ~~original~~ location of this corner:

At recorded bearing and distance from bearing trees set 6 in. diam., concrete monument 3 ft. long, 6 ins. below surface of road, with brass cap marked:

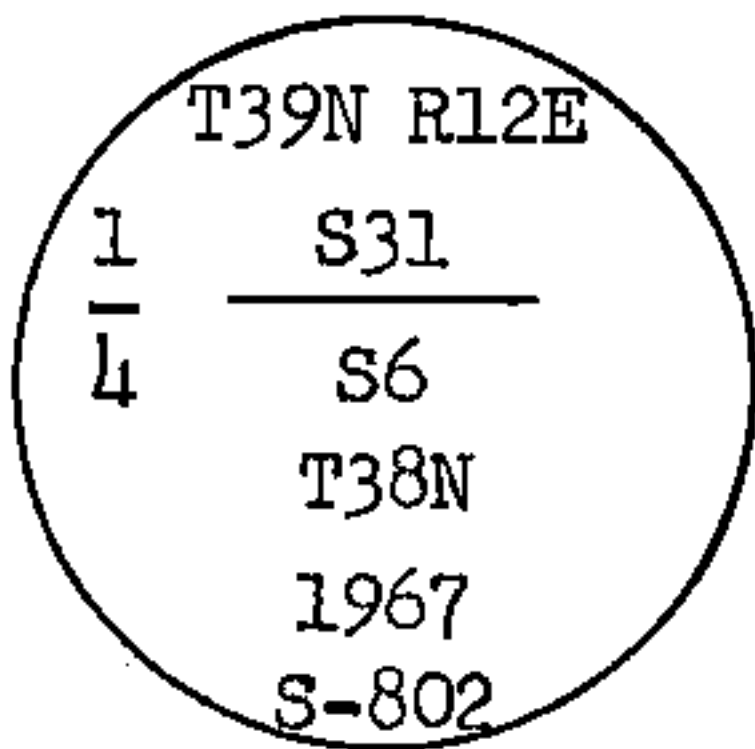

from which the following new blazed and scribed bearing trees bear:

- Red pine 5", S16°E, 74.43 ft. or 112.773 lks.
- Red pine 10", N58°W, 40.71 ft. or 61.682 lks.
- Red pine 6", N61°E, 62.42 ft. or 94.576 lks.

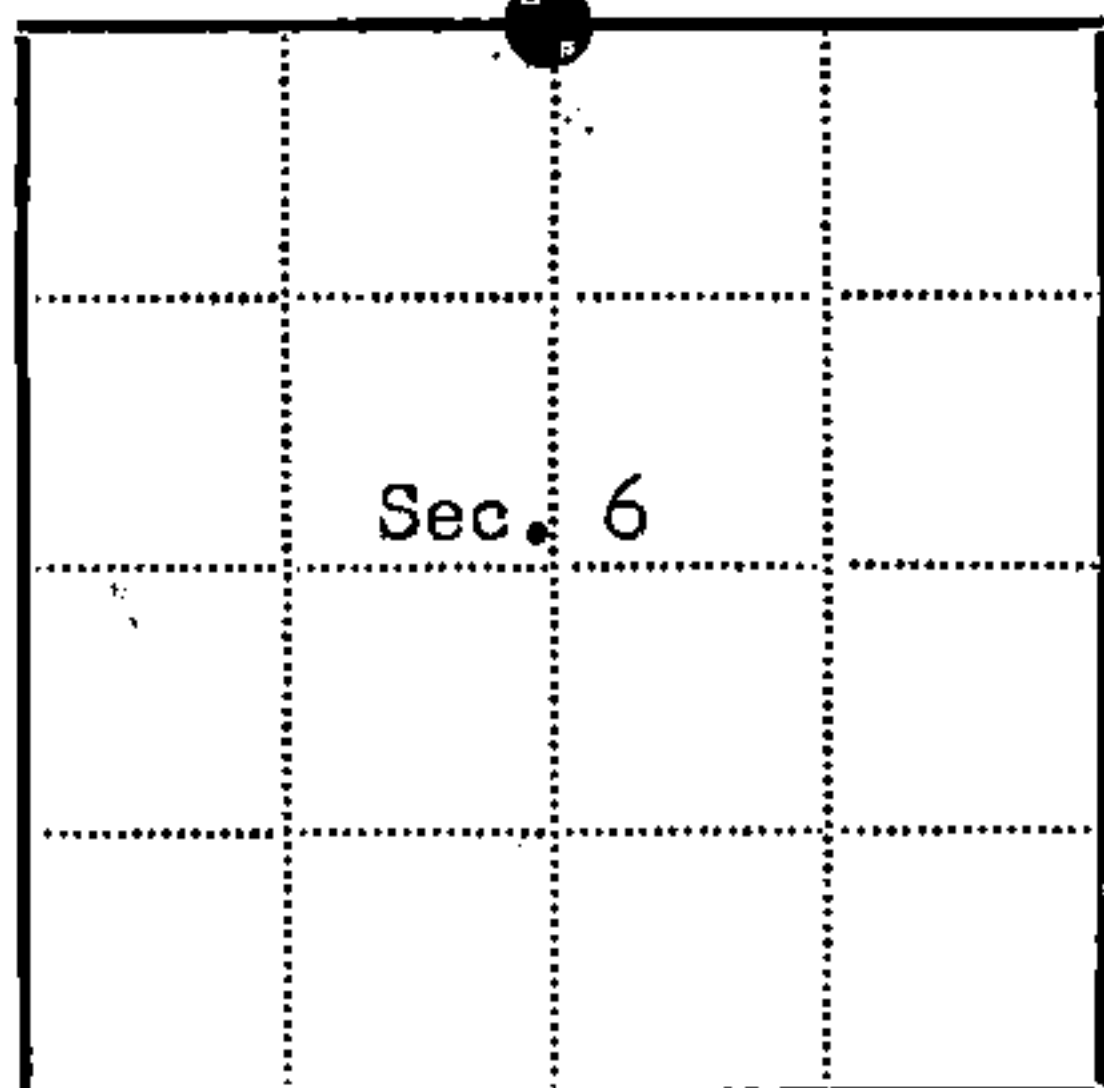

● = Corner monument restored
 □ =

Resident witnesses.....

Dated at Rhinelanders, Wisconsin, this 15th day of March, 1968.

Signature Jean F. Resvick Title Professional Surveyor
 (County Surveyor, Registered Land Surveyor, or other duly authorized official)

Surveyors Registration No. S-802
 DOCUMENT NO. 94347

Office of Register of Deeds County of Forest

I hereby certify that the within instrument was filed in this office for record on the 29th day of March, 1968, and was filed in Book No. I Page No. A-3 of County Records.

Signature Eugene Stetson Title Register of Deeds

Township 38 North, Range 12 East, Section 6, Index No. A-3, Page No. 3

4391231 0020



A
3