

CERTIFIED LAND CORNER RESTORATION


Index No. J-9

State of Wisconsin }
 County of Forest } ss.

I William B. Cochrane, do hereby certify that on the 25th day of April, 1994, I found evidence of the Northwest Section corner of Section 16 Township 39, North, Range 13 East, Fourth Principal Meridian, as described hereon; and that from this evidence I established a new monument and accessories as described hereon to perpetuate the original location of this corner.

Resident witnesses:

.....

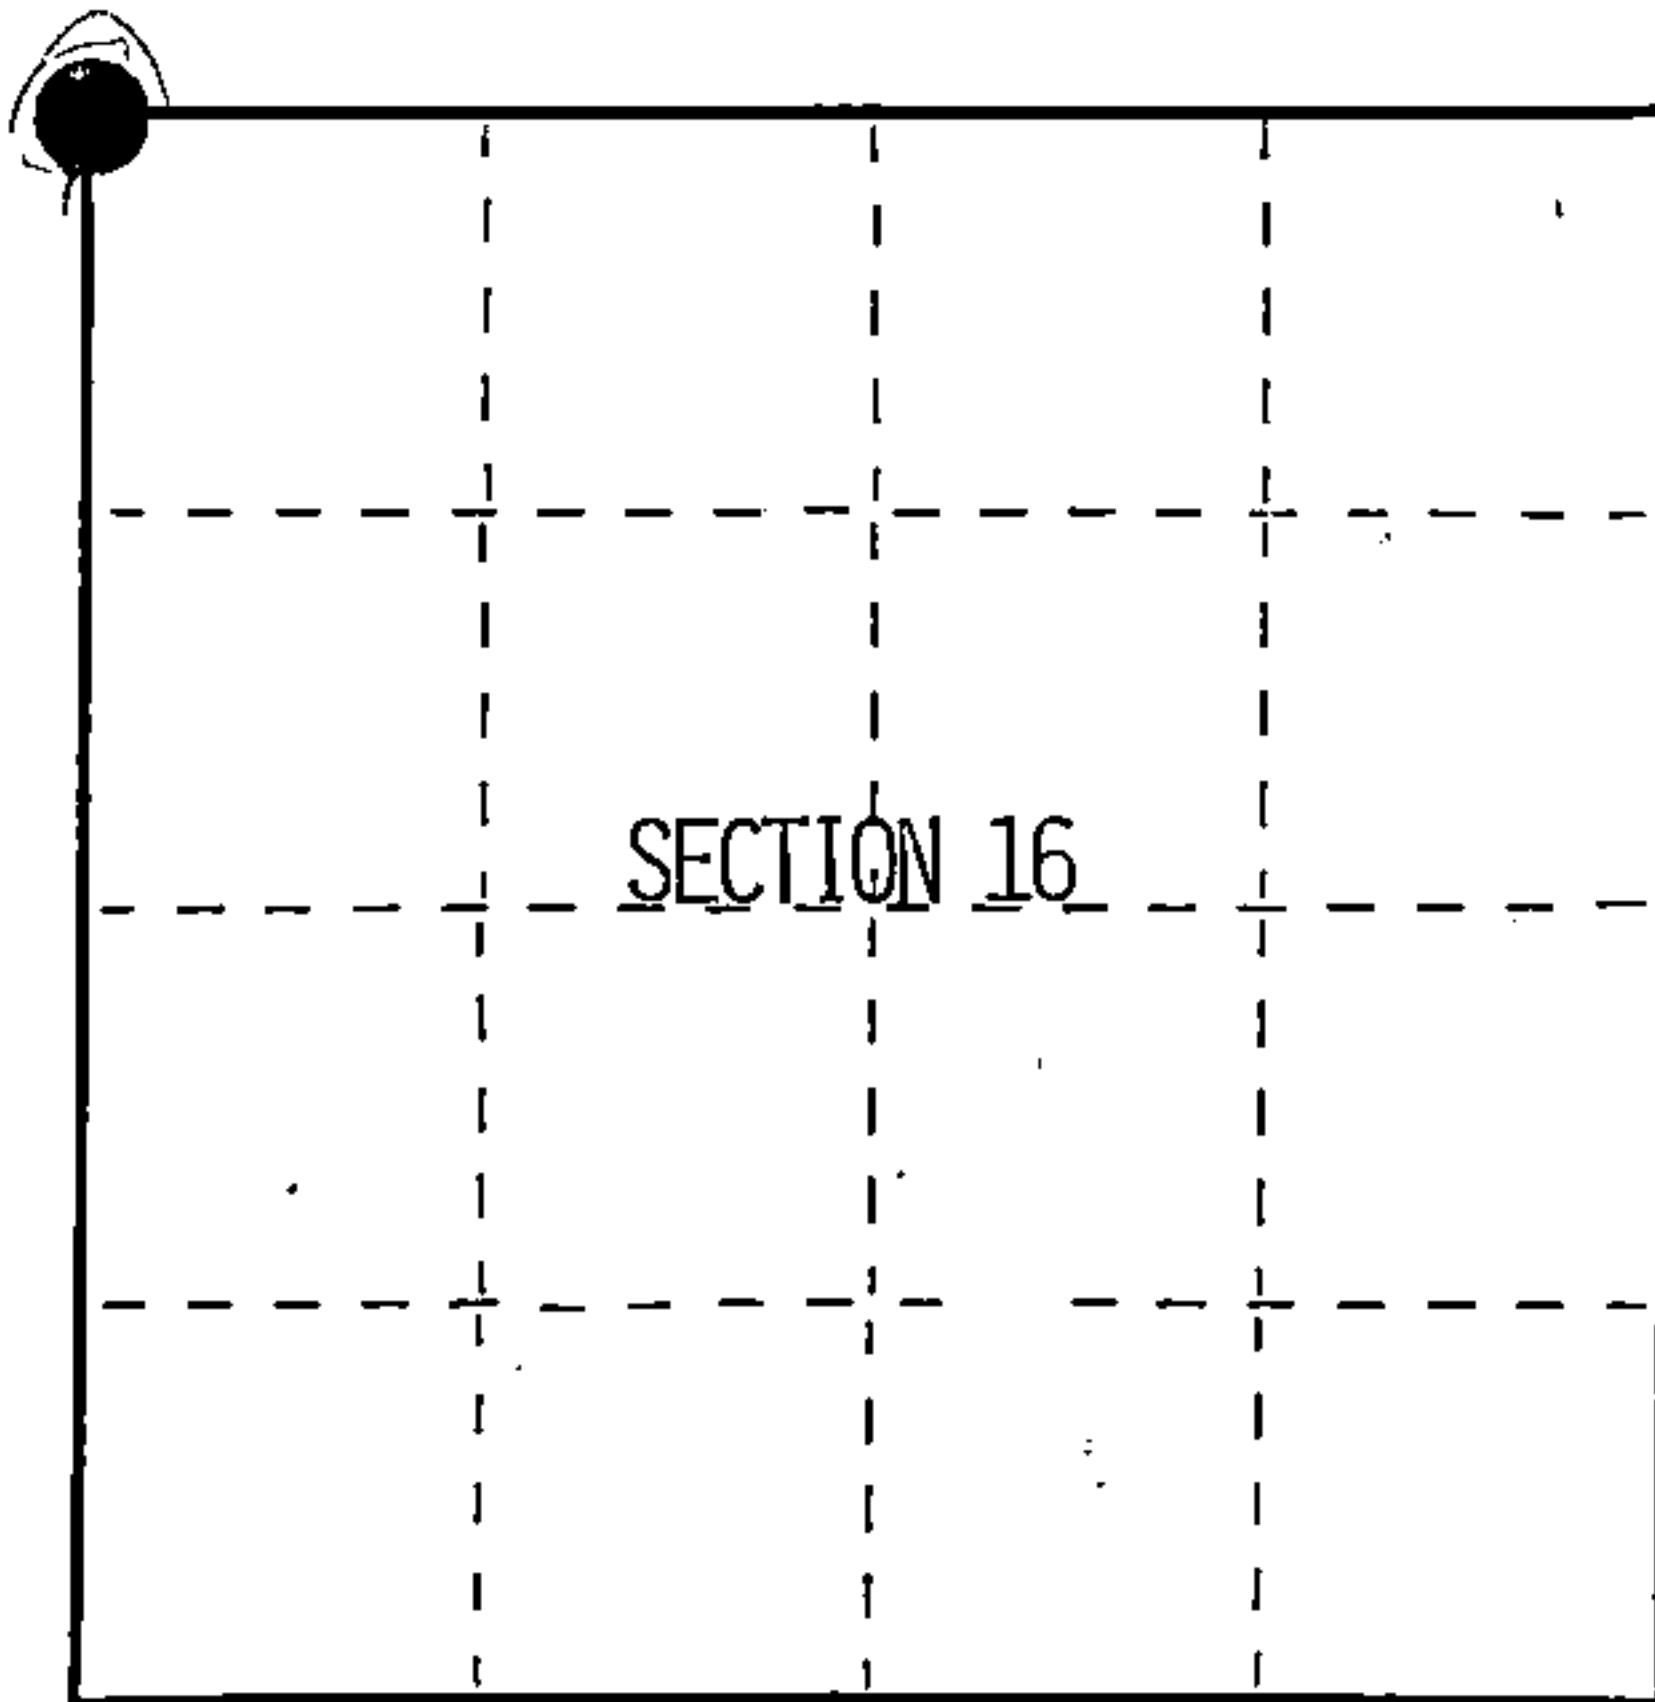

● = Corner monument restored.

History of original corner establishment:

Original Government survey in 1865 by William E. Daugherty. North between Sections 16 and 17. At 70 chains creek 15 lks runs SE. At 80 chains set Section post from which; W. Pine, 15" N33°E, 17lks, Birch 5" S68°E 25 lks.

In late 1930's the East Boundary Road, now Forest Road 2174 was surveyed by Forest Service personnel, They tied in the Corner post at that time. Referred as "Truck Trail Plans"

Description of corner evidence found:

No Original Corner evidence was found.

I restore the corner position using ties to the "Truck Trail Plans" for Forest Road #2174. which remains as surveyed in the late 1930'S.

Description of monument and accessories I established to perpetuate the original location of this corner.

At the corner positon, set a 2½" diameter aluminum pipe monument 3 feet long, 2½ feet in the ground, with an aluminum cap stamped: T39N, R13E, S8, S9, S16, S17, 1994, S-1107. From which the following bear:

Balsam	3"	N35°E	35.40'
Aspen	3"	S52°E	29.29'
Balsam	3"	S10°W	31.97'
Balsam	8"	N82°W	65.37'
Steel sign post		Northwest	0.75'

Dated at Hiles, Wis., this 7th day of December, 1994

Signature William B. Cochrane Title Land Surveyor Registration No. S-1107
 (County Surveyor, Registered Land Surveyor, or other duly authorized official)

Office of Register of Deeds, County of Forest, I hereby certify that the within instrument was filed in this office for record on the 23rd day of August, 1996 at 2:30 o'clock P. M.

(Register of Deeds)

By Paul Tombarico Deputy

FORM NO. 985-A



Stock No. 26273

156560

4391308000

